


LOCATION				FEET OF DITCHING				MISC. ITEMS			REMARKS	LOCATION				FEET OF DITCHING				MISC. ITEMS			REMARKS
SITE	STATION	STATION	POS.	PERCENT GRADE				STONE FILL TYP. I	GEOT. UNDER STONE FILL	TEMP. EROS. MATT.		SITE	STATION	STATION	POS.	PERCENT GRADE				TEMP. EROS. MATT.	STONE FILL TYP. I	GEOT. UNDER STONE FILL	
				0-1	1-2.5	2.5-10	>10									0-1	1-2.5	2.5-10	>10				
				613.10	649.31	653.20	653.20									613.10	649.31						
VT ROUTE 106, WEATHERSFIELD DISTRICT #2								CY	SY	SY									SY	CY	SY		
1	166+30 +63+63	168+32 +70+56	RT			201.5 690		31.68 +02	83.5 307														
	171+05	174+50	RT		345																		
	175+00	182+00	RT		700																		
	182+30	190+70	RT		840																		
	190+80	206+50	RT		1570																		
	220+50	222+80	RT		230																		
	184.50		LT		55 FT			13.24	30.6														
	217+35		LT		10 FT			2.41	7.2														
SHEET SUBTOTALS					3685	690		102	307	2456													
ROUNDING					15	10		3	3	44													
TOTALS THIS SHEET					3700	700		105	310	2500													

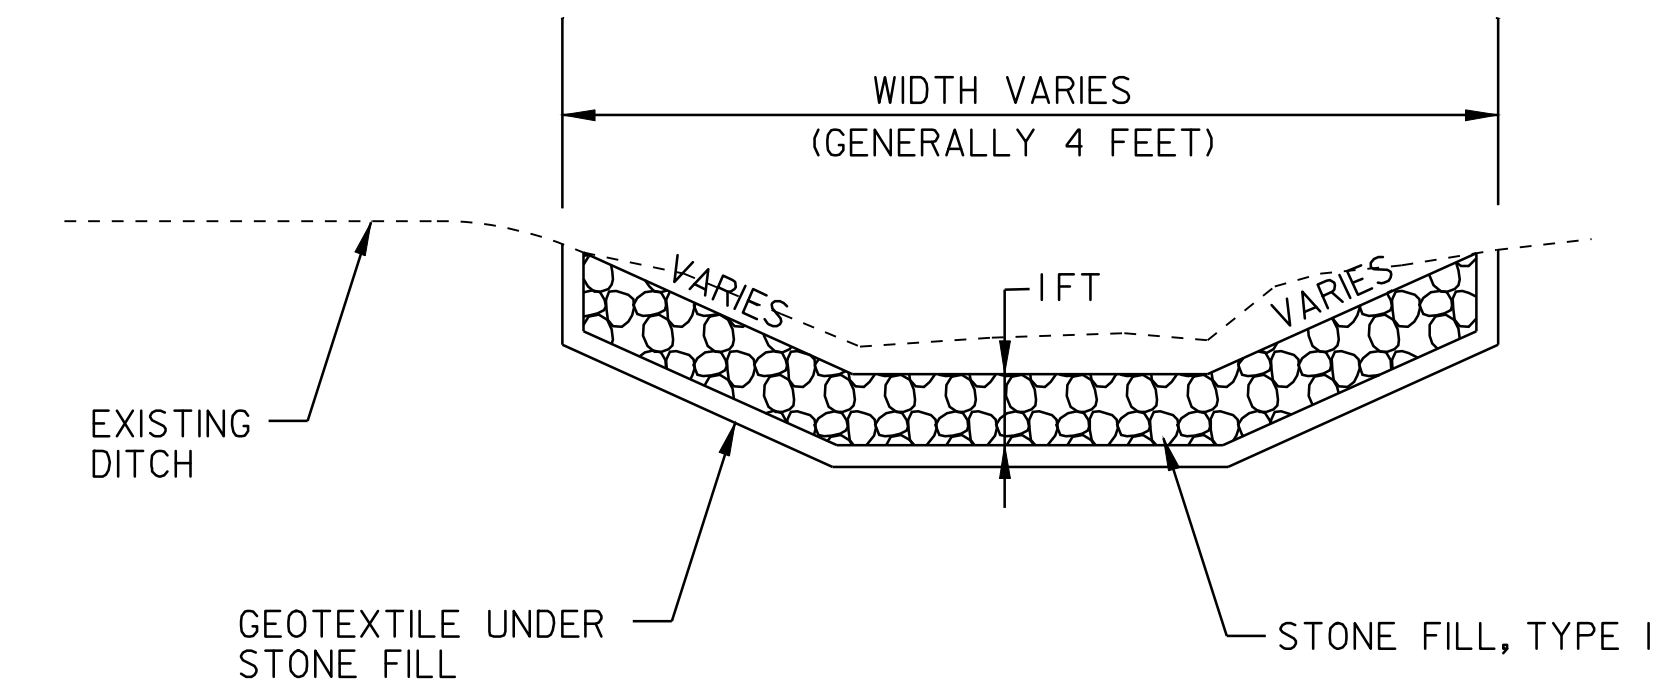

DITCH DETAIL
NOT TO SCALE

NOTES:

PIPE INLET AND OUTLET AREAS, AND DITCH CLEANING THROUGH PROJECT, SHALL BE PERFORMED AT LOCATIONS AS INDICATED ON THIS SHEET AND AS DIRECTED BY THE RESIDENT ENGINEER. PAYMENT WILL BE UNDER THE APPLICABLE EQUIPMENT RENTAL ITEM(S).

ESTIMATED QUANTITIES OF TEMPORARY EROSION MATTING, STONE FILL TYPE I, HAVE BEEN INCLUDED. DITCHES WITH A SLOPE LESS THAN 1 PERCENT SHALL BE SEEDDED. TEMPORARY EROSION MATTING SHALL BE USED IN ALL DITCHES WITH A GRADE BETWEEN 1 AND 2 1/2 PERCENT, AND STONE FILL, TYPE I SHALL BE USED IN ALL DITCHES WITH A GRADE BETWEEN 2 1/2 AND 10 PERCENT.

DITCH CLEANING DETAIL SHEET	PROJECT : WEATHERSFIELD	PROJECT NO. : STP 2711(I)
	DESIGN FILE NAME: p07cl64.dgn	PLOT DATE: 28-MAY-2010 13
	IPARM FILE NAME: p07cl64_10.i	SURVEY DATE: 11-08
	SURVEYED BY: JLR/LEW	DRAWN BY: JLR
	SQUAD LEADER: ERD	SHEET: 10 OF 21