

646.402 DURABLE 4" WHITE LINE, THERMOPLASTIC

STA. 129+00 ~ 130+40 --SOLID RT
 STA. 129+00 ~ 142+00 --SOLID LT
 STA. 130+58 ~ 142+00 --SOLID RT

646.602 TEMPORARY 4" WHITE LINE, PAINT

STA. 129+00 ~ 130+40 --SOLID RT
 STA. 129+00 ~ 142+00 --SOLID LT
 STA. 130+58 ~ 142+00 --SOLID RT

646.412 DURABLE 4" YELLOW LINE, THERMOPLASTIC

STA. 129+00 ~ 130+27 --SOLID LT & RT
 STA. 130+67 ~ 142+00 --SOLID LT & RT

646.612 TEMPORARY 4" YELLOW LINE, PAINT

STA. 129+00 ~ 130+27 --SOLID LT & RT
 STA. 130+67 ~ 142+00 --SOLID LT & RT

646.482 DURABLE 24" STOP BAR, THERMOPLASTIC

STA. 130+61 RT

646.682 TEMPORARY 24" STOP BAR, THERMOPLASTIC

STA. 130+61 RT

646.492 DURABLE LETTER OR SYMBOL, THERMOPLASTIC

STA. 130+61 RT

646.692 TEMPORARY LETTER OR SYMBOL, THERMOPLASTIC

STA. 130+61 RT

616.47 BITUMINOUS CONCRETE GUTTERS & TRAFFIC ISLANDS

STA. 129+00 ~ 131+20 LT
 STA. 129+00 ~ 129+50 RT

675.50 REMOVING SIGNS

AS SHOWN--4

675.60 ERECTING SALVAGED SIGNS

AS SHOWN--1

621.20 STEEL BEAM GUARDRAIL, GALVANIZED

STA. 131+58 RT ~ 140+58 RT



621.50 MANUFACTURED TERMINAL SECTION, FLARED

STA. 131+20 RT ~ 131+58 RT
 STA. 140+58 RT ~ 140+96 RT




621.80 REMOVAL & DISPOSAL OF GUARDRAIL

STA. 131+20 RT ~ 140+96 RT

NOT TO SCALE

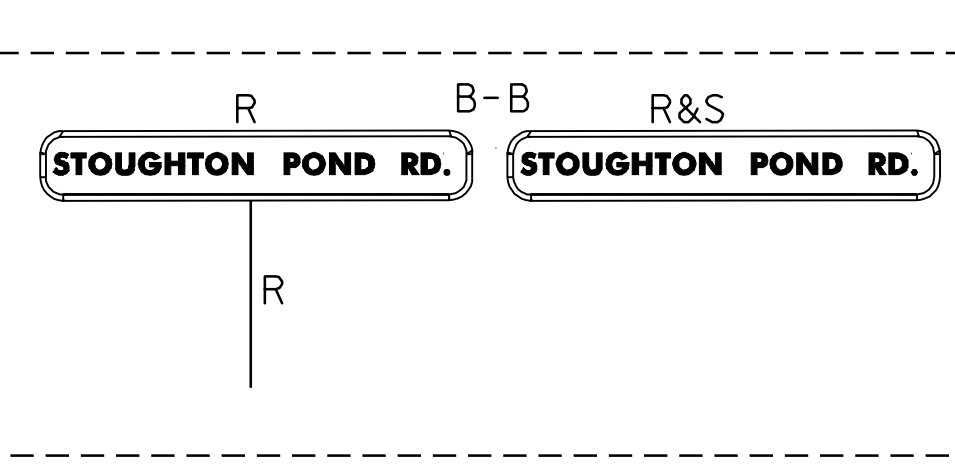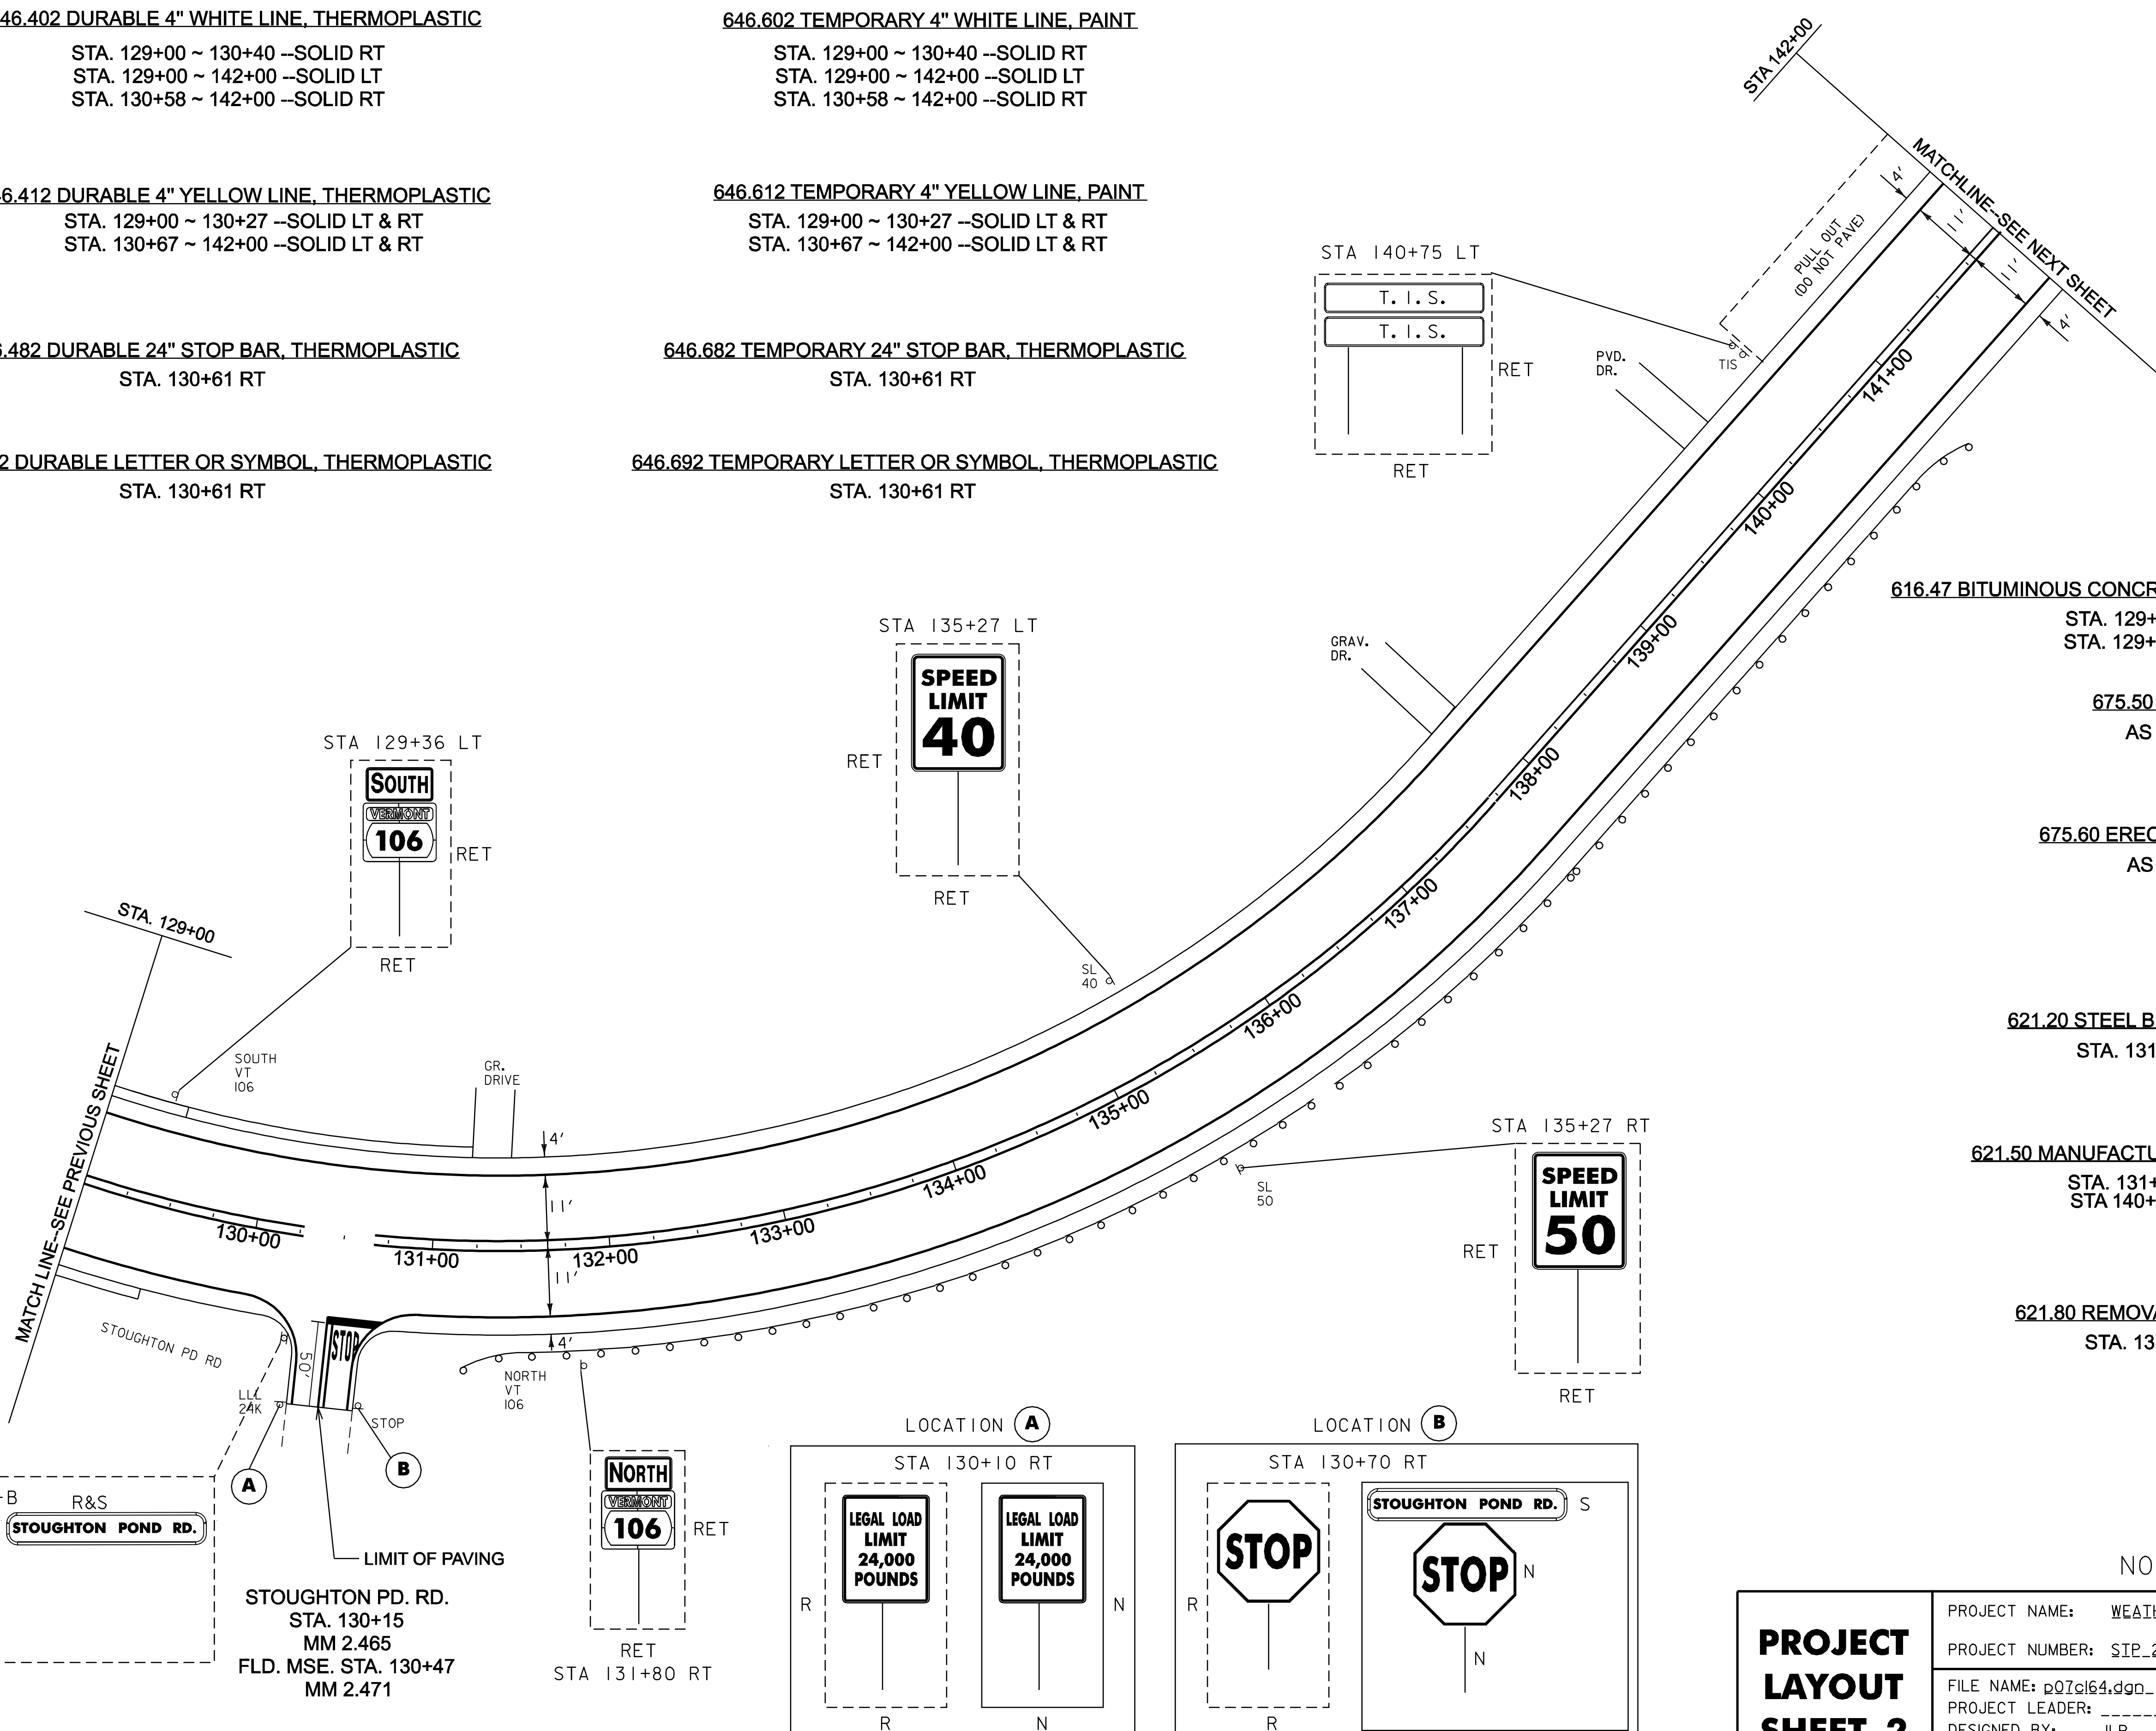

STOUGHTON PD. RD.
 STA. 130+15
 MM 2.465
 FLD. MSE. STA. 130+47
 MM 2.471

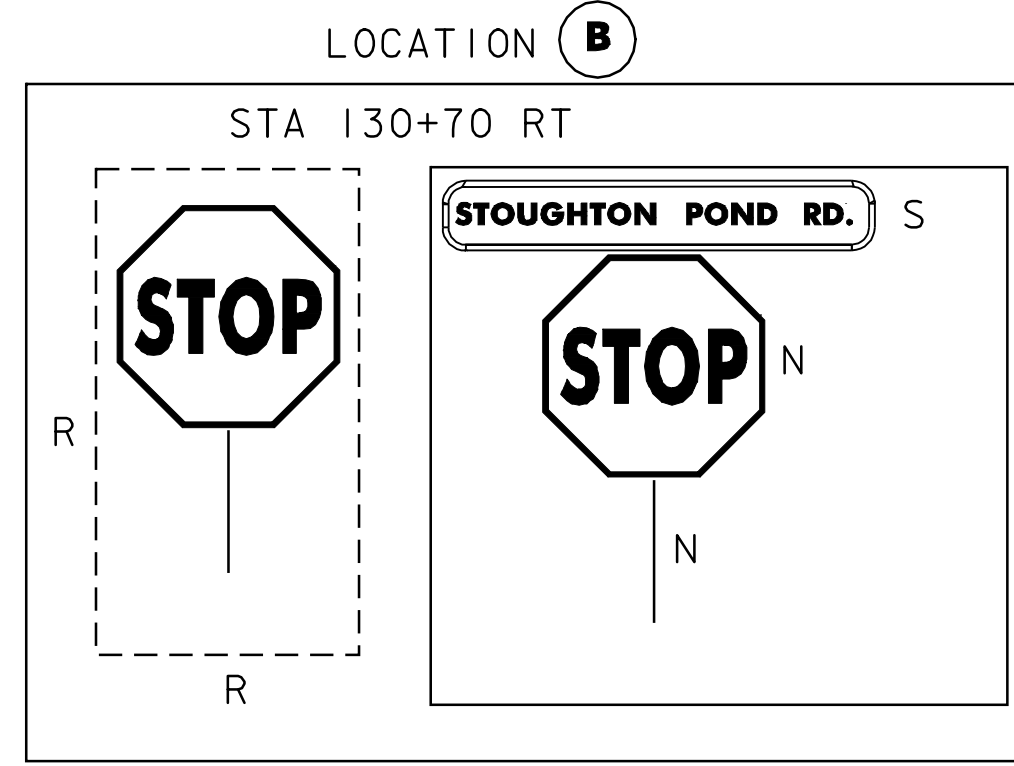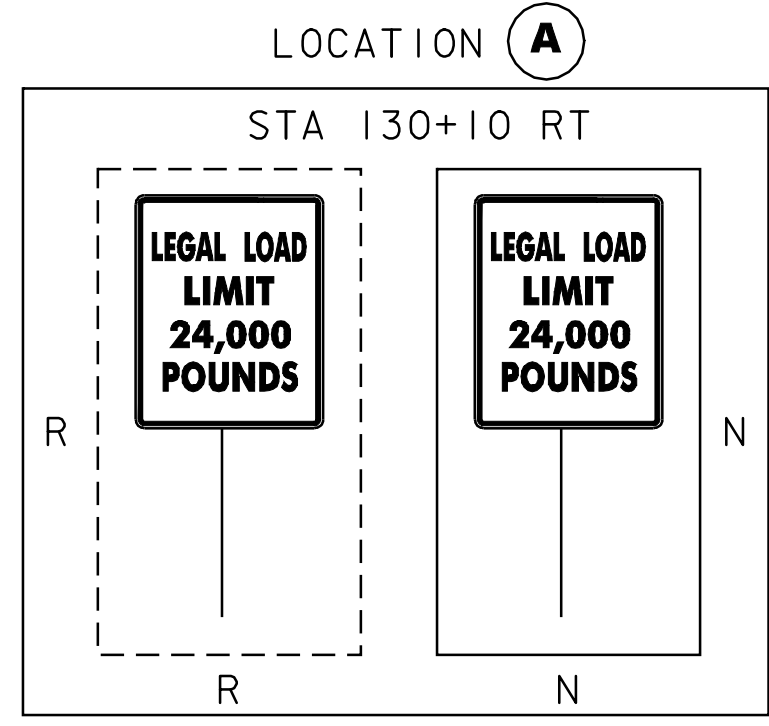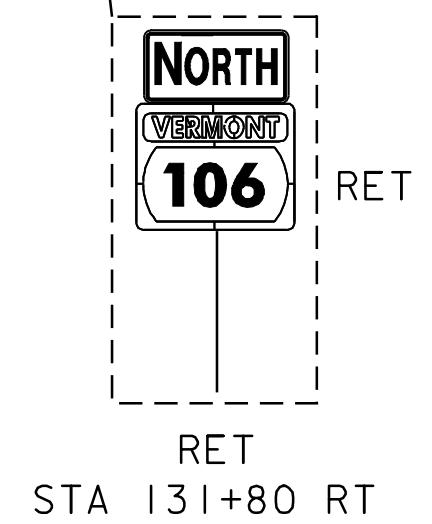

PROJECT LAYOUT SHEET 2

PROJECT NAME:	WEATHERSEIELD.....		
PROJECT NUMBER:	SIP_27(11).....		
FILE NAME:	p07c164.dgn.....	PLOT DATE:	28-MAY-2010 13:4
PROJECT LEADER:	DRAWN BY:	JLB.....
DESIGNED BY:	JLB.....	CHECKED BY:	JLB/LSW.....
	p07c164-12.1.....	SHEET	12 OF 21