

646.402 DURABLE 4" WHITE LINE, THERMOPLASTIC
STA. 142+00 ~ 154+00 --SOLID LT & RT

646.602 TEMPORARY 4" WHITE LINE, PAINT
STA. 142+00 ~ 154+00 --SOLID LT & RT


621.20 STEEL BEAM GUARDRAIL, GALVANIZED
STA. 143+57 LT ~ 144+32 LT

646.412 DURABLE 4" YELLOW LINE, THERMOPLASTIC
STA. 142+00 ~ 154+00 --SOLID LT & RT

646.612 TEMPORARY 4" YELLOW LINE, PAINT
STA. 142+00 ~ 154+00 --SOLID LT & RT

621.50 MANUFACTURED TERMINAL SECTION, FLARED
STA. 143+19 LT ~ 143+57 LT
STA. 144+32 LT ~ 144+70 LT

621.80 REMOVAL & DISPOSAL OF GUARDRAIL
STA. 143+57 LT ~ 144+32 LT

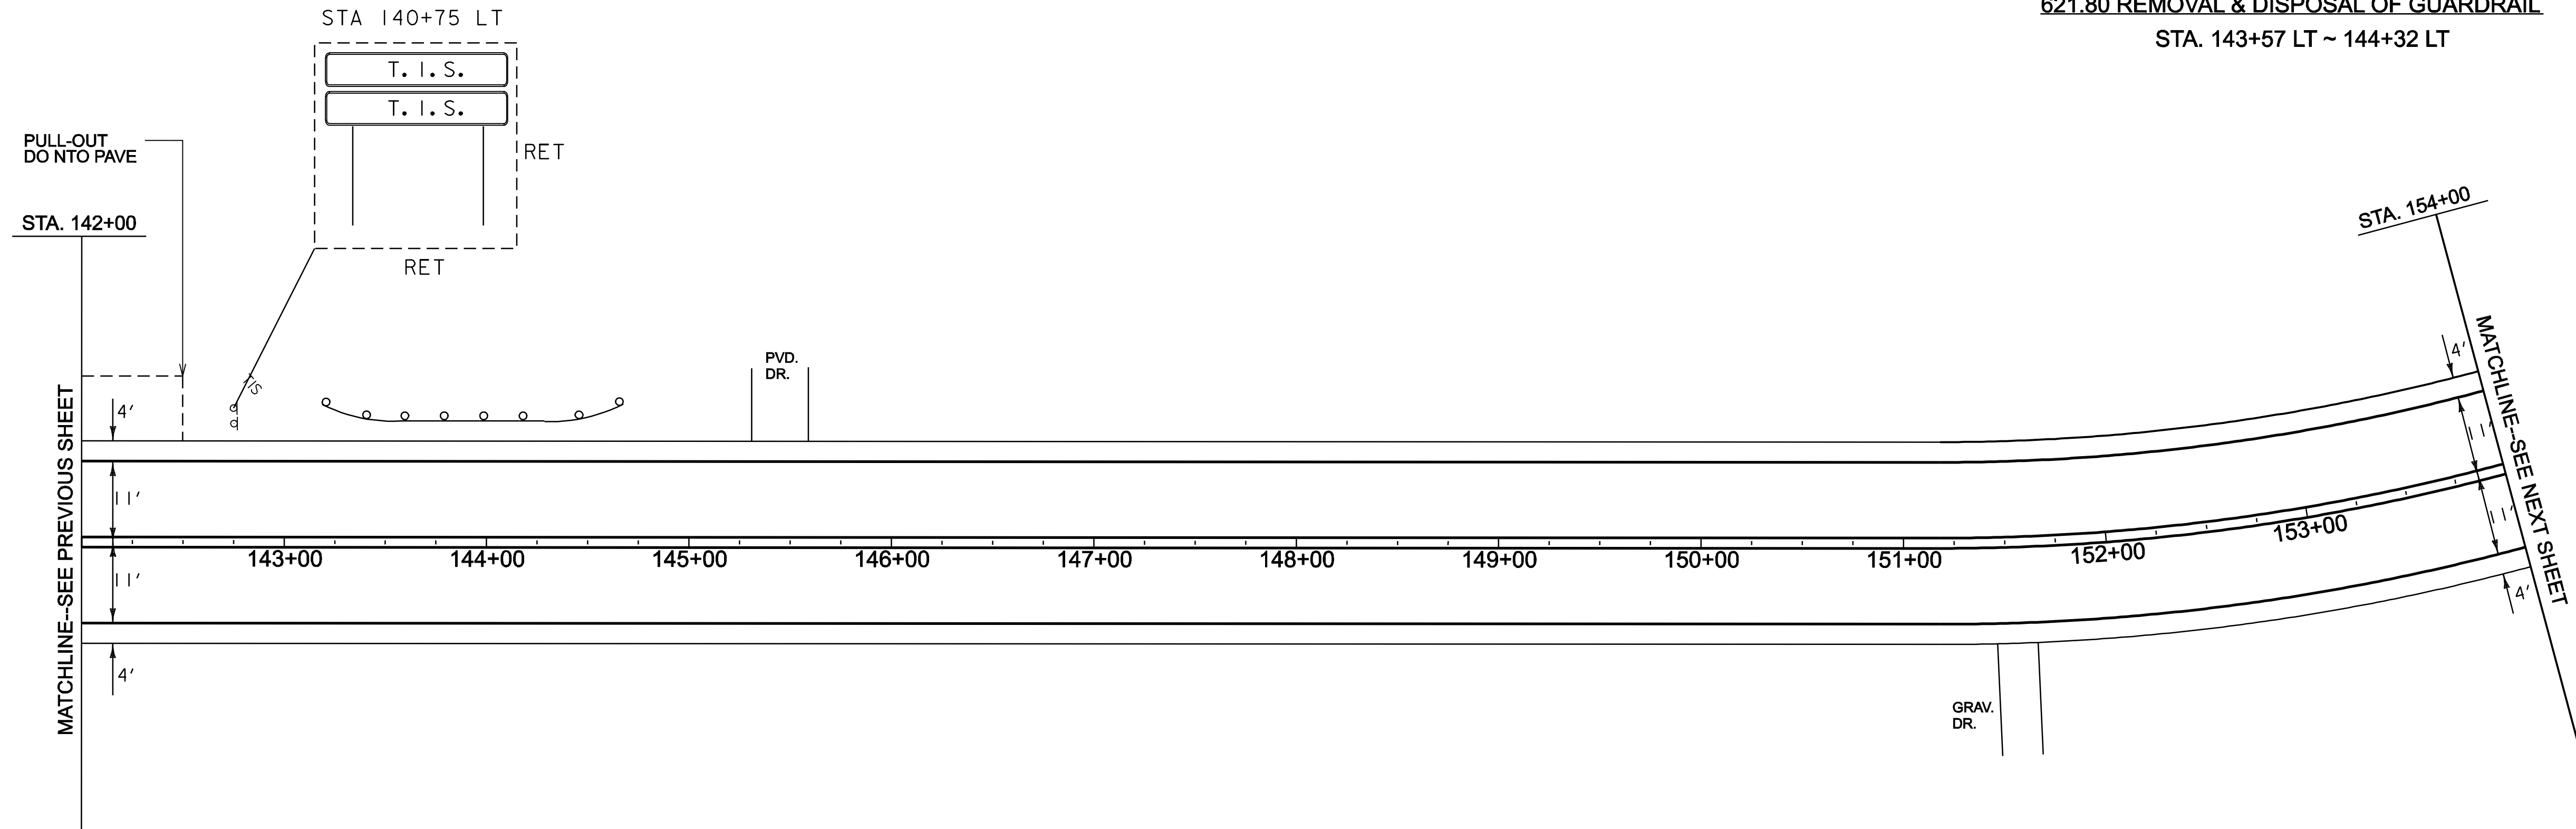

NOT TO SCALE

PROJECT LAYOUT SHEET 3	PROJECT NAME: WEATHERSEIELD.....	
	PROJECT NUMBER: SIP_27111).....	
	FILE NAME: p07c164.dgn.....	PLOT DATE: 28-MAY-2010 13:4
	PROJECT LEADER: ERD.....	DRAWN BY: JLB.....
	DESIGNED BY: JLB.....	CHECKED BY: JLB/LSW.....
	p07c164-13.i.....	SHEET 13 OF 21.....