


646.402 DURABLE 4" WHITE LINE, THERMOPLASTIC  
STA. 154+00 ~ 166+00 --SOLID LT & RT

646.602 TEMPORARY 4" WHITE LINE, PAINT  
STA. 154+00 ~ 166+00 --SOLID LT & RT

646.412 DURABLE 4" YELLOW LINE, THERMOPLASTIC  
STA. 154+00 ~ 166+00 --SOLID LT & RT

646.612 TEMPORARY 4" YELLOW LINE, PAINT  
STA. 154+00 ~ 166+00 --SOLID LT & RT

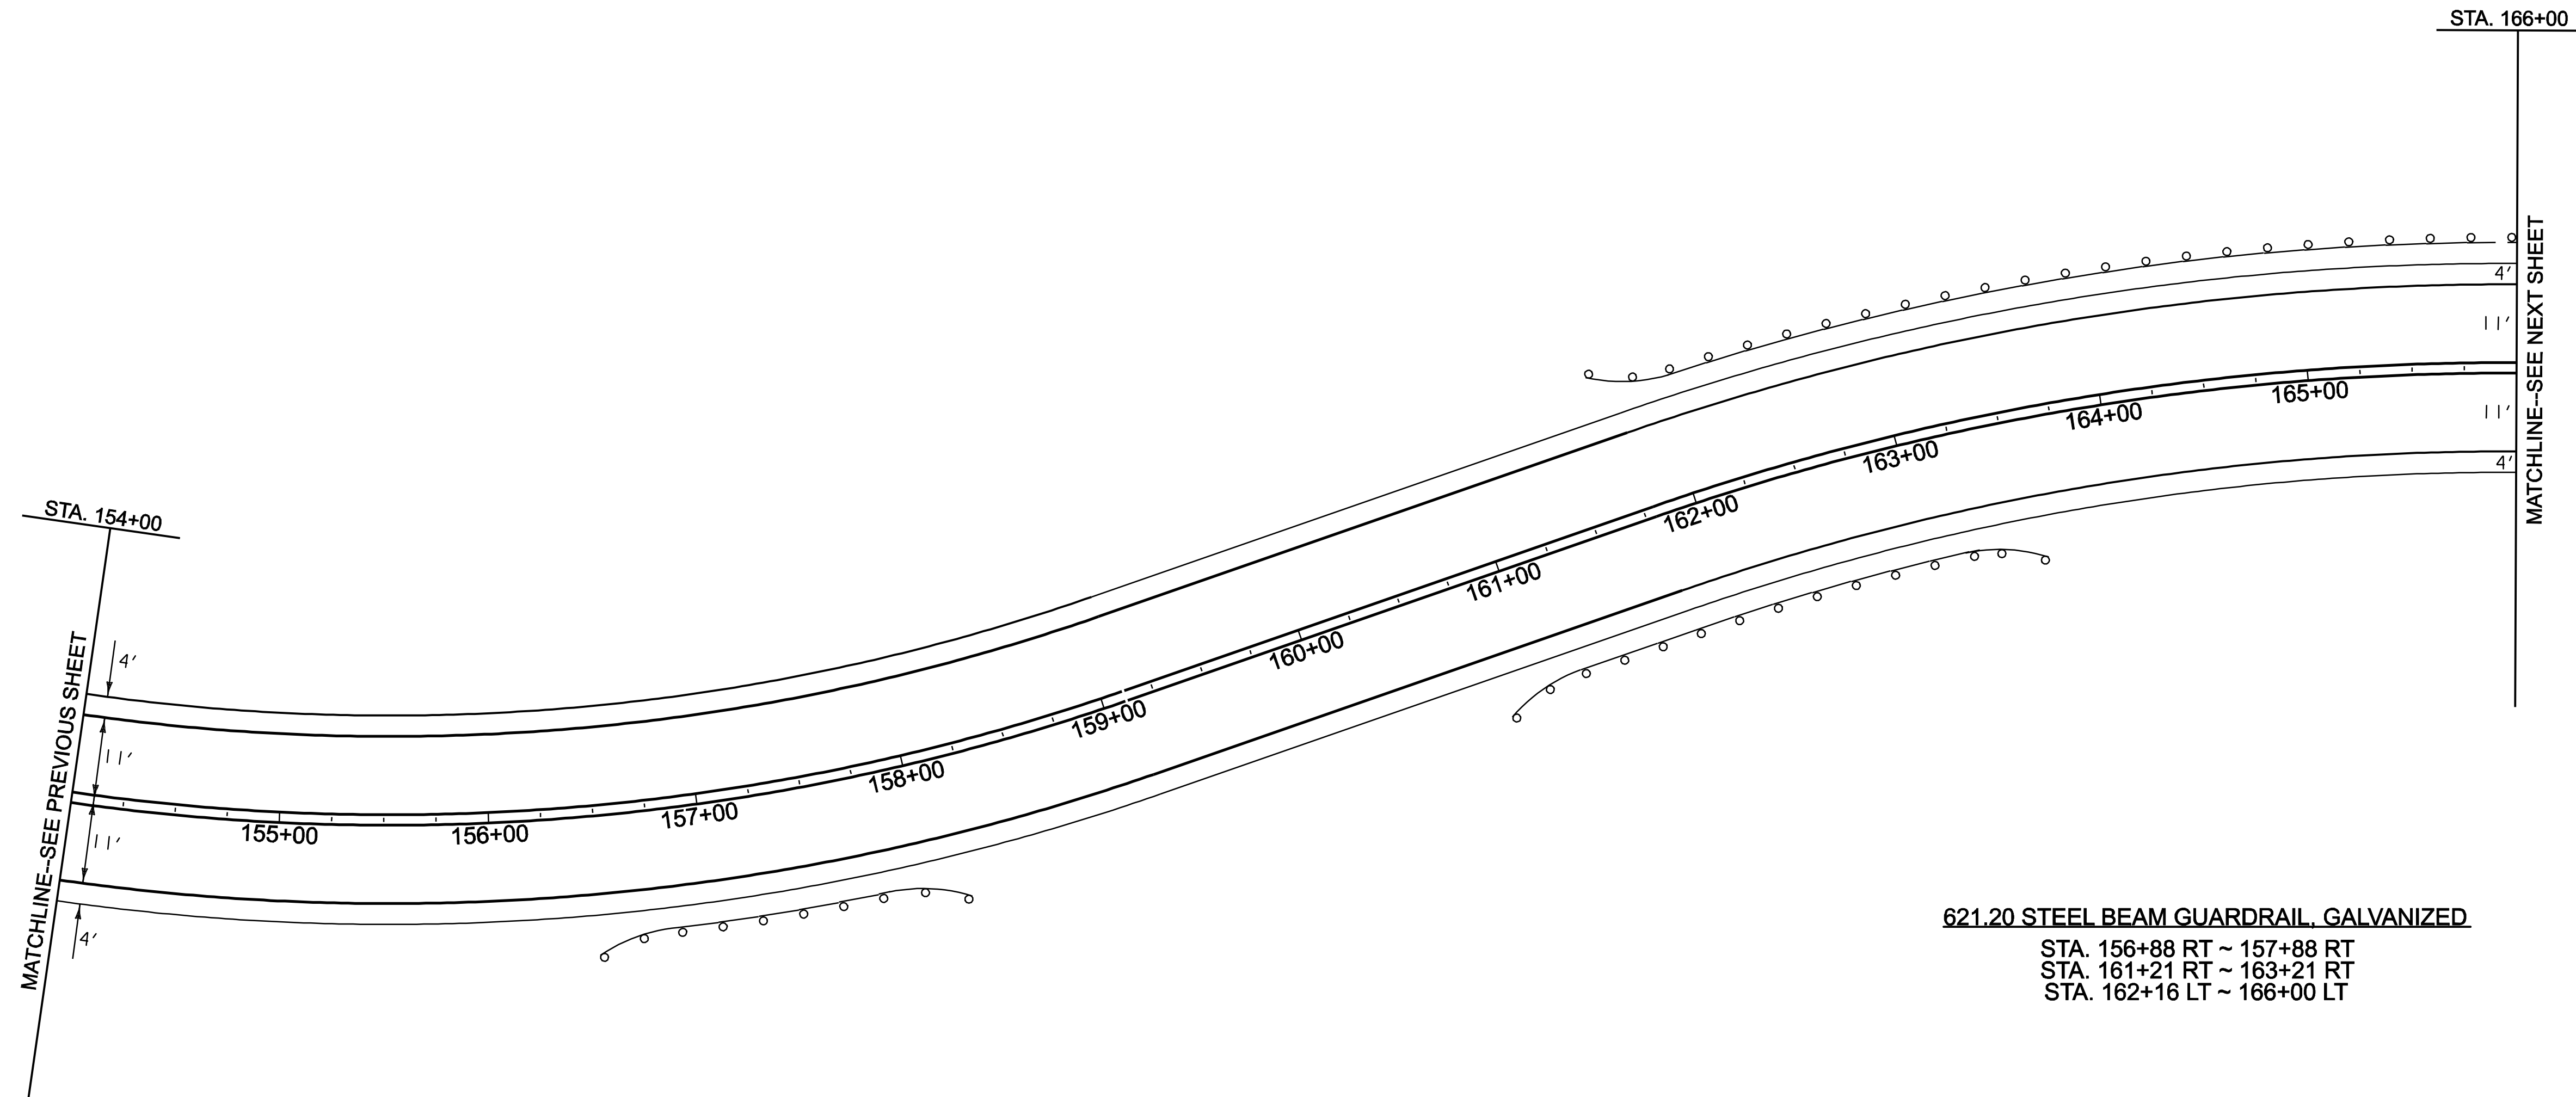

**621.20 STEEL BEAM GUARDRAIL, GALVANIZED**  
STA. 156+88 RT ~ 157+88 RT  
STA. 161+21 RT ~ 163+21 RT  
STA. 162+16 LT ~ 166+00 LT

**621.50 MANUFACTURED TERMINAL SECTION, FLARED**  
STA. 156+50 ~ 156+88 RT  
STA. 157+88 ~ 158+26 RT  
STA. 160+83 ~ 161+21 RT  
STA. 161+78 ~ 162+16 LT  
STA. 163+21 ~ 163+59 RT

**621.80 REMOVAL & DISPOSAL OF GUARDRAIL**  
STA. 156+50 RT ~ 158+26 RT  
STA. 160+83 RT ~ 163+58 RT  
STA. 161+78 LT ~ 166+00 LT

NOT TO SCALE

<b>PROJECT LAYOUT SHEET 4</b>	PROJECT NAME: WEATHERSEIELD.....	
	PROJECT NUMBER: SIP_27(11).....	
	FILE NAME: p07c164.dgn.....	PLOT DATE: 28-MAY-2010 13:4
	PROJECT LEADER: ERD.....	DRAWN BY: JLB.....
	DESIGNED BY: JLB.....	CHECKED BY: JLB/LSW.....
	p07c164-14.i.....	SHEET 14 OF 21.....