

646.402 DURABLE 4" WHITE LINE, THERMOPLASTIC  
STA. 166+00 ~ 178+00 --SOLID LT & RT

646.602 TEMPORARY 4" WHITE LINE, PAINT  
STA. 166+00 ~ 178+00 --SOLID LT & RT


621.20 STEEL BEAM GUARDRAIL, GALVANIZED  
STA. 166+00 LT ~ 169+41 LT  
STA. 176+10 LT ~ 178+00 LT

646.412 DURABLE 4" YELLOW LINE, THERMOPLASTIC  
STA. 166+00 ~ 178+00 --SOLID LT & RT

646.612 TEMPORARY 4" YELLOW LINE, PAINT  
STA. 166+00 ~ 178+00 --SOLID LT & RT

621.50 MANUFACTURED TERMINAL SECTION, FLARED  
STA. 169+41 LT ~ 169+79 LT  
STA. 175+72 LT ~ 176+10 LT

621.80 REMOVAL & DISPOSAL OF GUARDRAIL  
STA. 166+00 LT ~ 169+79 LT  
STA. 175+72 LT ~ 178+00 LT

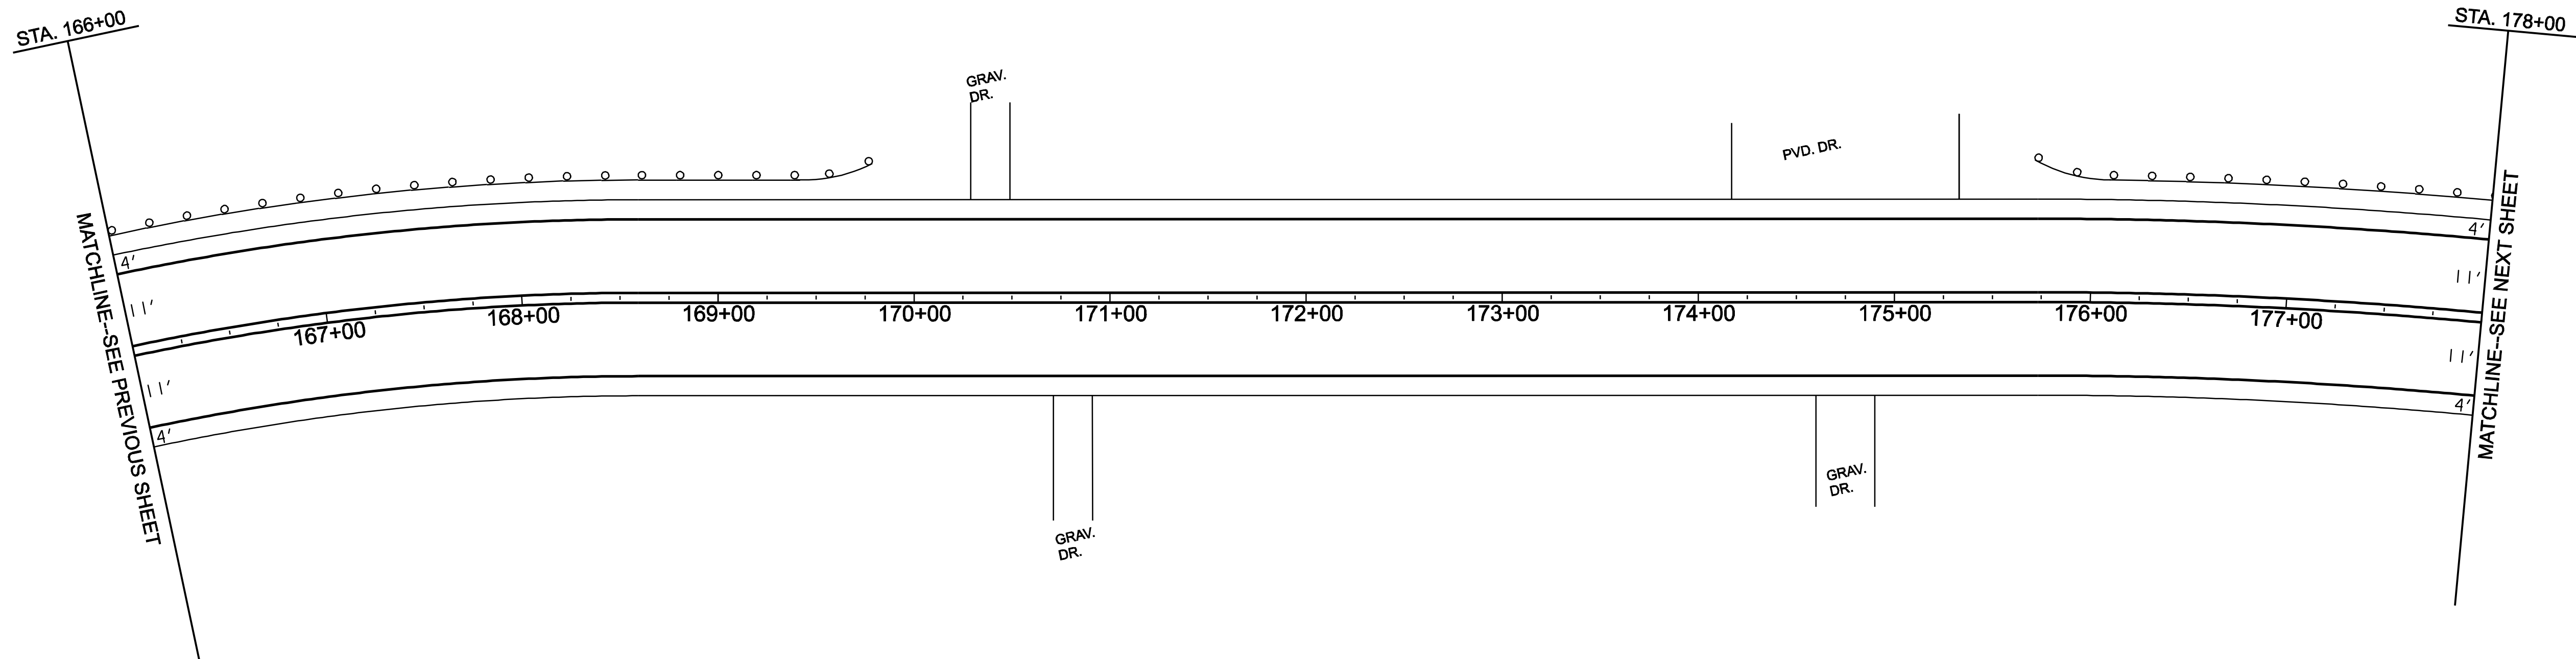

NOT TO SCALE

<b>PROJECT LAYOUT SHEET 5</b>	PROJECT NAME: WEATHERSEIELD.....	
	PROJECT NUMBER: SIP_27111).....	
	FILE NAME: p07c164.dgn.....	PLOT DATE: 28-MAY-2010 13:4
	PROJECT LEADER: ERD.....	DRAWN BY: JLB.....
	DESIGNED BY: JLB.....	CHECKED BY: JLB/LSW.....
	p07c164-15.i.....	SHEET 75 OF 21.....