

646.402 DURABLE 4" WHITE LINE, THERMOPLASTIC
STA. 203+00 ~ 216+00 --SOLID LT & RT

646.602 TEMPORARY 4" WHITE LINE, PAINT
STA. 203+00 ~ 216+00 --SOLID LT & RT

621.20 STEEL BEAM GUARDRAIL, GALVANIZED
STA 203+00 LT ~ 205+64 LT
STA. 208+31 LT ~ 211+43 LT


646.412 DURABLE 4" YELLOW LINE, THERMOPLASTIC
STA. 203+00 ~ 216+00 --SOLID LT & RT

646.612 TEMPORARY 4" YELLOW LINE, PAINT
STA. 203+00 ~ 216+00 --SOLID LT & RT

621.50 MANUFACTURED TERMINAL SECTION, FLARED
STA. 205+64 LT ~ 206+02 LT
STA. 207+93 LT ~ 208+31 LT
STA. 211+43 LT ~ 211+81 LT

613.11 STONE FILL, TYPE II
STA. 203+25 ~ 204+60 LT

621.80 REMOVAL & DISPOSAL OF GUARDRAIL
STA. 203+00 LT ~ 206+02 LT
STA. 207+93 LT ~ 211+81 LT

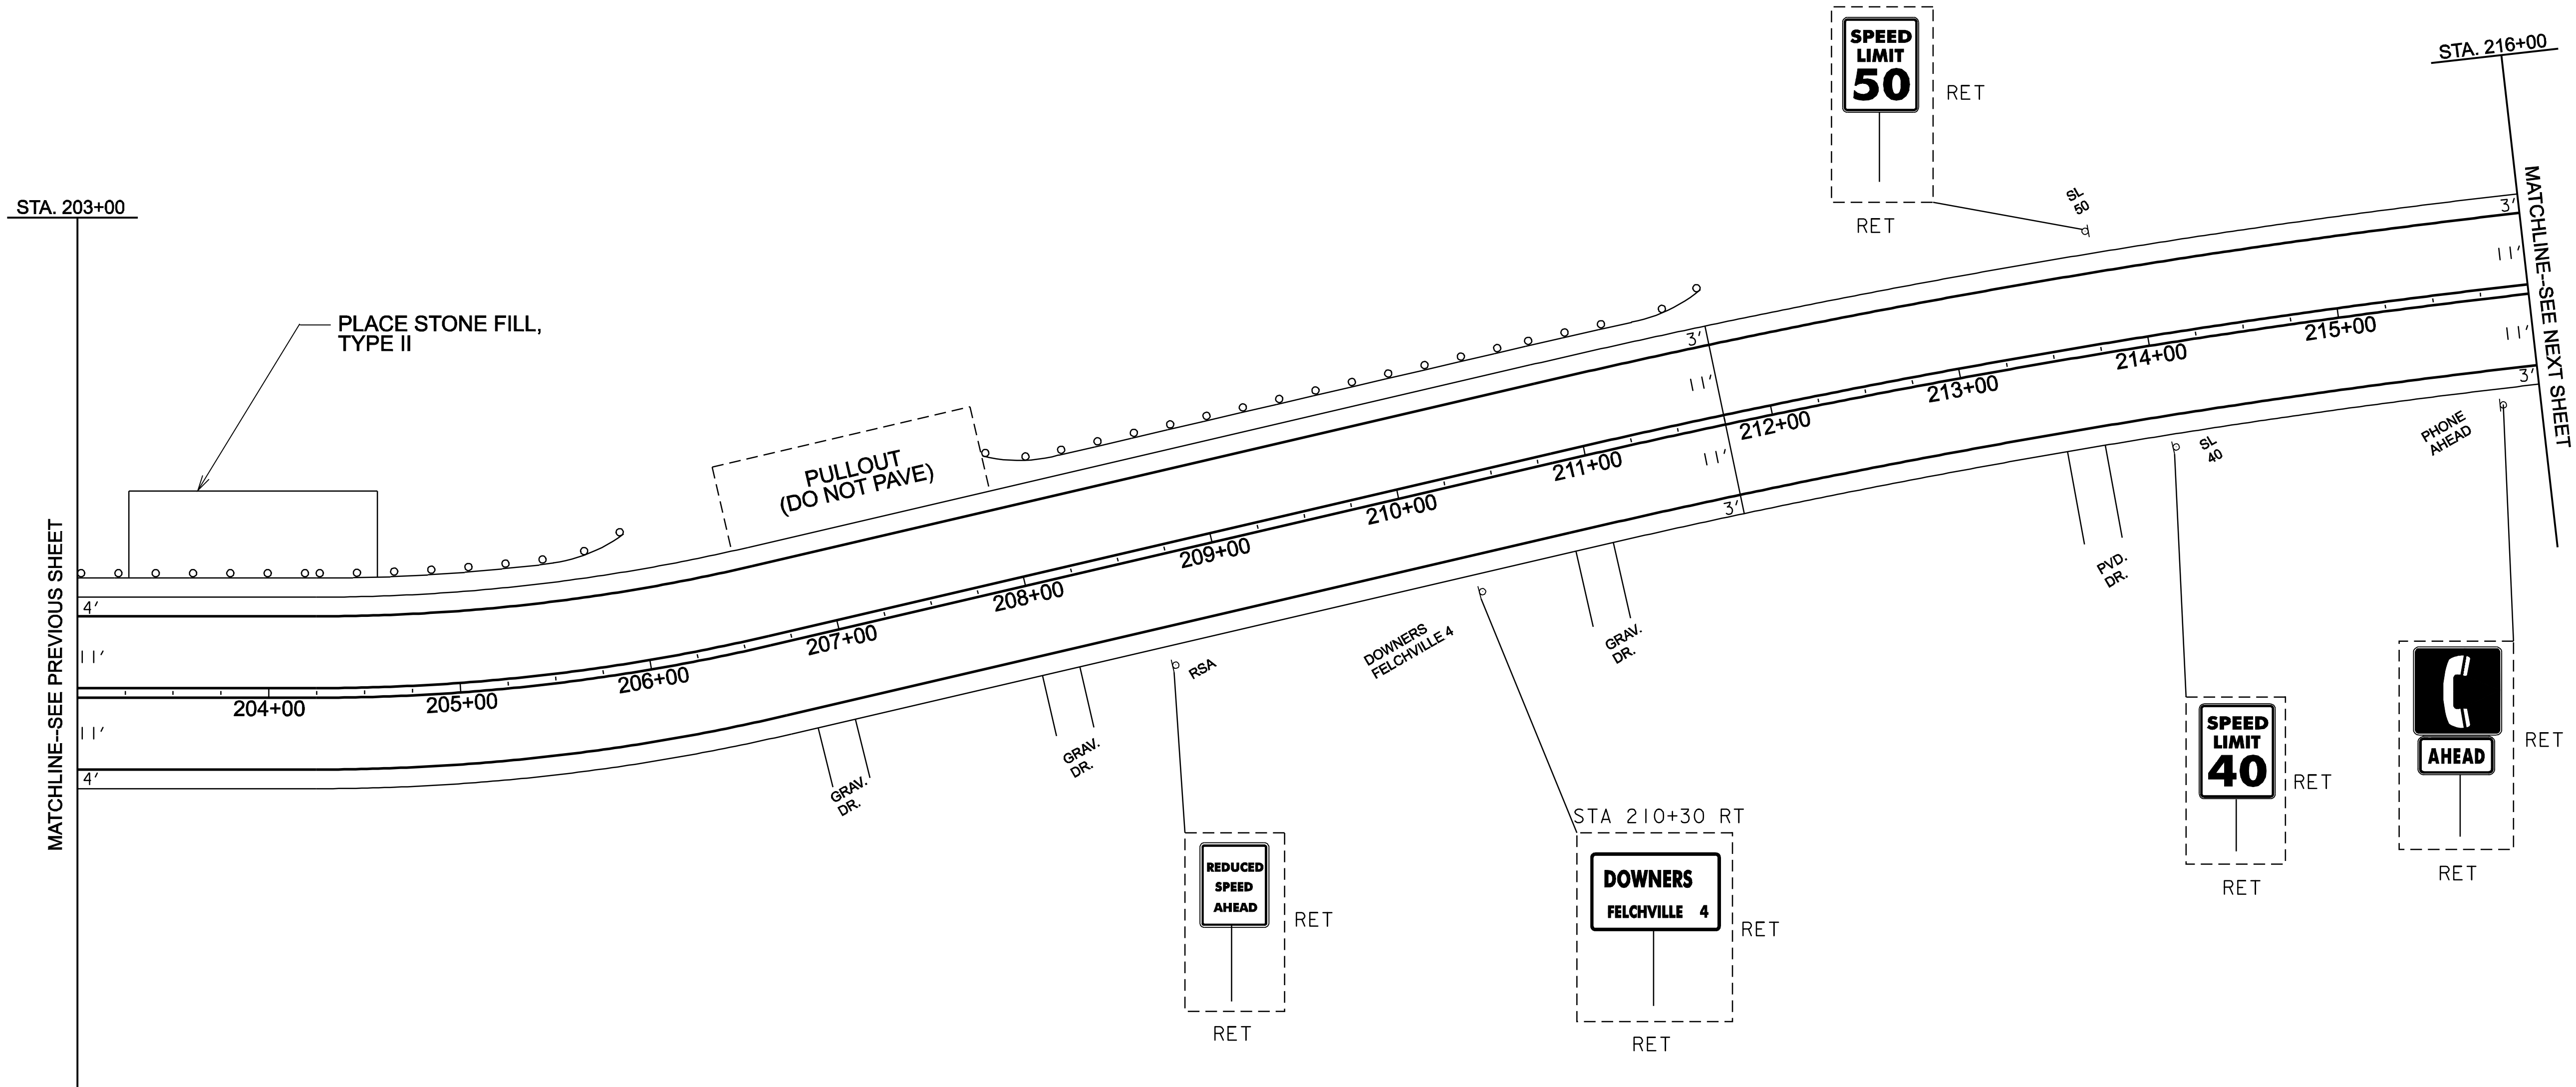

NOT TO SCALE

PROJECT LAYOUT SHEET 8	PROJECT NAME: WEATHERSEIELD.....	
	PROJECT NUMBER: SIP_27(II).....	
	FILE NAME: p07c164.dgn.....	PLOT DATE: 28-MAY-2010 13:4
	PROJECT LEADER: ERD.....	DRAWN BY: JLB.....
	DESIGNED BY: JLB.....	CHECKED BY: JLB/LSW.....
	p07c164-18.i.....	SHEET 18 OF 21.....