

646.402 DURABLE 4" WHITE LINE, THERMOPLASTIC
 STA. 216+00 ~ 226+25 --SOLID LT & RT


646.602 TEMPORARY 4" WHITE LINE, PAINT
 STA. 216+00 ~ 226+25 --SOLID LT & RT

604.412 REHAB DROP INLETS, CATCH BASINS, OR MANHOLES, CLASS 1
 STA. 217+32 RT

646.412 DURABLE 4" YELLOW LINE, THERMOPLASTIC
 STA. 216+00 ~ 226+25 --SOLID LT & RT

646.612 TEMPORARY 4" YELLOW LINE, PAINT
 STA. 216+00 ~ 226+25 --SOLID LT & RT

END PROJECT
STA 226+25
MM 4.285

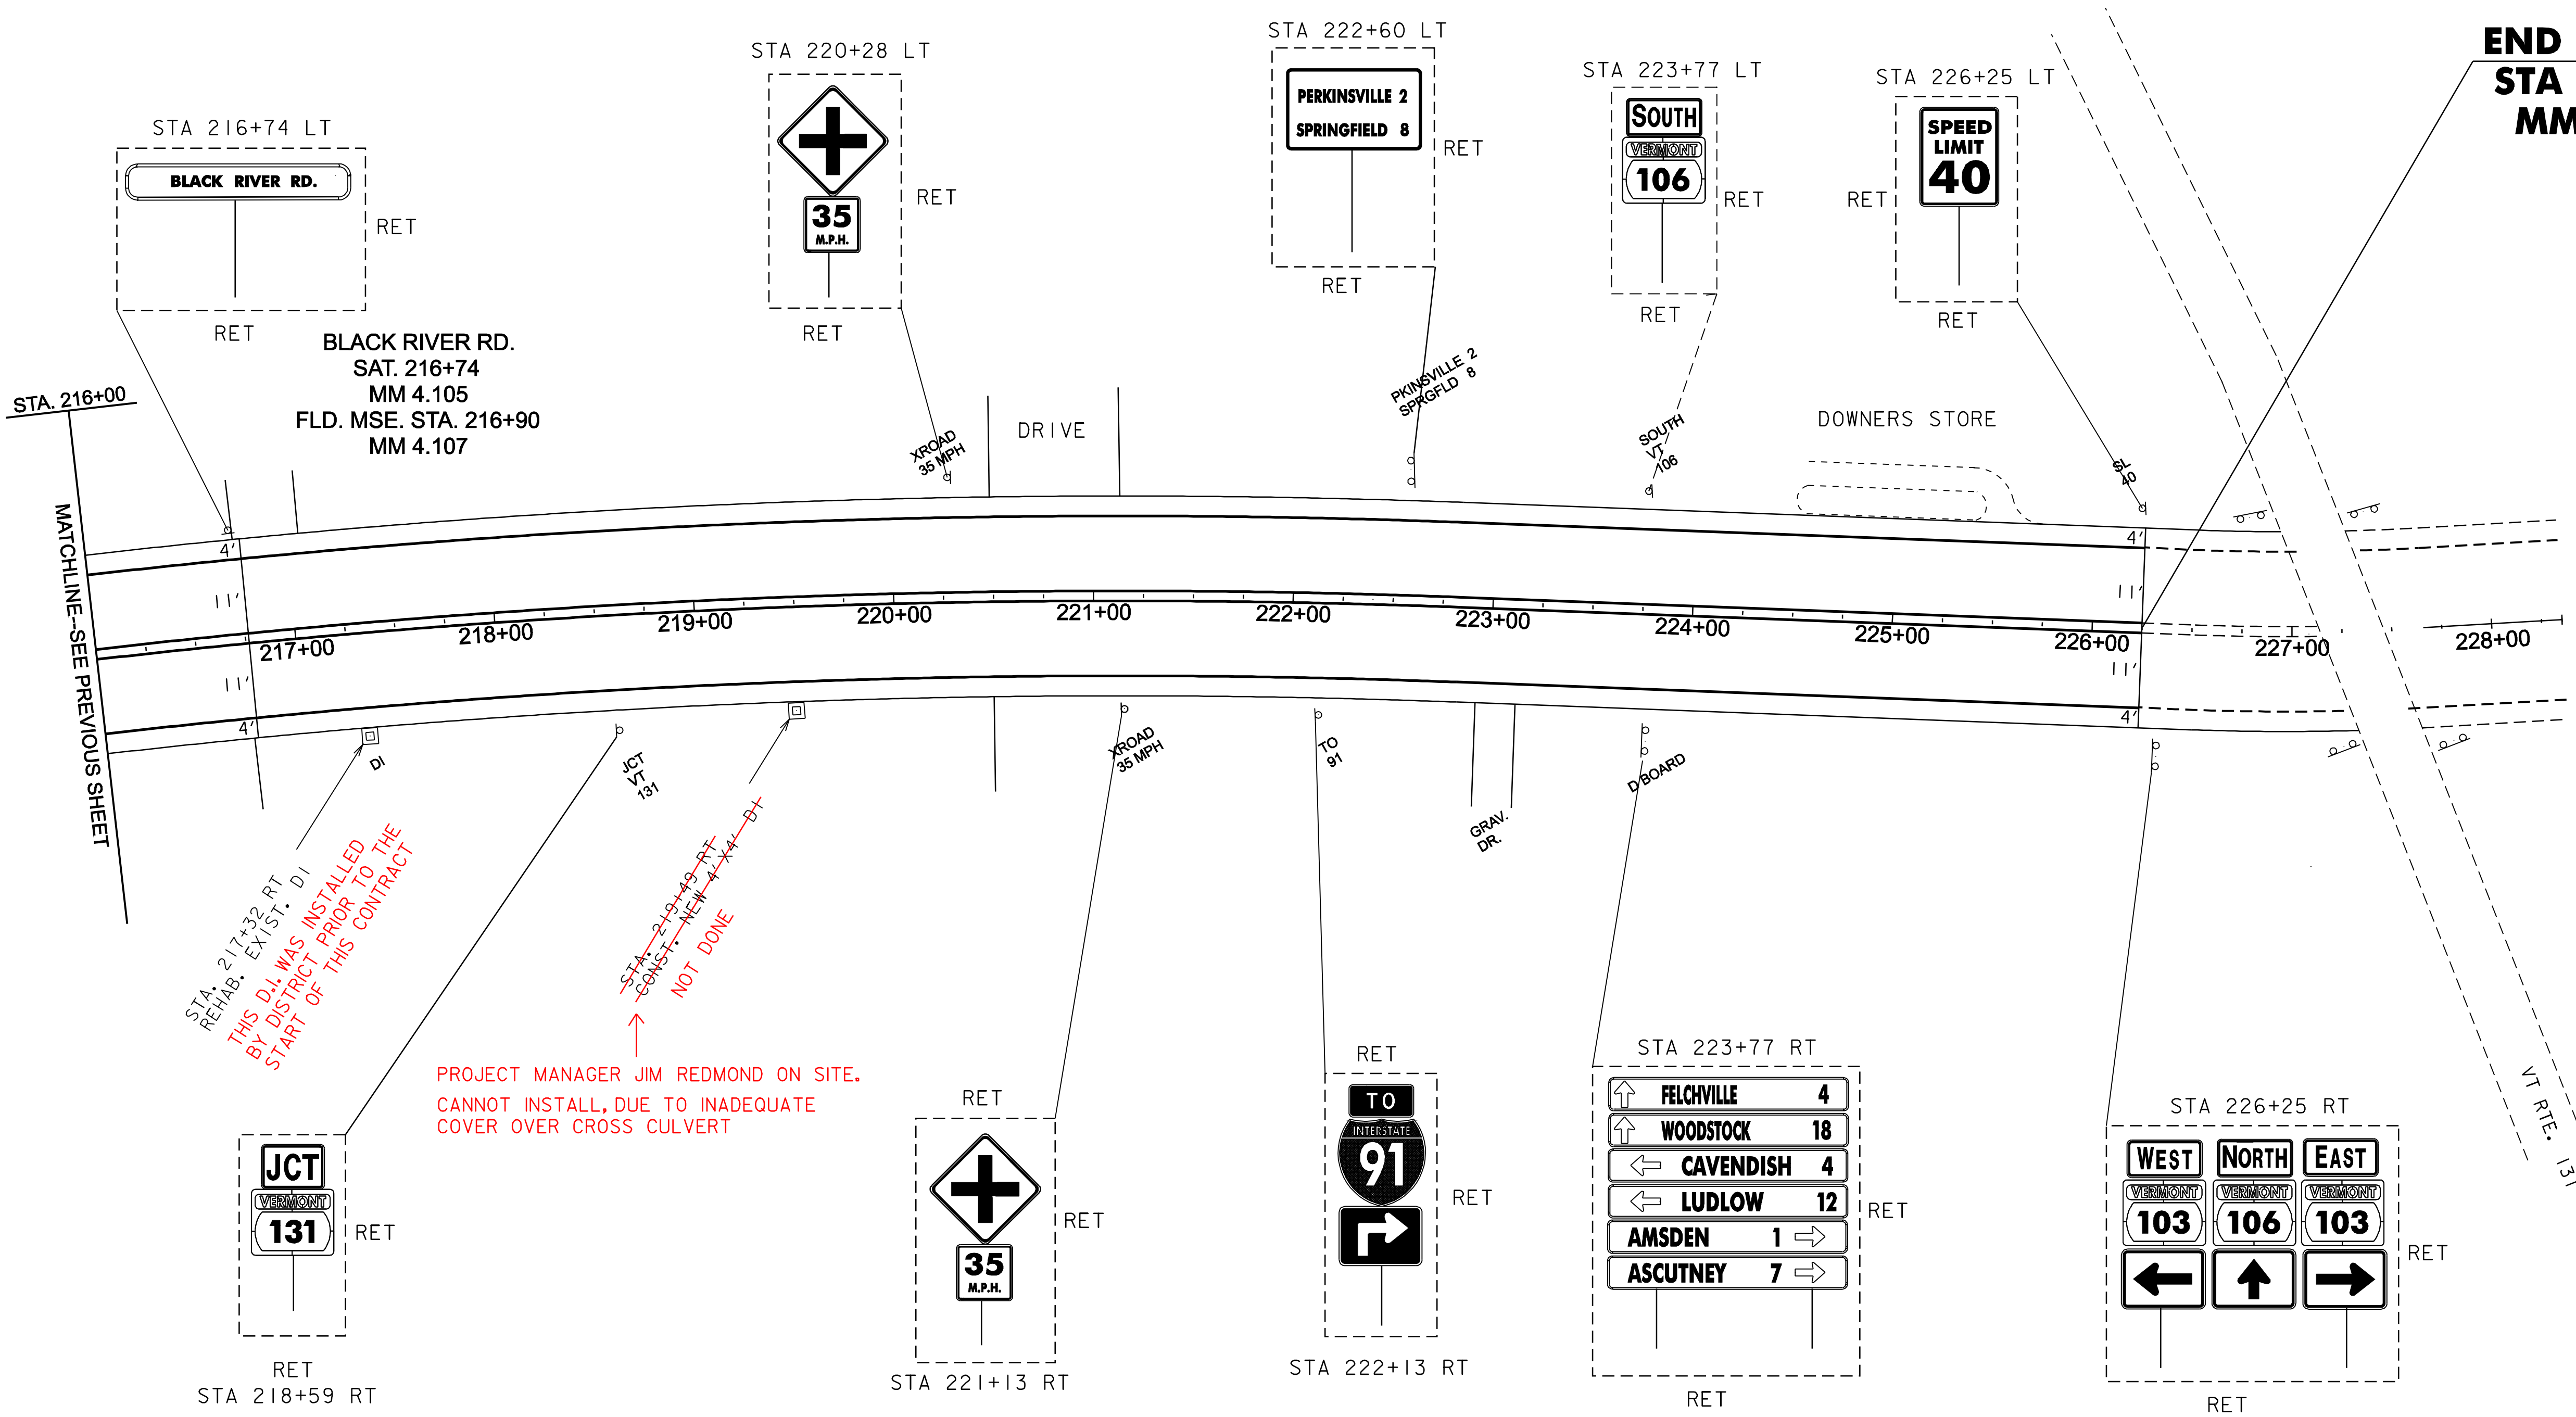

MATCHLINE--SEE PREVIOUS SHEET

STA. 217+32 RT
 REHAB. EXIST. D.I.
 THIS D.I. WAS INSTALLED
 BY DISTRICT PRIOR TO THE
 START OF THIS CONTRACT

PROJECT MANAGER JIM REDMOND ON SITE.
 CANNOT INSTALL, DUE TO INADEQUATE
 COVER OVER CROSS CULVERT

STA. 219+49 RT
 CONST. NEW D.I.
 NOT DONE

NOT TO SCALE

PROJECT LAYOUT SHEET 9	PROJECT NAME: WEATHERSEIELD.....
	PROJECT NUMBER: SIP_27111.....
	FILE NAME: p07c164.dgn.....
	DESIGNED BY: JLB.....
	PLOT DATE: 28-MAY-2010 13:4
	DRAWN BY: JLB.....
	CHECKED BY: JLB/LSW.....
	SHEET 19 OF 21.....