



**BEGIN OVERLAY**  
**MM 0.000 = STA 0+00.00**

**GUILFORD**

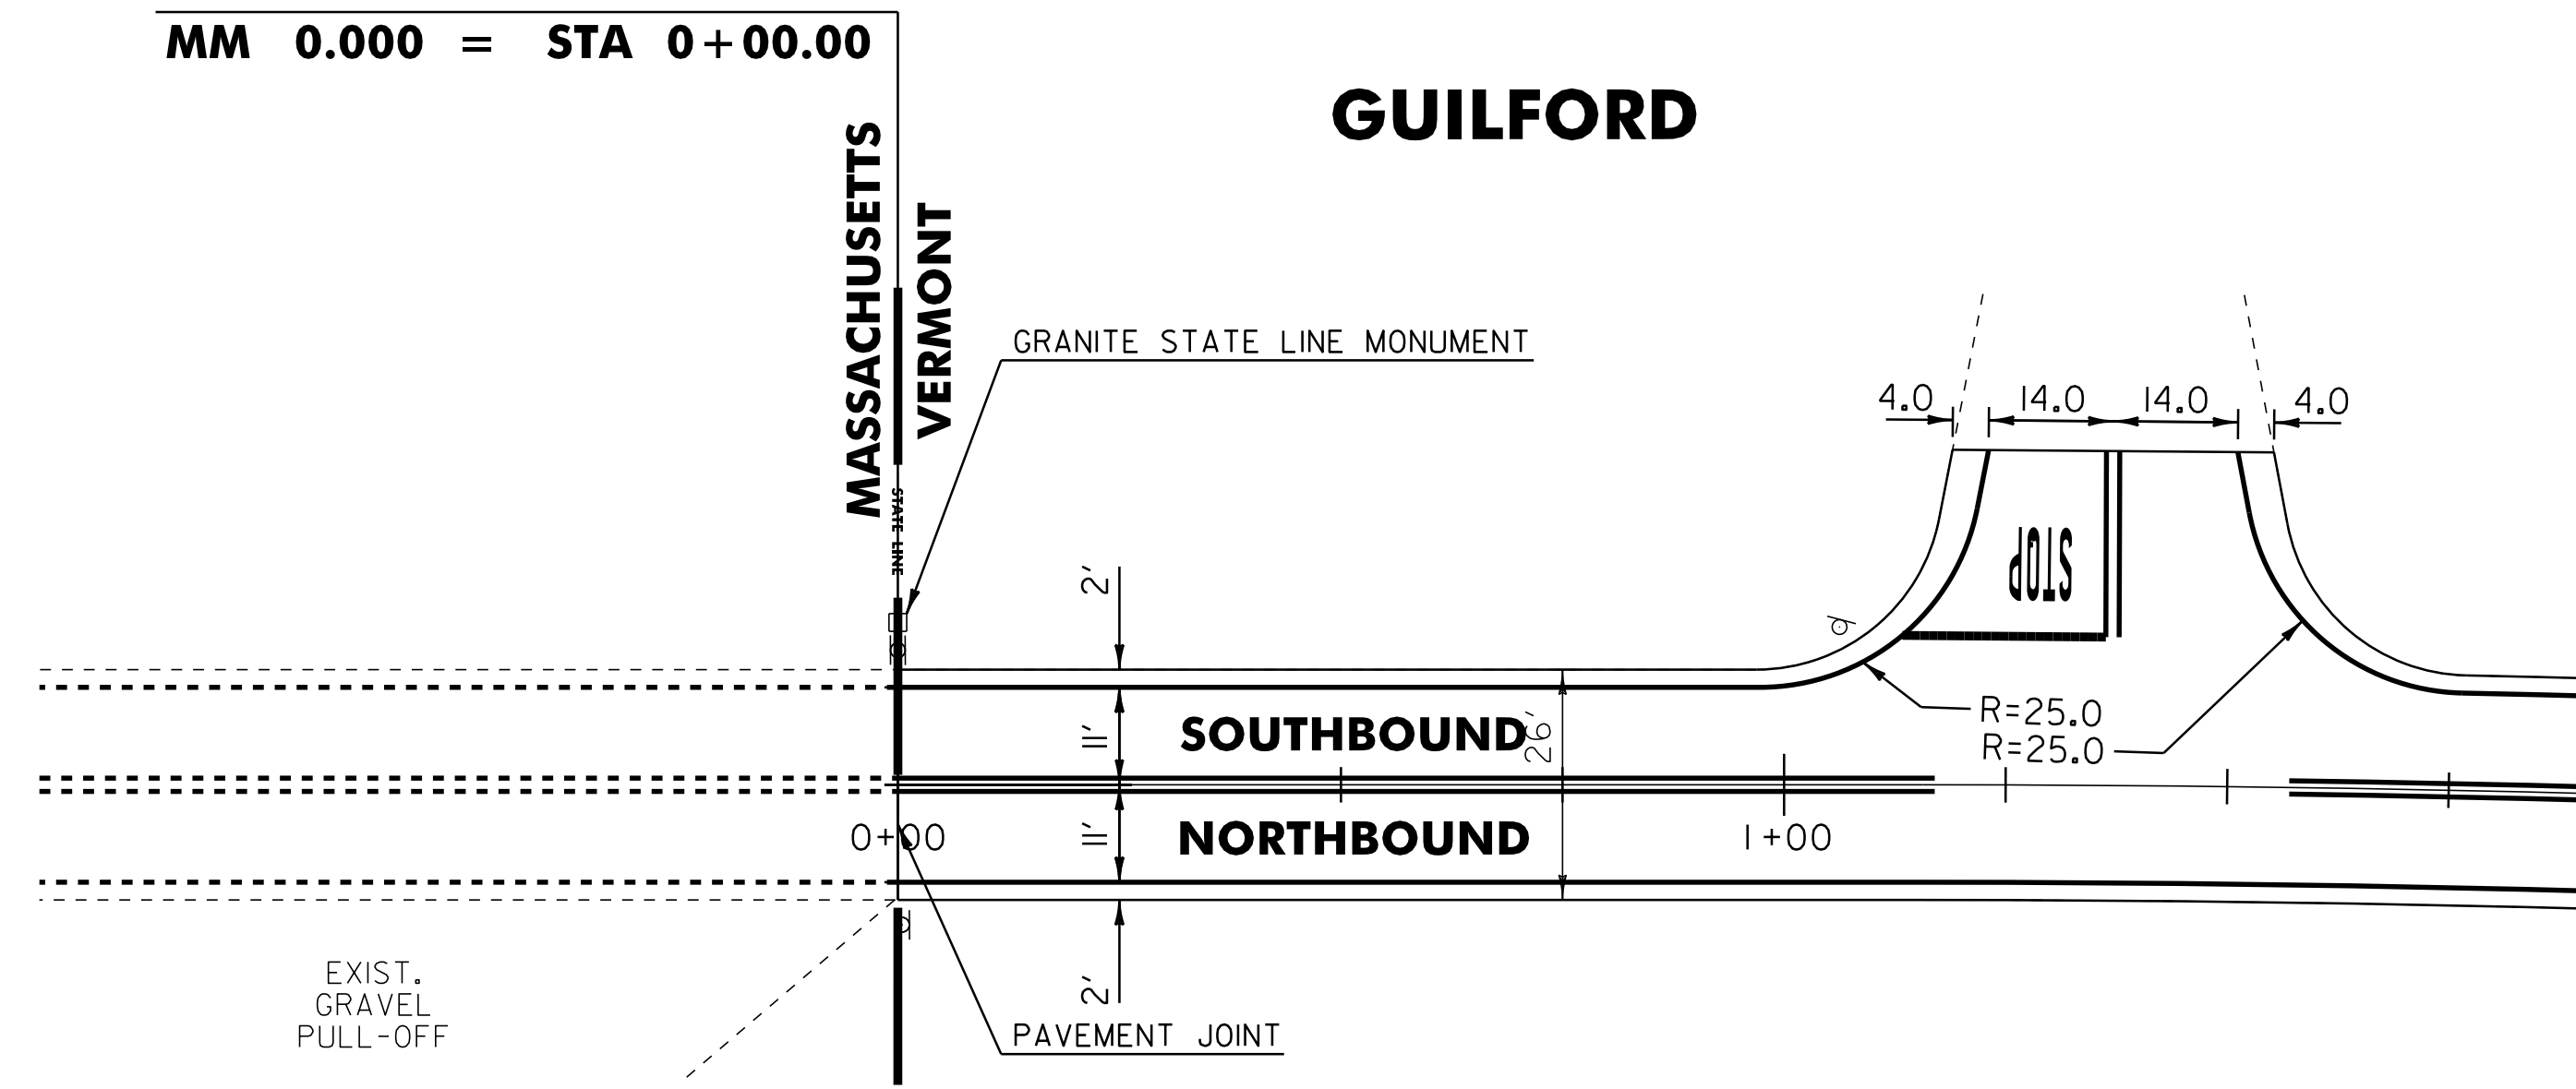

**BRATTLEBORO**

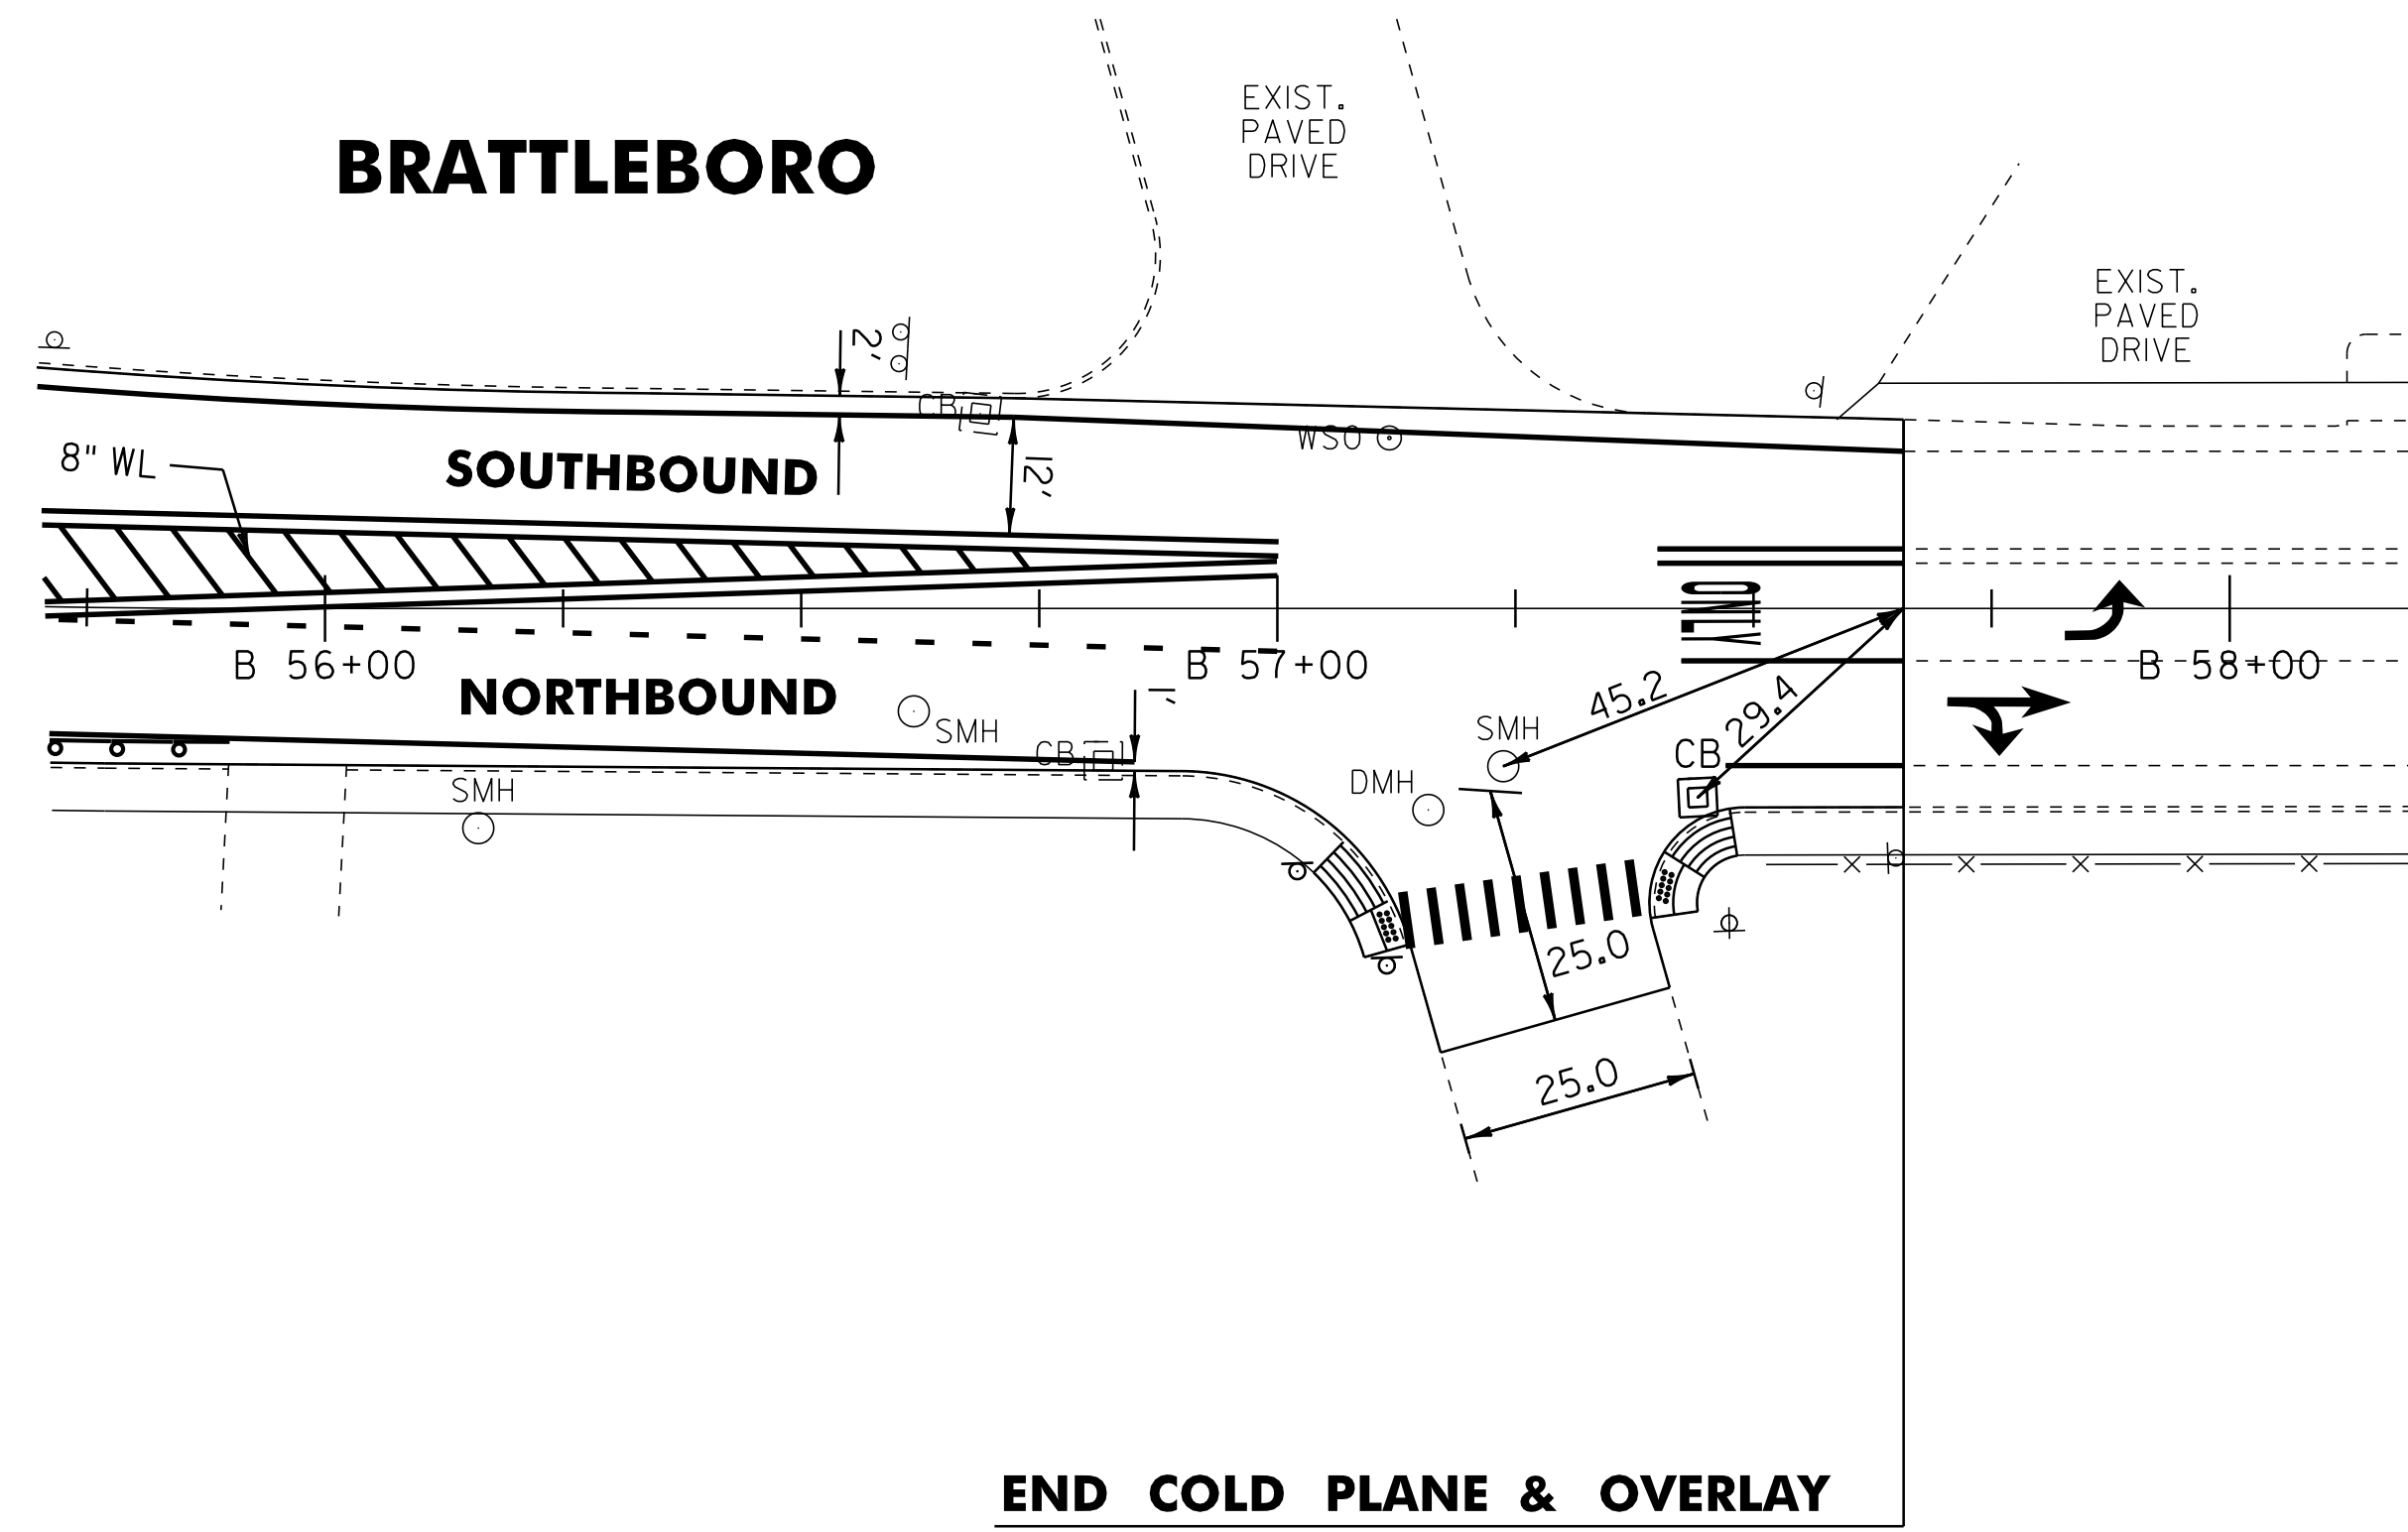

**END COLD PLANE & OVERLAY**  
**MM 1.092 = STA 57+65.76**

**TIE SHEET**

PROJECT NAME: GUILFORD-BRATTLEBORO  
 PROJECT NUMBER: STP 2707(1)

FILE NAME: /pave/07cl66/pcl66  
 PROJECT LEADER: PTS  
 DESIGNED BY: NULL  
 IPARM FILE NAME: 07C166\_03  
 PLOT DATE: 29-JAN-2013 11:40  
 DRAWN BY: WWC  
 CHECKED BY: PTS  
 SHEET 3 OF 97

NOT TO SCALE