

646.602 TEMPORARY 4" WHITE LINE, PAINT
 646.402 DURABLE 4" WHITE LINE, THERMOPLASTIC
 14+50 TO 25+50 SOLID LT
 14+50 TO 25+50 SOLID RT

646.612 TEMPORARY 4" YELLOW LINE, PAINT
 646.412 DURABLE 4" YELLOW LINE, THERMOPLASTIC
 14+50 TO 25+50 SOLID LT & RT

621.205 STEEL BEAM GUARDRAIL, GALVANIZED W/8 FEET POSTS
 19+20.5 TO 20+20.5 RT
 22+96.0 TO 25+50 RT

621.50 MANUFACTURED
 TERMINAL SECTION, FLARED
 18+83 TO 19+20.5 RT
 20+20.5 TO 20+58 RT



621.51 MANUFACTURED
 TERMINAL SECTION, TANGENT
 22+46 TO 22+96.0 RT

621.80 REMOVAL AND DISPOSAL OF GUARDRAIL
 18+83 TO 20+58 RT
 22+46 TO 25+50 RT

900.620 SPECIAL PROVISION
 (DELINEATOR WITH STEEL POST)
 18+83 RT
 20+58 RT
 22+46 RT

675.50 REMOVING SIGNS
 AS SHOWN - 2

STONE FILL, TYPE 1
 15+21 - 15+57 LT
 15+63 - 16+12 LT
 19+07 - 20+14 LT
 25+12 - 25+49 LT

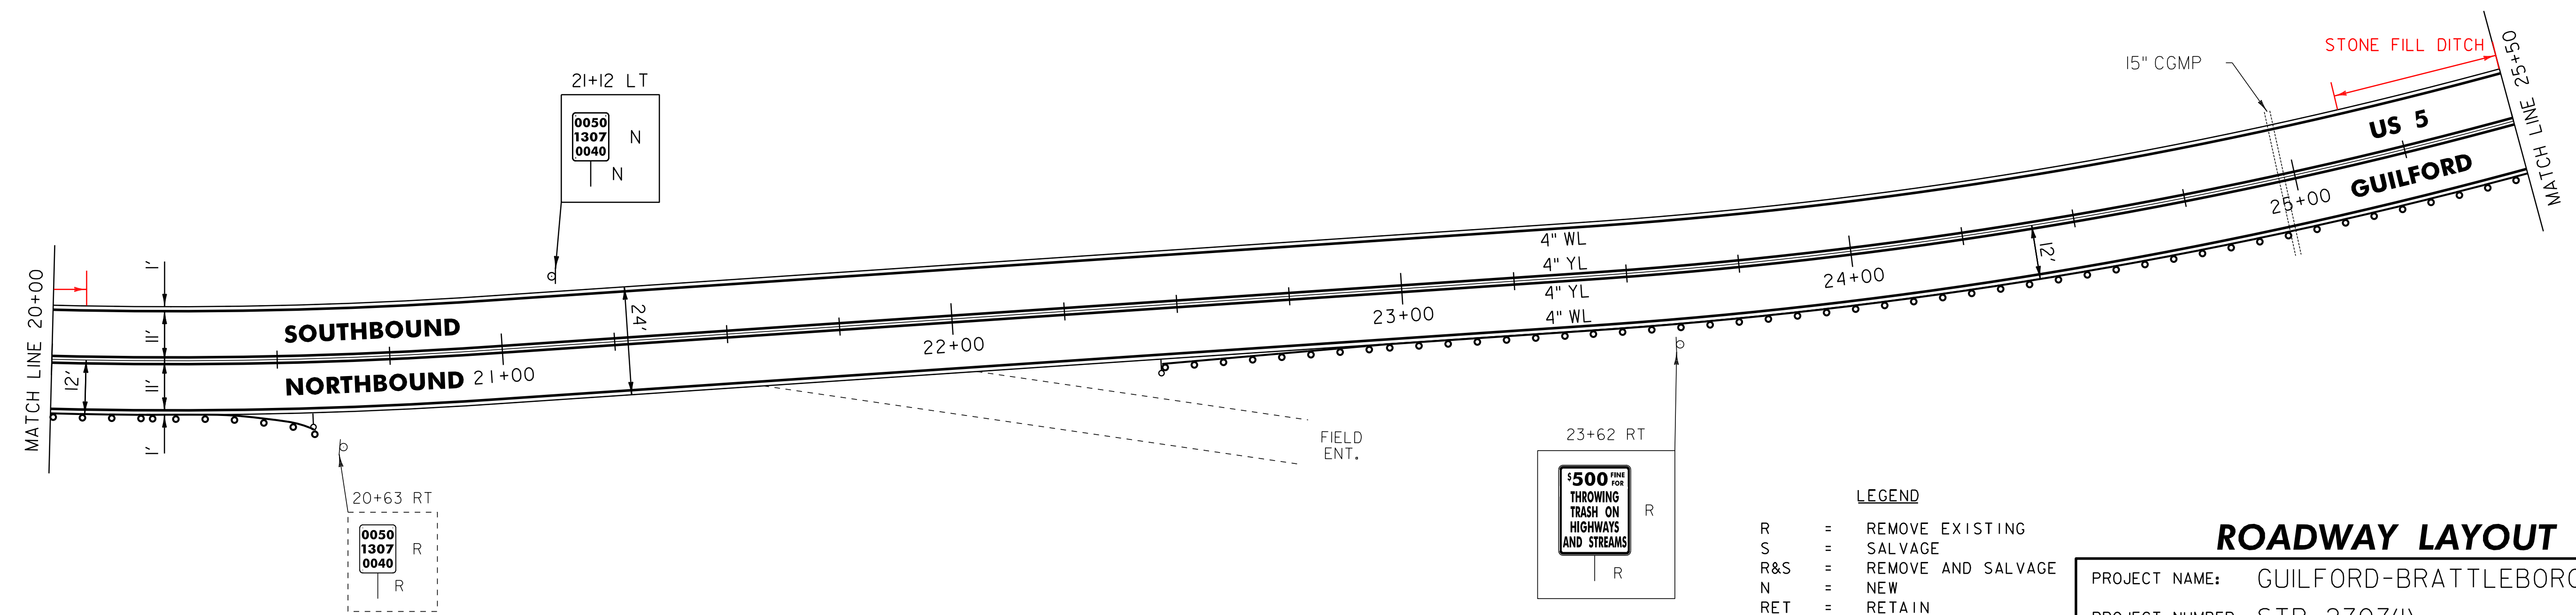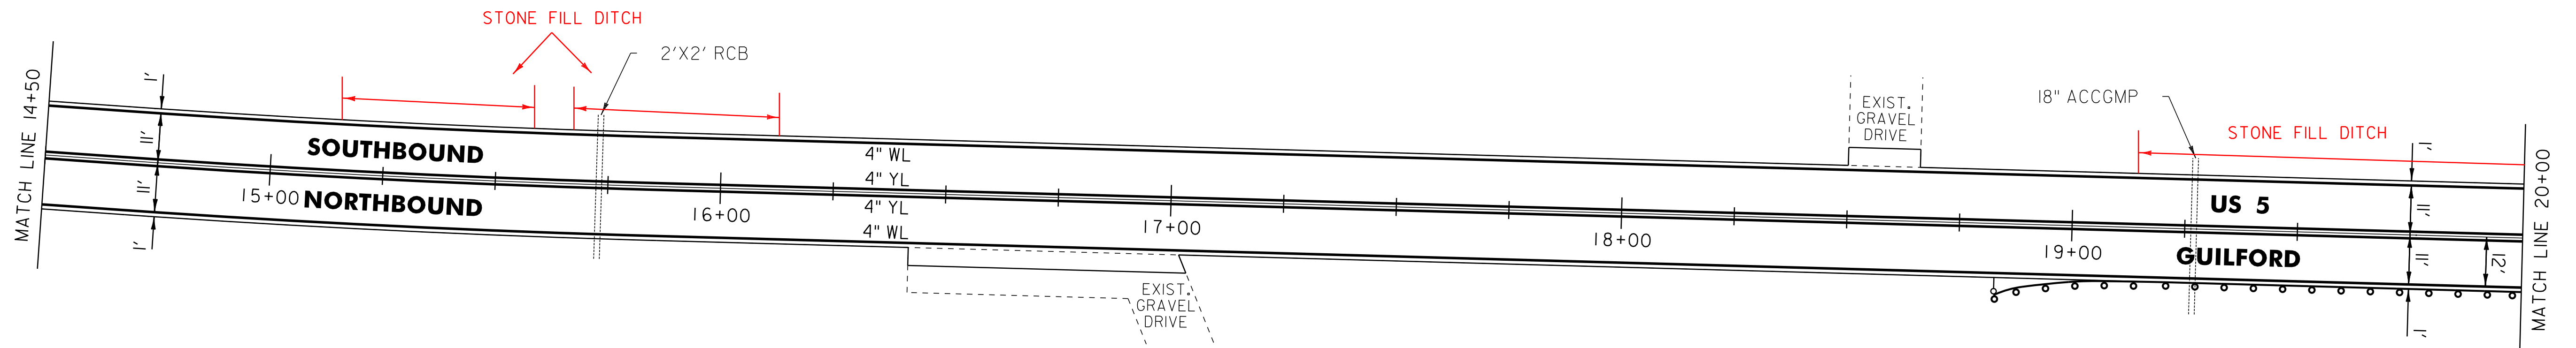

- LEGEND**
- R = REMOVE EXISTING
 - S = SALVAGE
 - R&S = REMOVE AND SALVAGE
 - N = NEW
 - RET = RETAIN
 - B-B = BACK TO BACK
 - = EXISTING GUARDRAIL
 - = PROPOSED GUARDRAIL
 - YL = YELLOW LINE
 - WL = WHITE LINE
 - = DELINEATOR

ROADWAY LAYOUT 3

PROJECT NAME: GUILFORD-BRATTLEBORO
 PROJECT NUMBER: STP 2707(1)

FILE NAME: /pave/07cl66/pcl66
 PROJECT LEADER: PTS
 DESIGNED BY: NLL
 IPARM FILE NAME: 07Cl66.22

PLOT DATE: 29-JAN-2013 11:40
 DRAWN BY: WWG
 CHECKED BY: NLL/PTS
 SHEET 22 OF 97

NOT TO SCALE