


646.602 TEMPORARY 4" WHITE LINE, PAINT
 646.402 DURABLE 4" WHITE LINE, THERMOPLASTIC
 42+00 TO 52+00 SOLID LT
 42+00 TO 52+00 SOLID RT

STONE FILL, TYPE 1
 47+00 - 47+39 LT

646.612 TEMPORARY 4" YELLOW LINE, PAINT
 646.412 DURABLE 4" YELLOW LINE, THERMOPLASTIC
 42+00 TO 52+00 SOLID LT & RT

675.50 REMOVING SIGNS
 AS SHOWN - 2

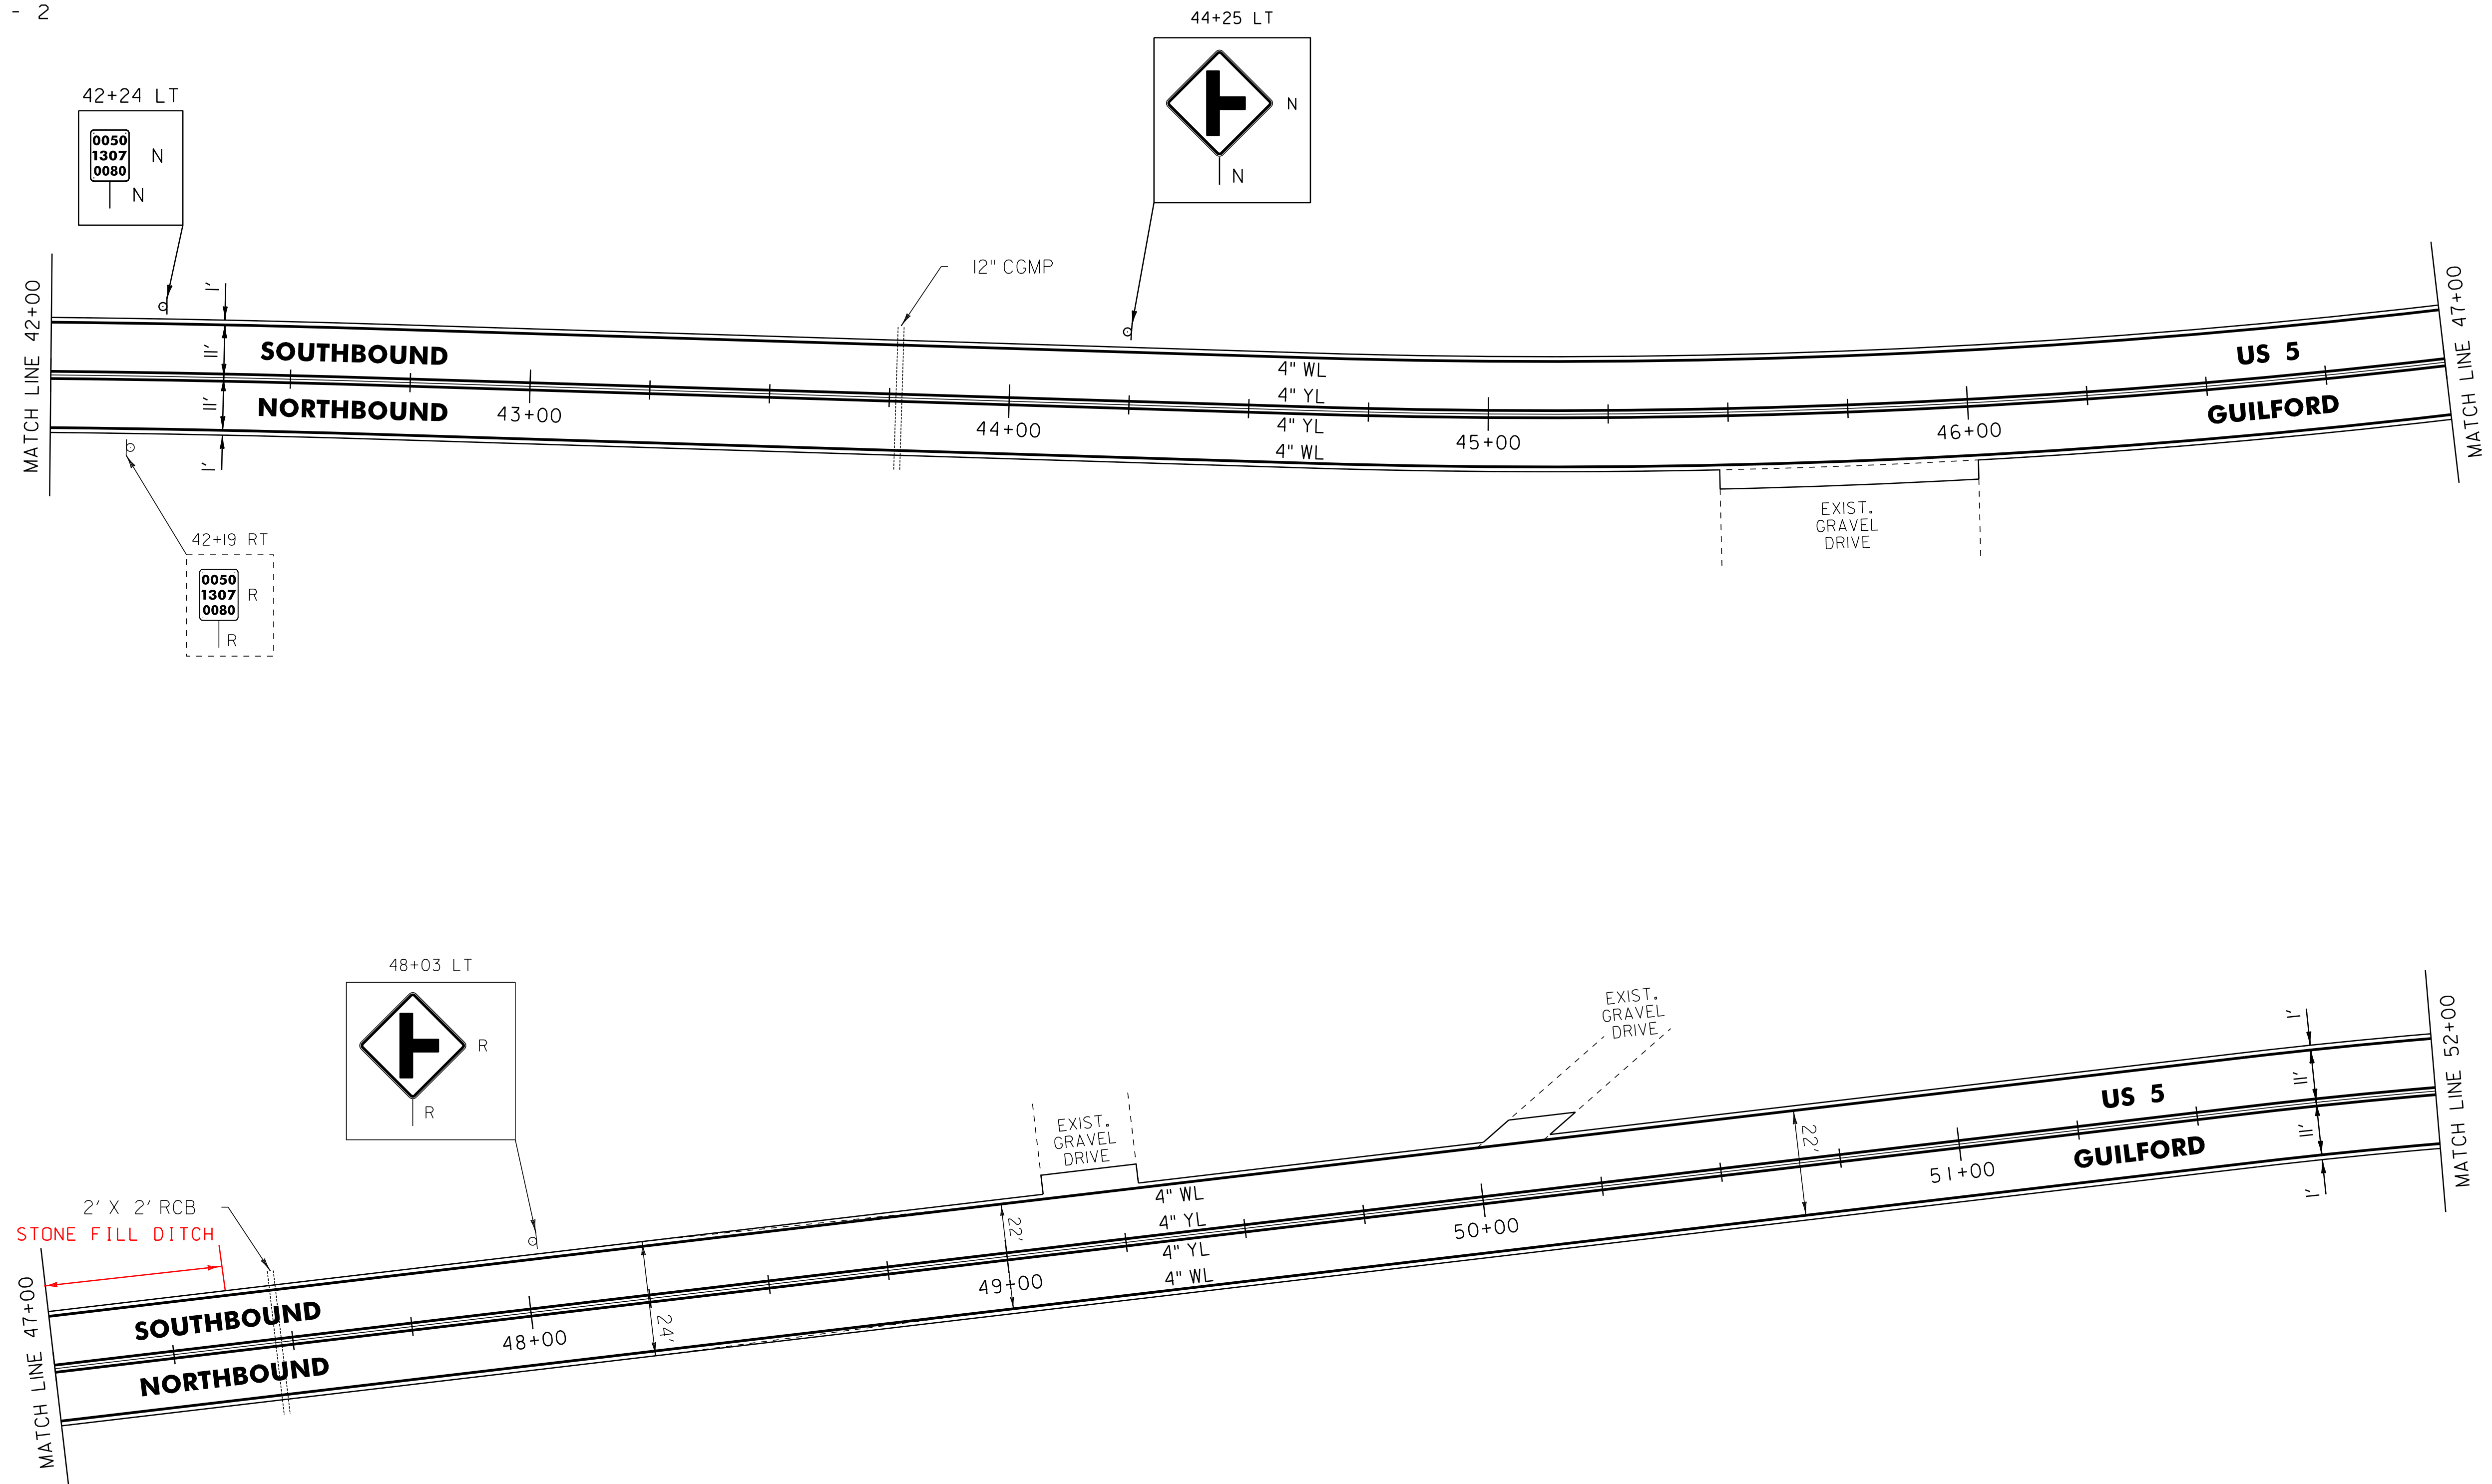

LEGEND

R	=	REMOVE EXISTING
S	=	SALVAGE
R&S	=	REMOVE AND SALVAGE
N	=	NEW
RET	=	RETAIN
B-B	=	BACK TO BACK
	=	EXISTING GUARDRAIL
	=	PROPOSED GUARDRAIL
YL	=	YELLOW LINE
WL	=	WHITE LINE
	=	DELINEATOR

ROADWAY LAYOUT 6	
PROJECT NAME:	GUILFORD-BRATTLEBORO
PROJECT NUMBER:	STP 2707(1)
FILE NAME:	/pave/07cl66/pcl66
PROJECT LEADER:	PTS
DESIGNED BY:	NLL
IPARM FILE NAME:	07Cl66.25
PLOT DATE:	29-JAN-2013 11:40
DRAWN BY:	WWG
CHECKED BY:	NLL/PTS
SHEET	25 OF 97

NOT TO SCALE