


646.602 TEMPORARY 4" WHITE LINE, PAINT  
 646.402 DURABLE 4" WHITE LINE, THERMOPLASTIC  
 52+00 TO 63+00 SOLID LT  
 52+00 TO 63+00 SOLID RT

646.612 TEMPORARY 4" YELLOW LINE, PAINT  
 646.412 DURABLE 4" YELLOW LINE, THERMOPLASTIC  
 52+00 TO 63+00 SOLID LT & RT

675.50 REMOVING SIGNS  
 AS SHOWN - 3

900.620 SPECIAL PROVISION  
 (DELINEATOR WITH STEEL POST)  
 (INSTALL 6" X 8" TYPE II DELINEATOR BACK TO BACK)  
 60+50 RT  
 61+00 RT  
 61+50 RT  
 62+00 RT

**STONE FILL, TYPE 1**  
 52+30 - 52+70 LT  
 56+20 - 56+37 LT  
 60+50 - 60+56 RT

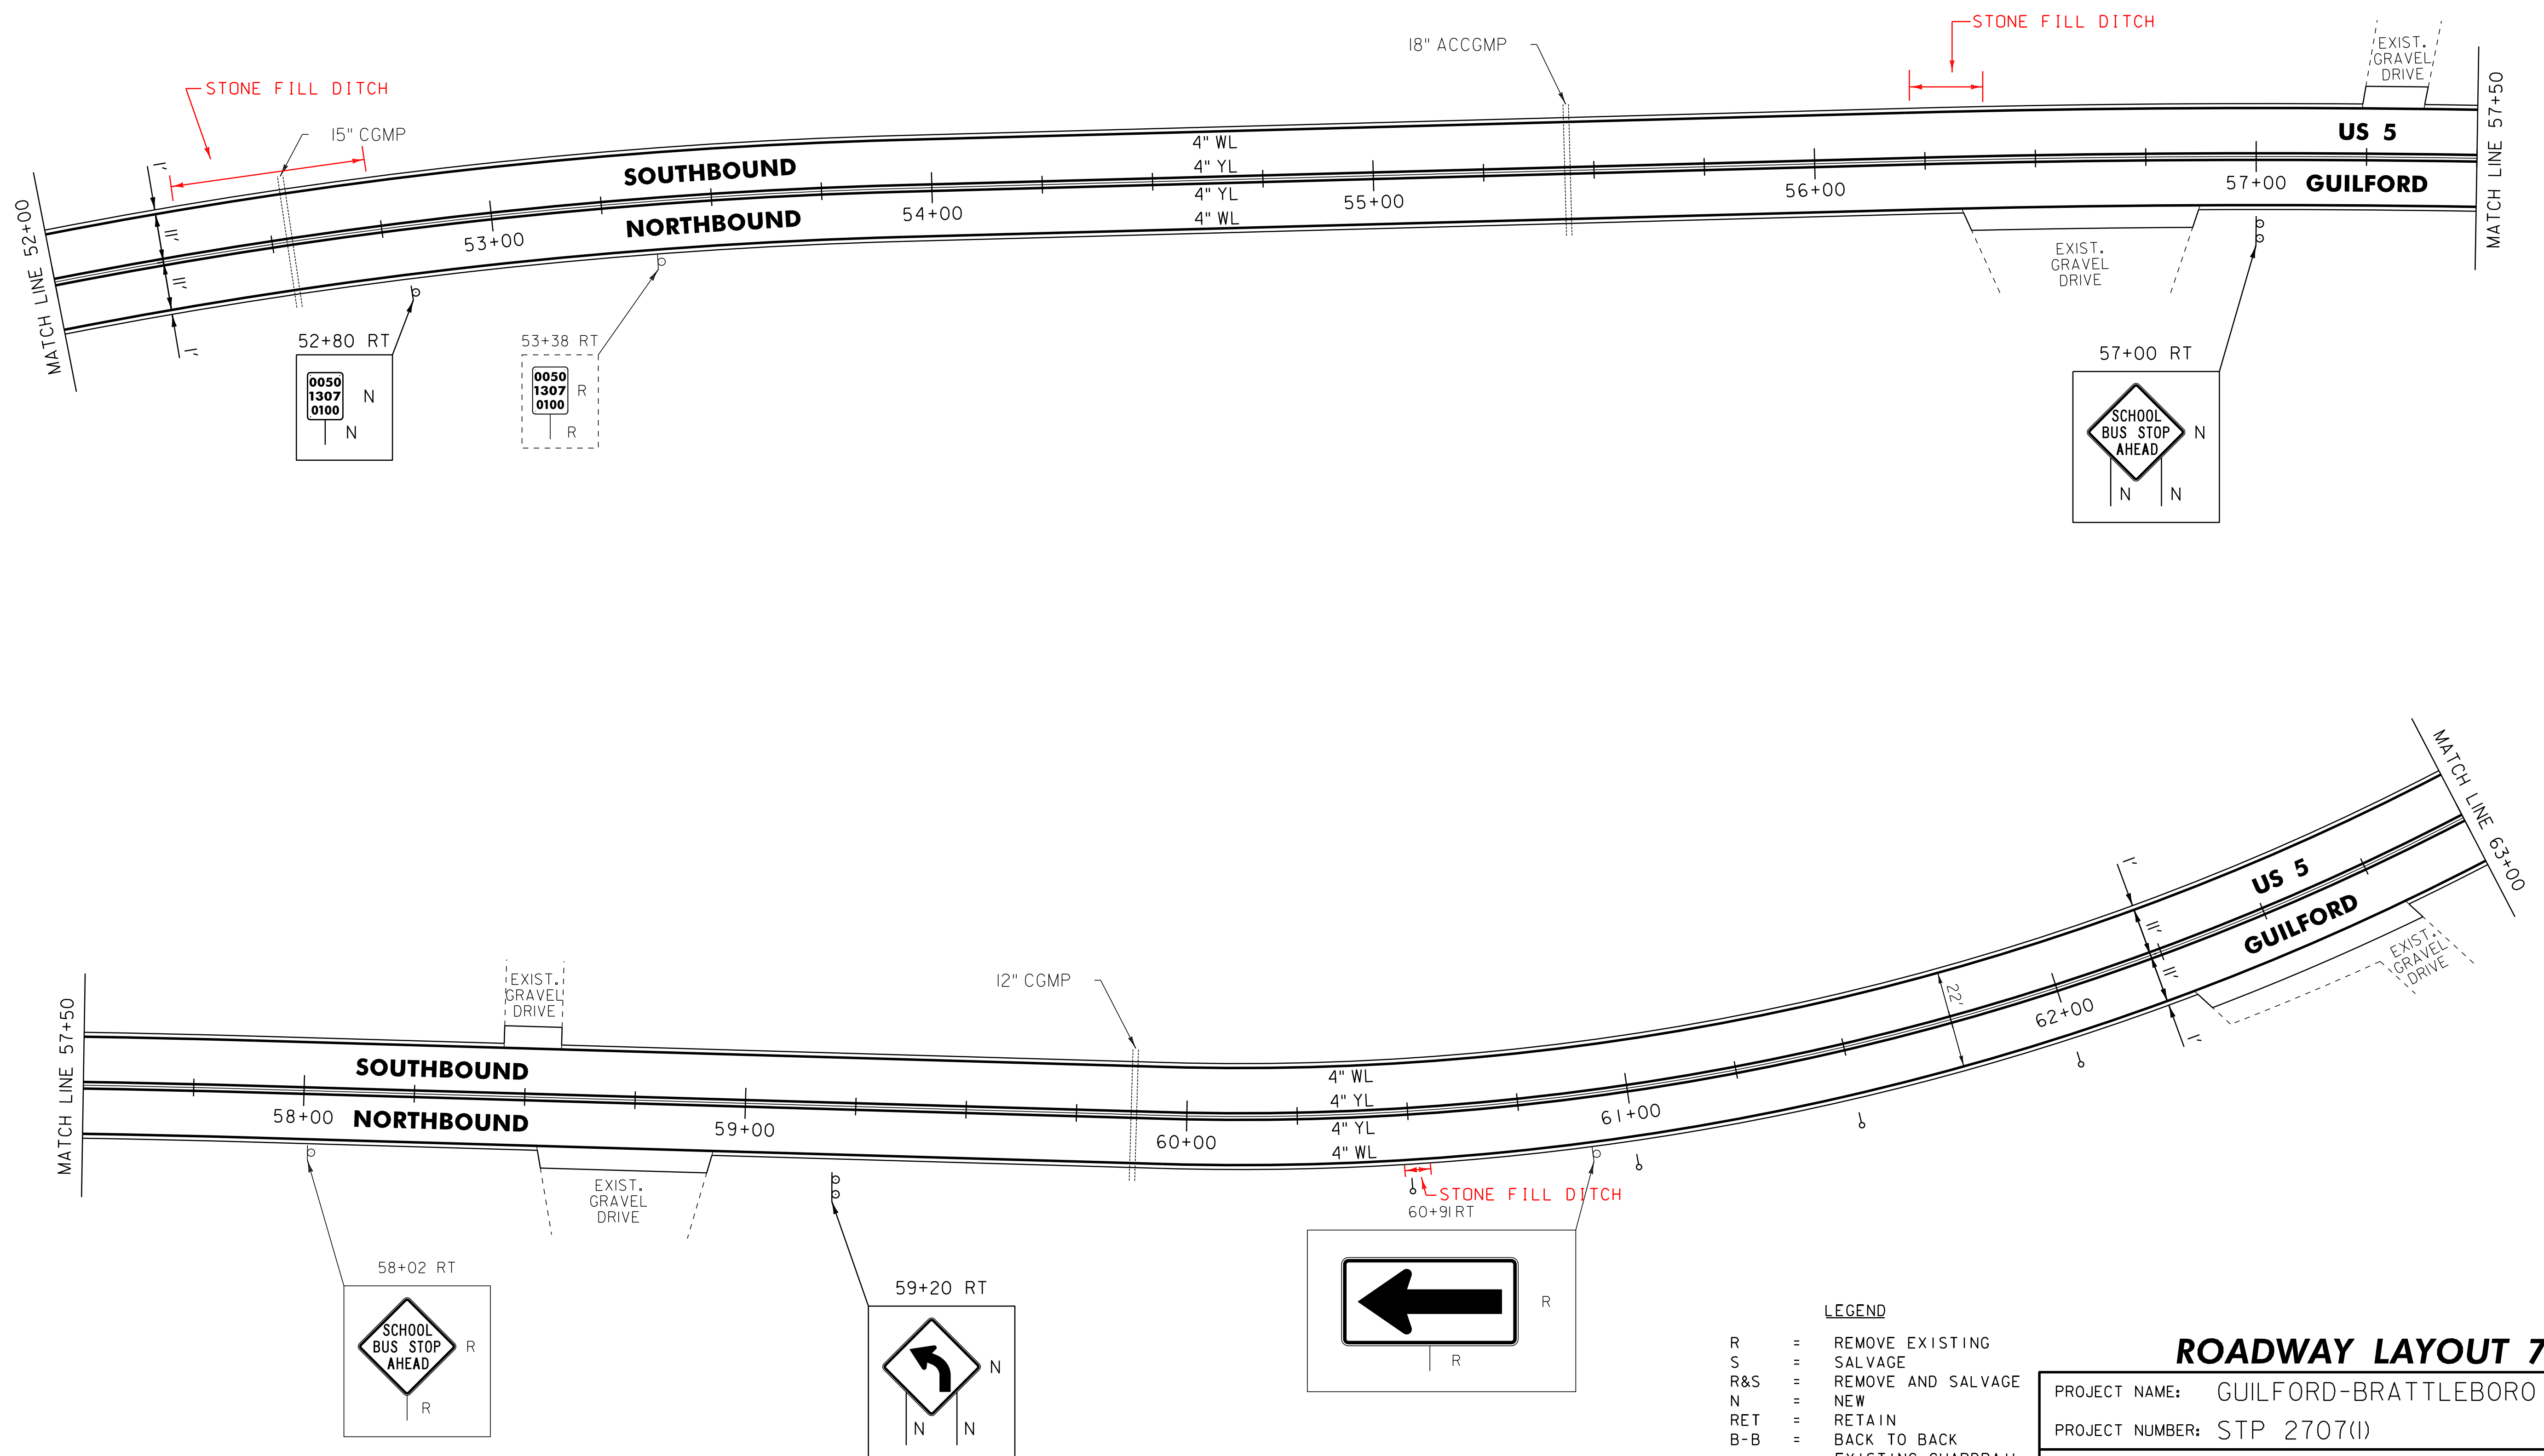

- LEGEND**
- R = REMOVE EXISTING
  - S = SALVAGE
  - R&S = REMOVE AND SALVAGE
  - N = NEW
  - RET = RETAIN
  - B-B = BACK TO BACK
  - o— = EXISTING GUARDRAIL
  - o— = PROPOSED GUARDRAIL
  - YL = YELLOW LINE
  - WL = WHITE LINE
  - o = DELINEATOR

**ROADWAY LAYOUT 7**

PROJECT NAME: GUILFORD-BRATTLEBORO  
 PROJECT NUMBER: STP 2707(1)

FILE NAME: /pave/07cl66/pcl66  
 PROJECT LEADER: PTS  
 DESIGNED BY: NLL  
 IPARM FILE NAME: 07Cl66.26

PLOT DATE: 29-JAN-2013 11:40  
 DRAWN BY: WWG  
 CHECKED BY: NLL/PTS  
 SHEET 26 OF 97

NOT TO SCALE