

646.602 TEMPORARY 4" WHITE LINE, PAINT  
 646.402 DURABLE 4" WHITE LINE, THERMOPLASTIC  
 63+00 TO 74+00 SOLID LT  
 63+00 TO 74+00 SOLID RT


646.612 TEMPORARY 4" YELLOW LINE, PAINT  
 646.412 DURABLE 4" YELLOW LINE, THERMOPLASTIC  
 63+00 TO 74+00 SOLID LT & RT

616.47 BITUMINOUS CONCRETE  
 GUTTERS AND TRAFFIC ISLANDS

70+45 TO 71+73 LT

675.50 REMOVING SIGNS  
 AS SHOWN - 3

675.60 ERECTING SALVAGED SIGNS  
 AS SHOWN - 1

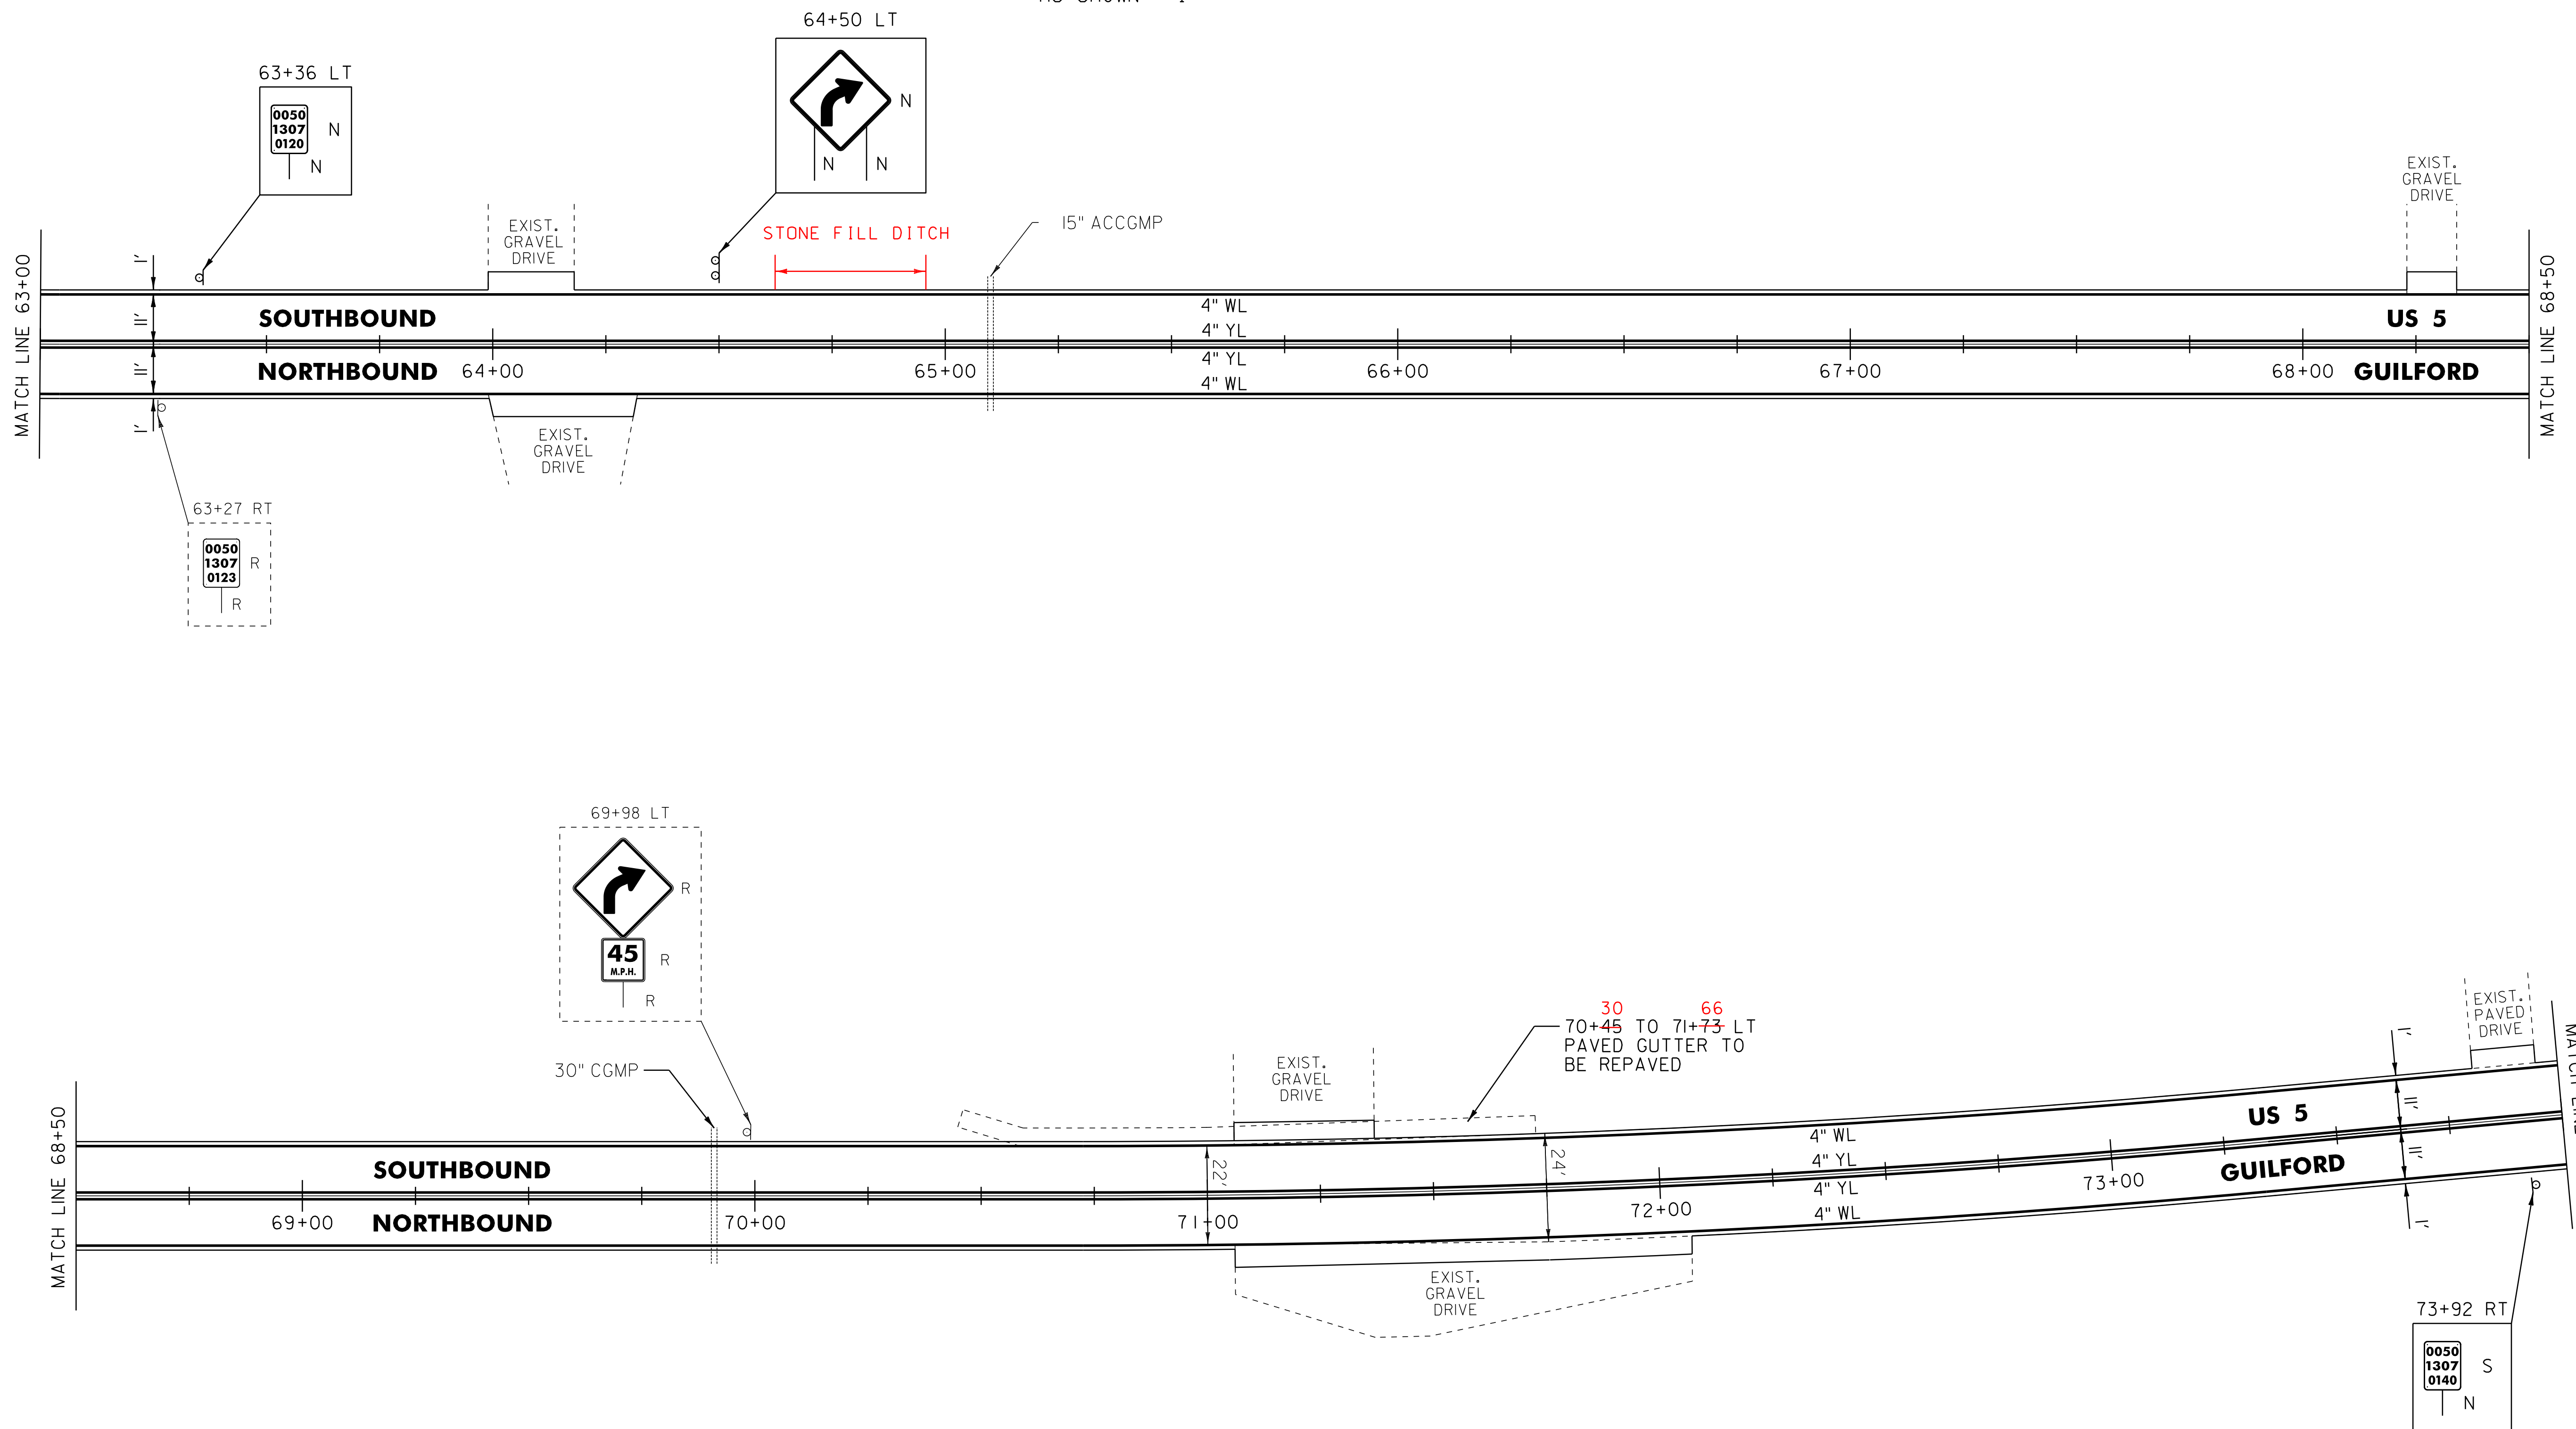

**LEGEND**

- R = REMOVE EXISTING
- S = SALVAGE
- R&S = REMOVE AND SALVAGE
- N = NEW
- RET = RETAIN
- B-B = BACK TO BACK
- = EXISTING GUARDRAIL
- = PROPOSED GUARDRAIL
- YL = YELLOW LINE
- WL = WHITE LINE
- = DELINEATOR

**ROADWAY LAYOUT 8**

PROJECT NAME: GUILFORD-BRATTLEBORO  
 PROJECT NUMBER: STP 2707(1)

FILE NAME: /pave/07cl66/pcl66  
 PROJECT LEADER: PTS  
 DESIGNED BY: NLL  
 IPARM FILE NAME: 07Cl66.27

PLOT DATE: 29-JAN-2013 11:40  
 DRAWN BY: WWG  
 CHECKED BY: NLL/PTS  
 SHEET 27 OF 97

NOT TO SCALE