

646.602 TEMPORARY 4" WHITE LINE, PAINT
 646.402 DURABLE 4" WHITE LINE, THERMOPLASTIC
 74+00 TO 77+96 SOLID LT
 74+00 TO 79+50 SOLID RT
 77+96 TO 78+15 SOLID LT (TH 51)
 78+41 TO 78+71 SOLID LT (TH 51)
 78+71 TO 79+50 SOLID LT

646.612 TEMPORARY 4" YELLOW LINE, PAINT
 646.412 DURABLE 4" YELLOW LINE, THERMOPLASTIC
 74+00 TO 78+11 SOLID LT & RT
 78+28 DOUBLE SOLID LT (TH 51)
 78+51 TO 79+50 SOLID LT & RT

646.682 TEMPORARY 24" STOP BAR, PAINT
 646.482 DURABLE 24" STOP BAR, THERMOPLASTIC
 78+07 TO 78+27 LT

646.692 TEMPORARY LETTER OR SYMBOL, PAINT
 646.492 DURABLE LETTER OR SYMBOL, THERMOPLASTIC
 78+19 LT - STOP (TH 51)

616.35 TREATED TIMBER CURB
 75+04 TO 75+14 RT
 74+94

621.20 STEEL BEAM GUARDRAIL, GALVANIZED
 74+76.5 TO 74+89 LT
 74+76.5 TO 74+89 RT
 75+89 TO 76+26.5 LT
 75+89 TO 76+01.5 RT

621.21H.D. STEEL BEAM GUARDRAIL, GALVANIZED
 74+89 TO 75+14 LT
 74+89 TO 75+14 RT
 75+64 TO 75+89 LT
 75+64 TO 75+89 RT


621.50 MANUFACTURED TERMINAL SECTION, FLARED
 74+39 TO 74+76.5 LT
 74+39 TO 74+76.5 RT
 76+26.5 TO 76+64 LT
 76+01.5 TO 76+39 RT

621.80 REMOVAL AND DISPOSAL OF GUARDRAIL
 74+60 TO 75+14 LT
 74+60 TO 75+14 RT
 75+64 TO 76+10 LT
 75+64 TO 76+22 RT

900.620 SPECIAL PROVISION (DELINEATOR WITH STEEL POST)
 74+39 LT
 74+39 RT
 76+39 RT
 76+64 LT

675.50 REMOVING SIGNS
 AS SHOWN - 6

675.60 ERECTING SALVAGED SIGNS
 AS SHOWN - 2

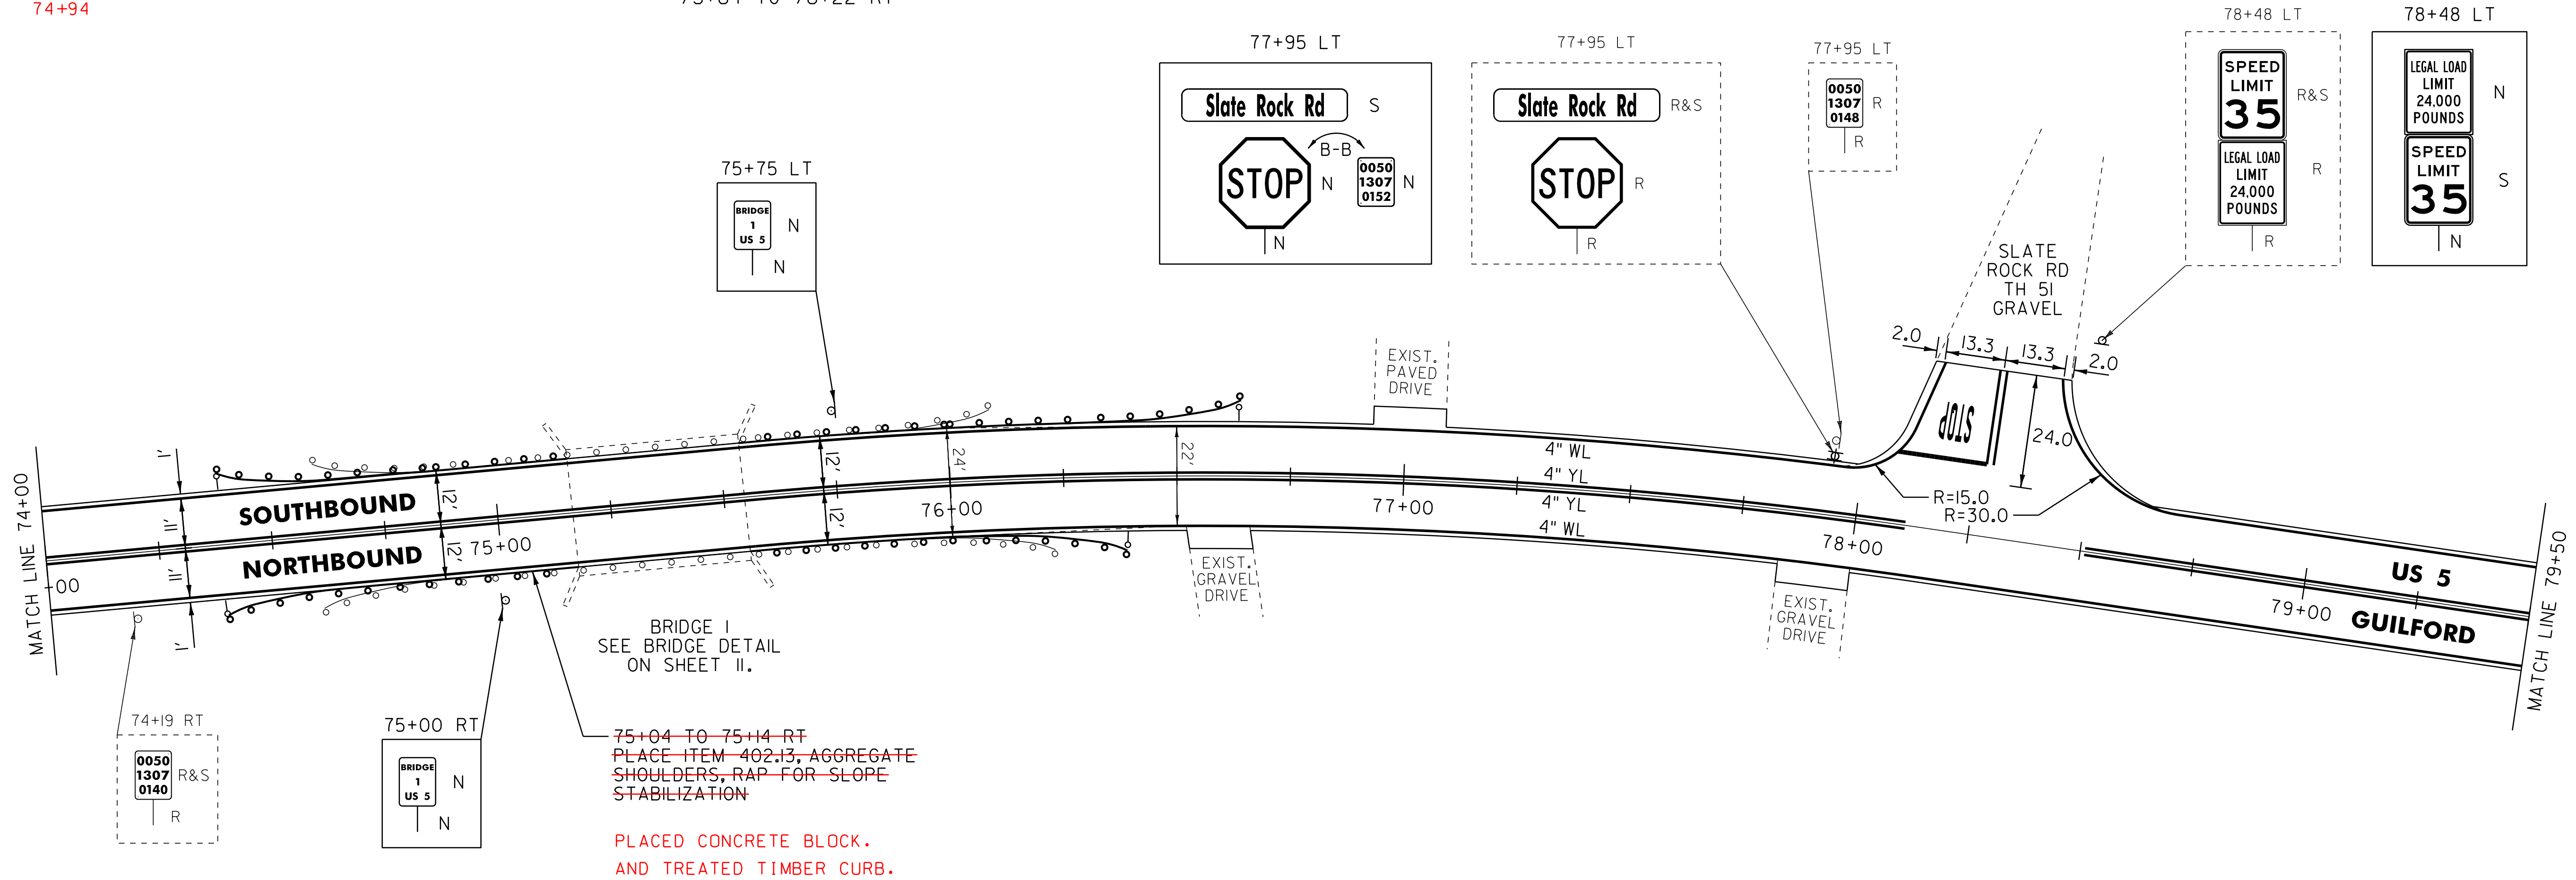

75+04 TO 75+14 RT
 PLACE ITEM 402.13, AGGREGATE SHOULDERS, RAP FOR SLOPE STABILIZATION
 PLACED CONCRETE BLOCK.
 AND TREATED TIMBER CURB.

- LEGEND
- R = REMOVE EXISTING
 - S = SALVAGE
 - R&S = REMOVE AND SALVAGE
 - N = NEW
 - RET = RETAIN
 - B-B = BACK TO BACK
 - = EXISTING GUARDRAIL
 - = PROPOSED GUARDRAIL
 - YL = YELLOW LINE
 - WL = WHITE LINE
 - = DELINEATOR

ROADWAY LAYOUT 9

PROJECT NAME: GUILFORD-BRATTLEBORO
 PROJECT NUMBER: STP 2707(1)

FILE NAME: /pave/07cl66/pcl66
 PROJECT LEADER: PTS
 DESIGNED BY: NLL
 IPARM FILE NAME: 07Cl66.28

PLOT DATE: 29-JAN-2013 11:40
 DRAWN BY: WWG
 CHECKED BY: NLL/PTS
 SHEET 28 OF 97

NOT TO SCALE