
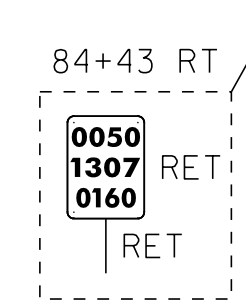


646.602 TEMPORARY 4" WHITE LINE, PAINT  
 646.402 DURABLE 4" WHITE LINE, THERMOPLASTIC  
 79+50 TO 90+50 SOLID LT  
 79+50 TO 90+50 SOLID RT

STONE FILL, TYPE 1  
 82+00 - 82+34 LT

646.612 TEMPORARY 4" YELLOW LINE, PAINT  
 646.412 DURABLE 4" YELLOW LINE, THERMOPLASTIC  
 79+50 TO 84+75 SOLID LT & RT  
 84+75 TO 90+50 DASHED LT, SOLID RT

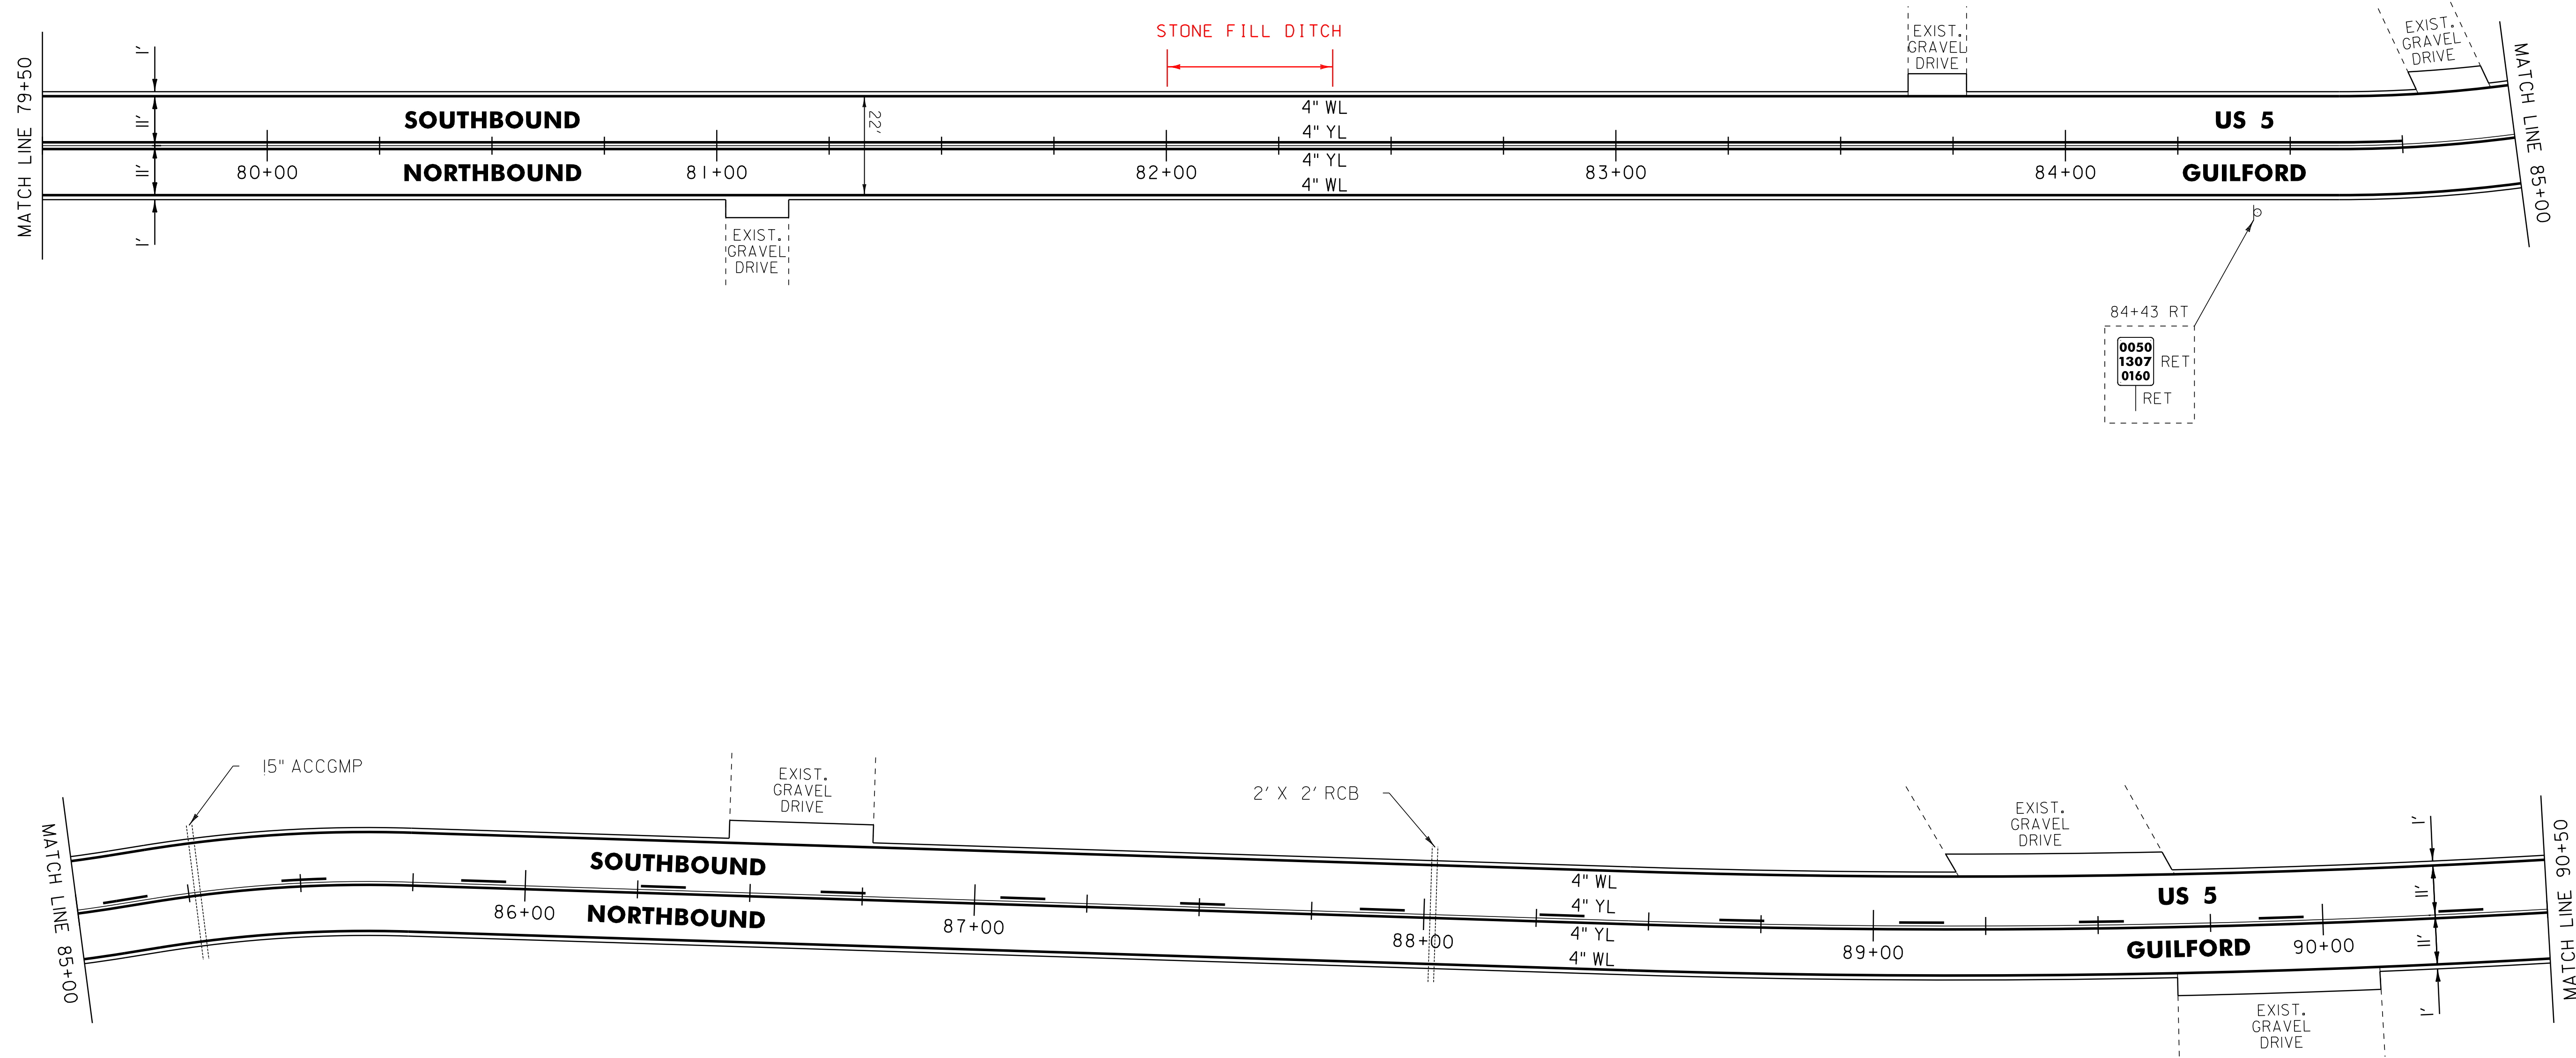

**LEGEND**

R	=	REMOVE EXISTING
S	=	SALVAGE
R&S	=	REMOVE AND SALVAGE
N	=	NEW
RET	=	RETAIN
B-B	=	BACK TO BACK
	=	EXISTING GUARDRAIL
	=	PROPOSED GUARDRAIL
YL	=	YELLOW LINE
WL	=	WHITE LINE
	=	DELINEATOR

**ROADWAY LAYOUT 10**

PROJECT NAME: GUILFORD-BRATTLEBORO	FILE NAME: /pave/07cl66/pcl66	PLOT DATE: 29-JAN-2013 11:41
PROJECT NUMBER: STP 2707(1)	PROJECT LEADER: PTS	DRAWN BY: WWG
	DESIGNED BY: NLL	CHECKED BY: NLL/PTS
	IPARM FILE NAME: 07CI66.29	SHEET 29 OF 97

NOT TO SCALE