


646.602 TEMPORARY 4" WHITE LINE, PAINT
 646.402 DURABLE 4" WHITE LINE, THERMOPLASTIC
 161+50 TO 167+00 SOLID LT
 161+50 TO 164+11 SOLID RT
 165+26 TO 167+00 SOLID RT

646.612 TEMPORARY 4" YELLOW LINE, PAINT
 646.412 DURABLE 4" YELLOW LINE, THERMOPLASTIC
 161+50 TO 164+14 SOLID LT & RT
 164+54 TO 164+80 SOLID LT & RT
 165+20 TO 167+00 SOLID LT & RT

675.50 REMOVING SIGNS
 AS SHOWN - 6

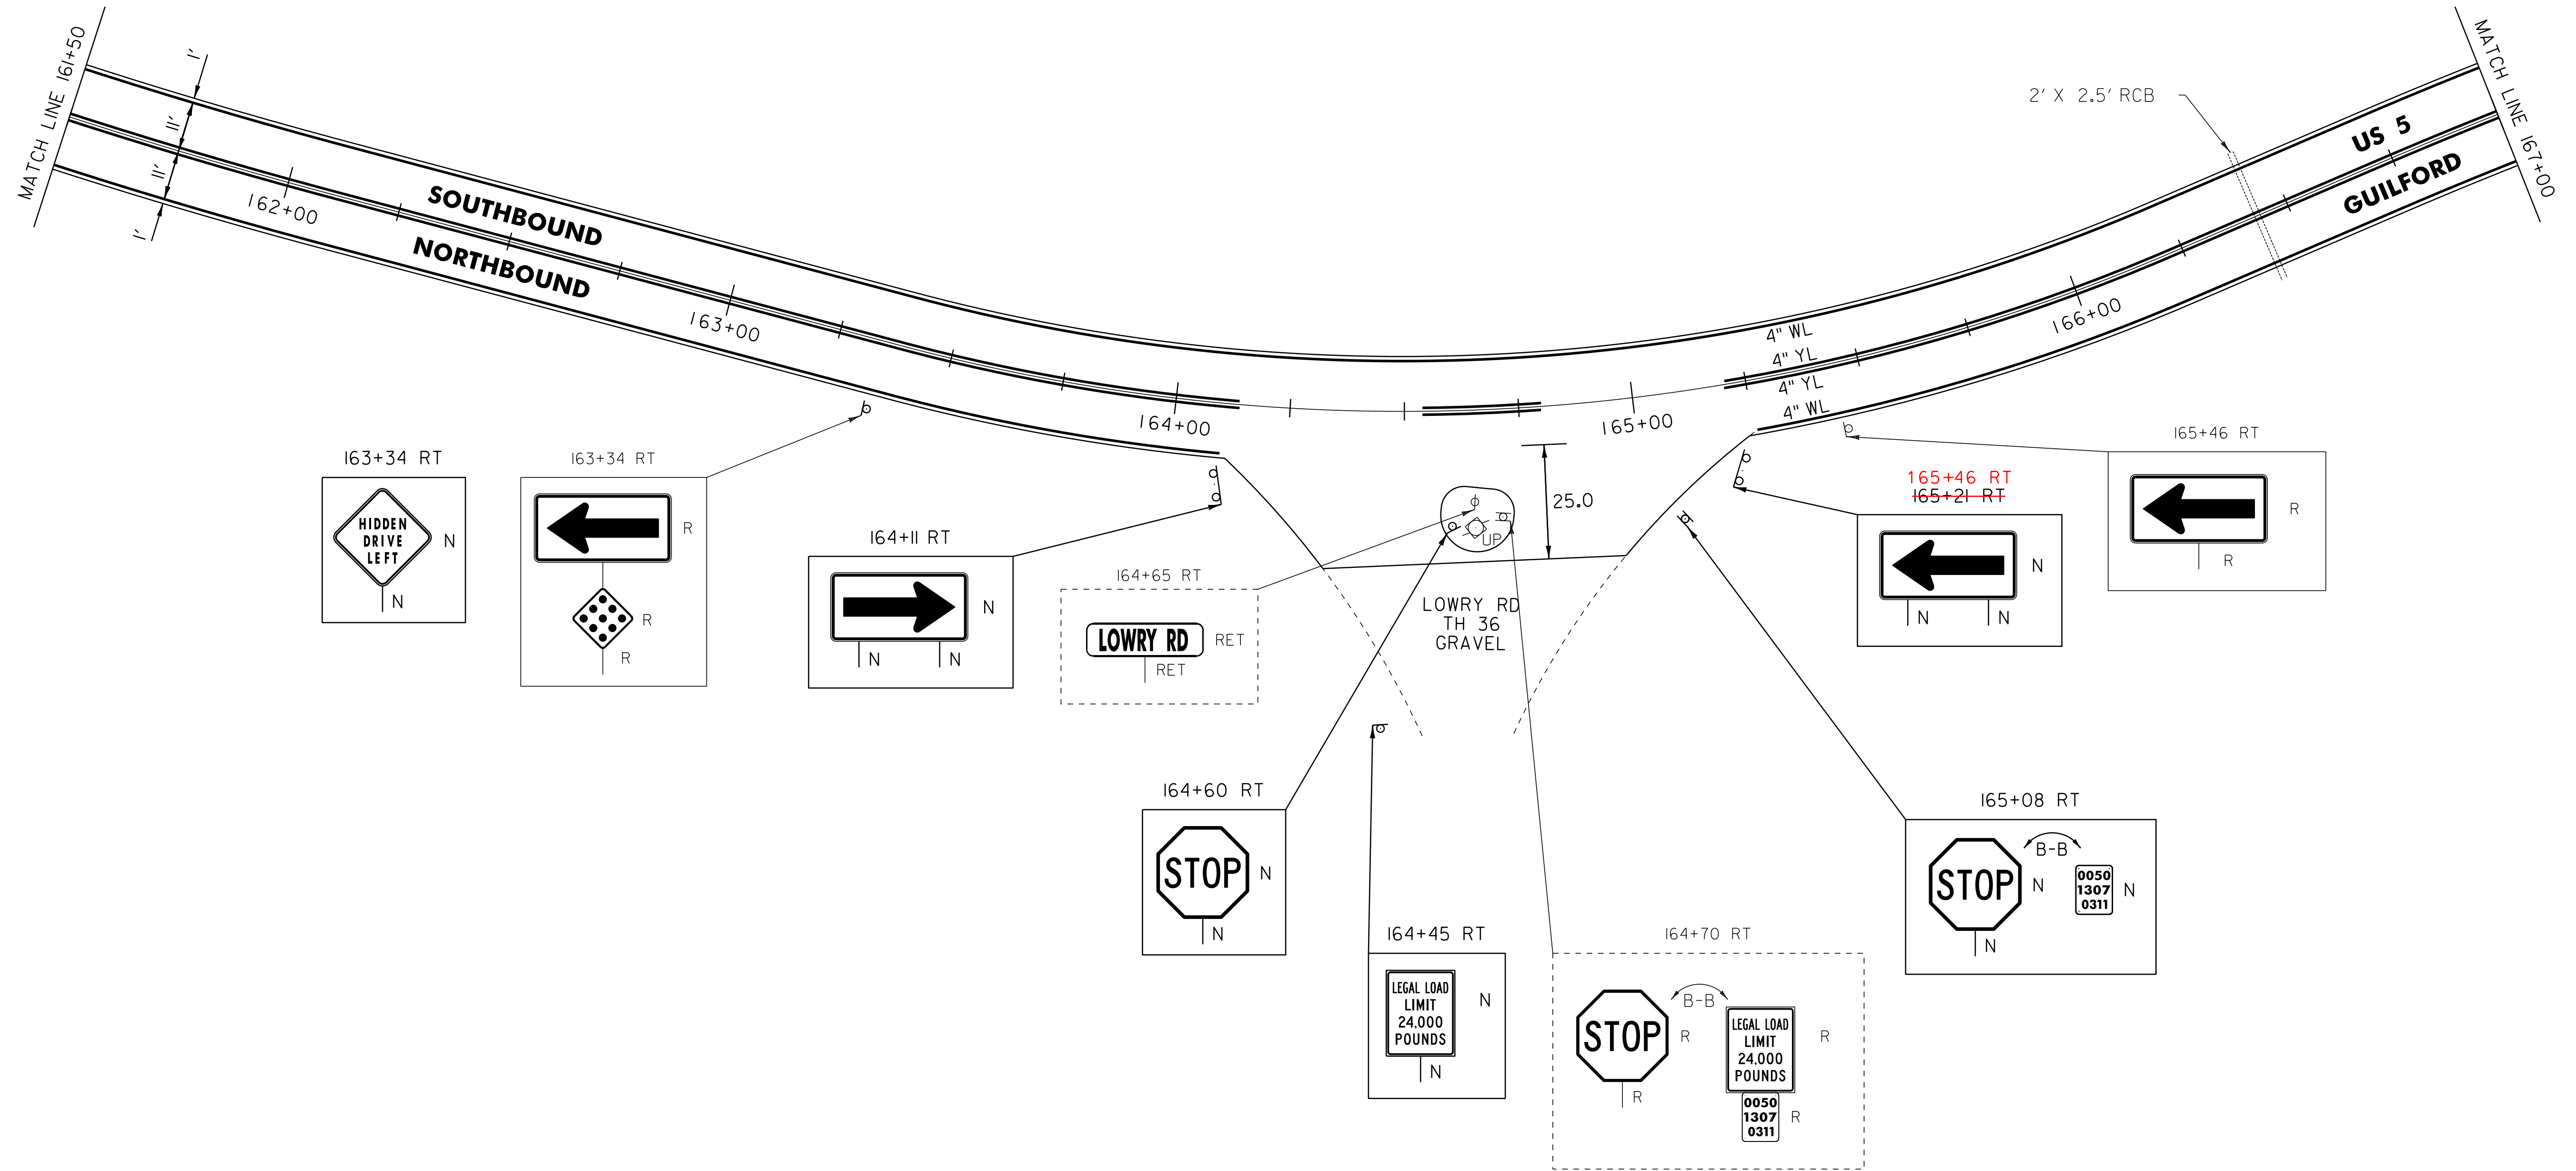

- LEGEND**
- R = REMOVE EXISTING
 - S = SALVAGE
 - R&S = REMOVE AND SALVAGE
 - N = NEW
 - RET = RETAIN
 - B-B = BACK TO BACK
 - = EXISTING GUARDRAIL
 - = PROPOSED GUARDRAIL
 - YL = YELLOW LINE
 - WL = WHITE LINE
 - = DELINEATOR

ROADWAY LAYOUT 18

PROJECT NAME: GUILFORD-BRATTLEBORO	
PROJECT NUMBER: STP 2707(1)	
FILE NAME: /pave/07cl66/pcl66	PLOT DATE: 29-JAN-2013 11:41
PROJECT LEADER: PTS	DRAWN BY: WWG
DESIGNED BY: NLL	CHECKED BY: NLL/PTS
IPARM FILE NAME: 07CI66.37	SHEET 37 OF 97

NOT TO SCALE