

646.602 TEMPORARY 4" WHITE LINE, PAINT  
 646.402 DURABLE 4" WHITE LINE, THERMOPLASTIC  
 222+00 TO 227+00 SOLID LT  
 222+00 TO 224+70 SOLID RT  
 224+70 TO 225+00 SOLID RT ( TH 3)  
 225+24 TO 225+54 SOLID RT ( TH 3)  
 225+54 TO 227+00 SOLID RT

646.612 TEMPORARY 4" YELLOW LINE, PAINT  
 646.412 DURABLE 4" YELLOW LINE, THERMOPLASTIC  
 222+00 TO 224+87 SOLID LT & RT  
 225+12 DOUBLE SOLID RT ( TH 3)  
 225+27 TO 227+00 SOLID LT & RT

646.682 TEMPORARY 24" STOP BAR, PAINT  
 646.482 DURABLE 24" STOP BAR, THERMOPLASTIC  
 225+13 TO 225+36 RT ( TH 3)

646.692 TEMPORARY LETTER OR SYMBOL, PAINT  
 646.492 DURABLE LETTER OR SYMBOL, THERMOPLASTIC  
 225+19 RT - STOP ( TH 3)

621.20 STEEL BEAM GUARDRAIL, GALVANIZED  
 222+00 TO 224+74 RT ( ENDS ON TH 3)

621.60 ANCHOR FOR STEEL BEAM RAIL  
 224+44 RT  
 224+74 RT ( TH 3)

621.80 REMOVAL AND DISPOSAL OF GUARDRAIL  
 222+00 TO 224+74 RT

676.12 REMOVAL OF EXISTING DELINEATOR  
 226+04 LT ( 1 SIGN POST)

900.620 SPECIAL PROVISION  
 (DELINEATOR WITH STEEL POST)  
 224+50 RT

BITUMINIOUS GUTTER


225+35 RT

225+50 LT

675.50 REMOVING SIGNS  
 AS SHOWN - 7

675.60 ERECTING SALVAGED SIGNS  
 AS SHOWN - 4

226+04 LT SIGN MISSING  
 1 POST TO BE REMOVED  
 USING ITEM 676.12,  
 REMOVAL OF  
 EXISTING DELINEATOR.

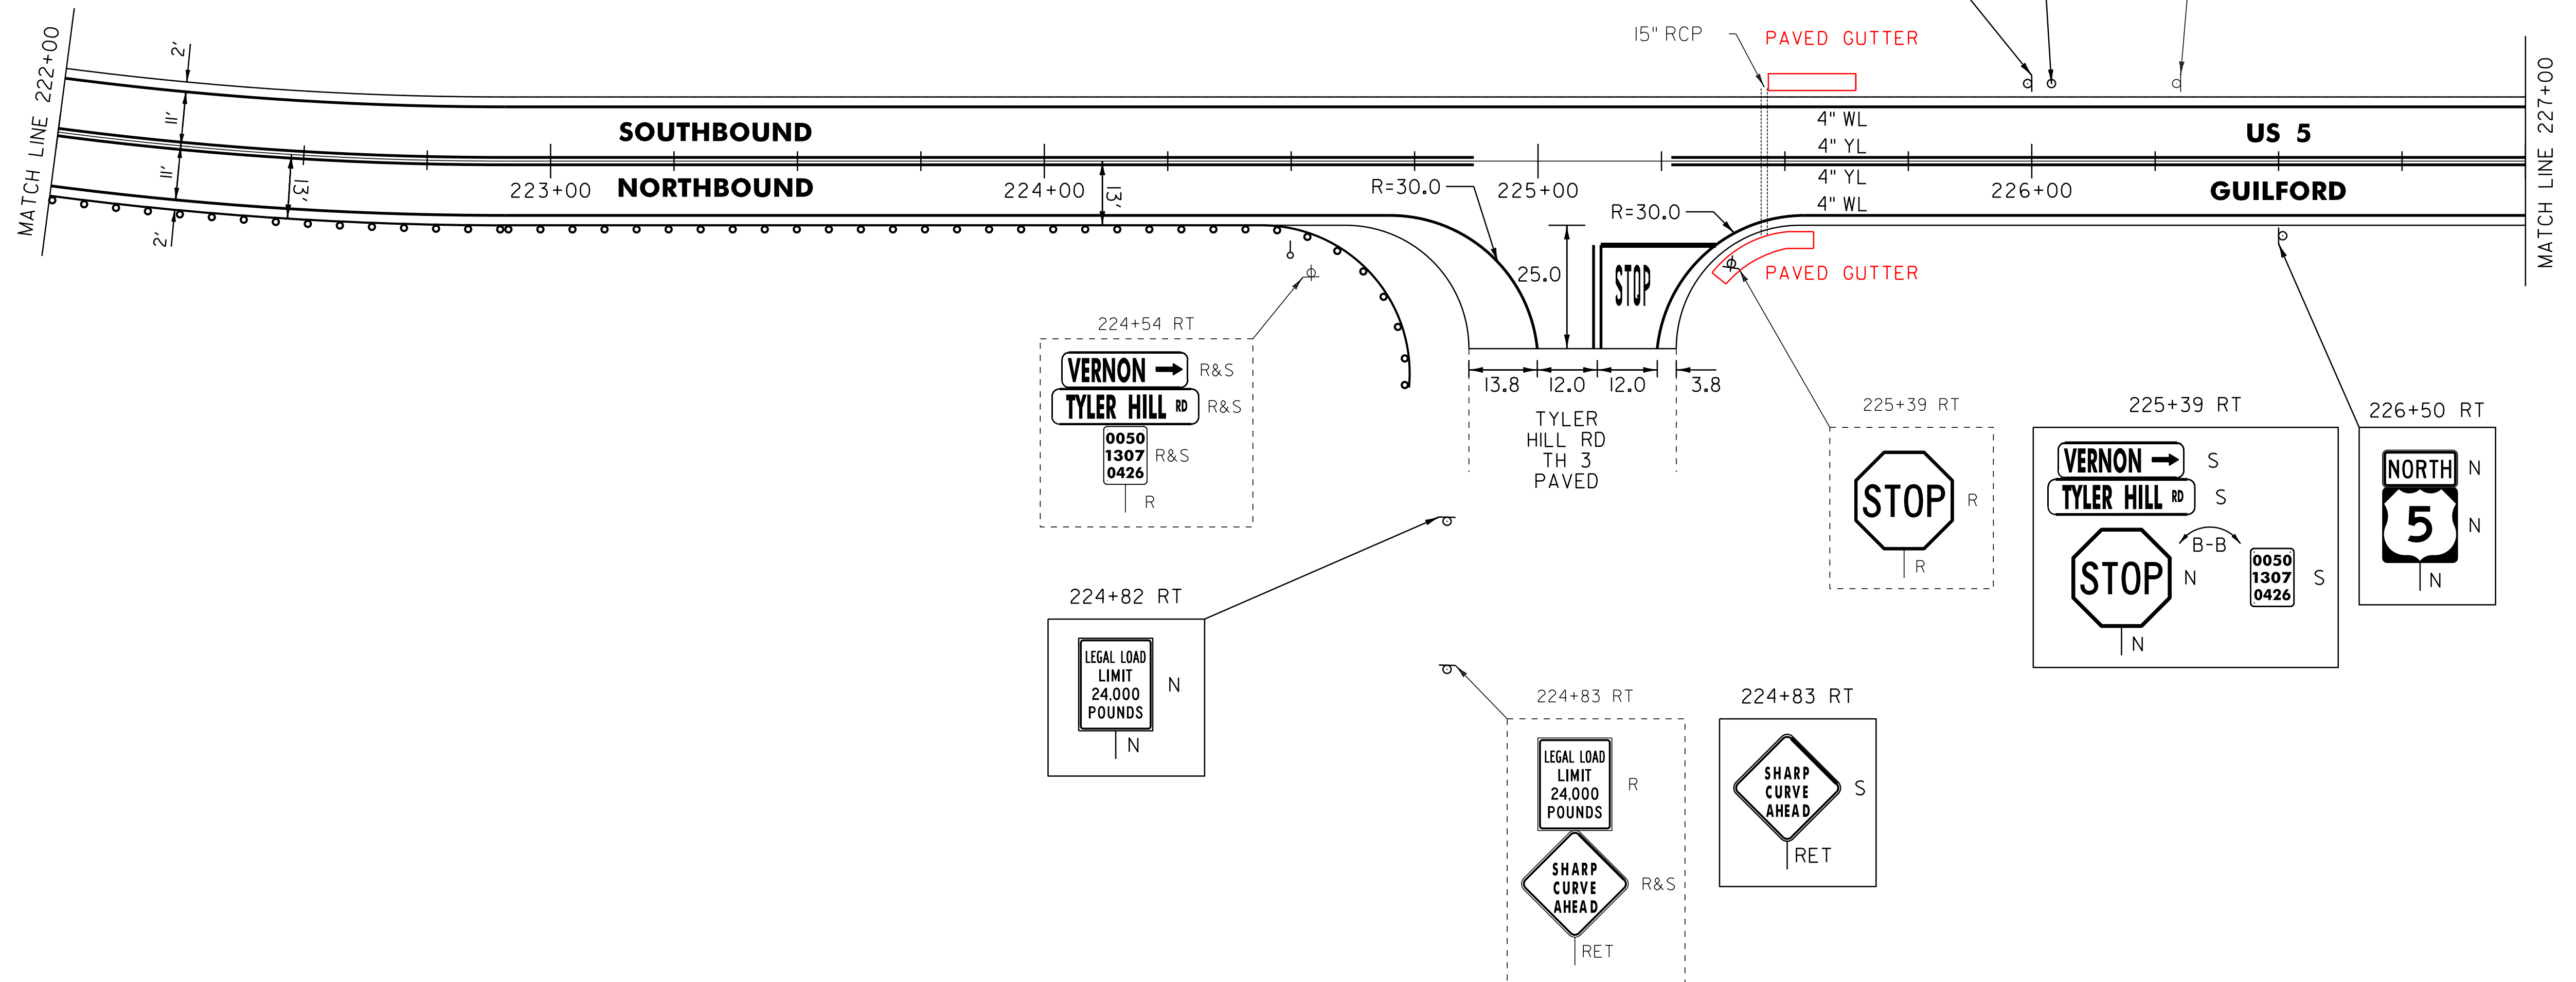

- LEGEND**
- R = REMOVE EXISTING
  - S = SALVAGE
  - R&S = REMOVE AND SALVAGE
  - N = NEW
  - RET = RETAIN
  - B-B = BACK TO BACK
  - = EXISTING GUARDRAIL
  - = PROPOSED GUARDRAIL
  - YL = YELLOW LINE
  - WL = WHITE LINE
  - = DELINEATOR

NOT TO SCALE

**ROADWAY LAYOUT 26**

PROJECT NAME: GUILFORD-BRATTLEBORO	
PROJECT NUMBER: STP 2707(1)	
FILE NAME: /pave/07cl66/pcl66	PLOT DATE: 29-JAN-2013 11:41
PROJECT LEADER: PTS	DRAWN BY: WWG
DESIGNED BY: NLL	CHECKED BY: NLL/PTS
IPARM FILE NAME: 07Cl66_45	SHEET 45 OF 97