

646.602 TEMPORARY 4" WHITE LINE, PAINT  
 646.402 DURABLE 4" WHITE LINE, THERMOPLASTIC  
 V 1+50 TO G 259+00 SOLID LT  
 V 1+50 TO G 259+00 SOLID RT

646.612 TEMPORARY 4" YELLOW LINE, PAINT  
 646.412 DURABLE 4" YELLOW LINE, THERMOPLASTIC  
 V 1+50 TO G 259+00 SOLID LT & RT

~~621.205 STEEL BEAM GUARDRAIL~~  
~~GALVANIZED W/8' POSTS~~  
~~V 1+50 TO 2+30.5 RT~~

621.50 MANUFACTURED  
 TERMINAL SECTION, FLARED  
 V ~~2+30.5~~ TO V ~~2+68~~ RT  
 1+37.5 1+75






621.80 REMOVAL AND DISPOSAL OF GUARDRAIL  
 V 1+50 TO V ~~2+64~~ RT  
 V 04+84 - G 259+00 RT

900.620 SPECIAL PROVISION  
 (DELINEATOR WITH STEEL POST)  
 V 2+68 RT  
 V 4+54 RT

675.50 REMOVING SIGNS  
 AS SHOWN - 6

675.60 ERECTING SALVAGED SIGNS  
 AS SHOWN - 1

621.20 STEEL BEAM GUARDRAIL  
 V 64+84 - G 259+00 RT

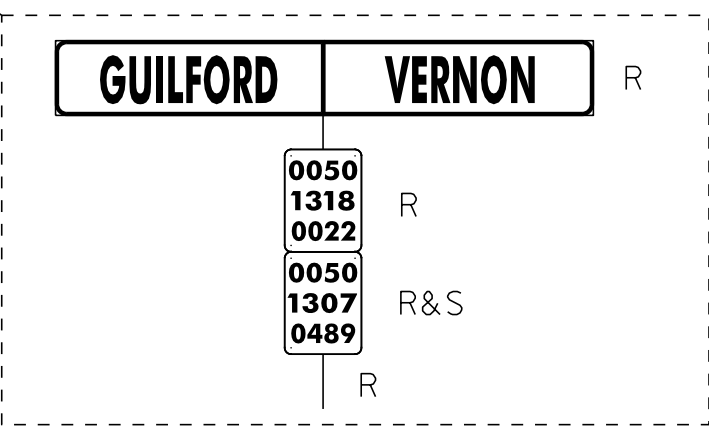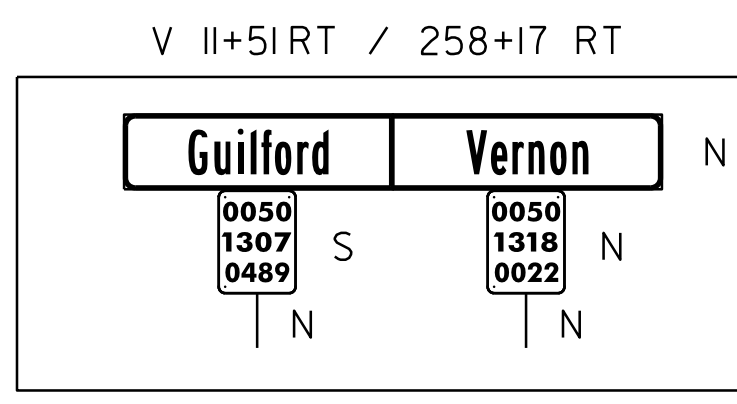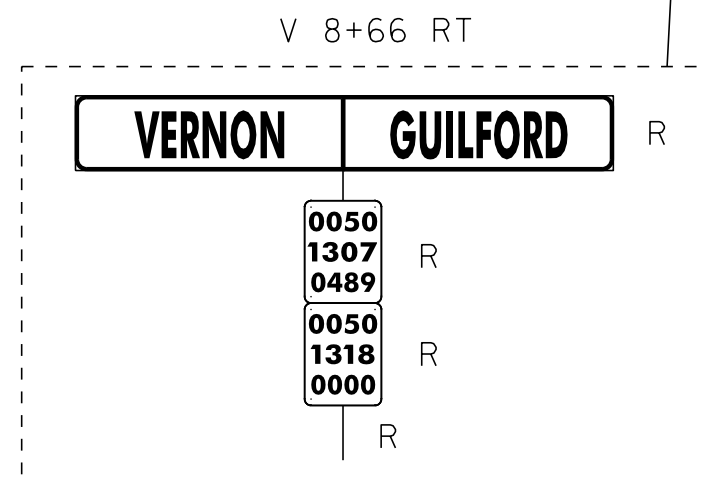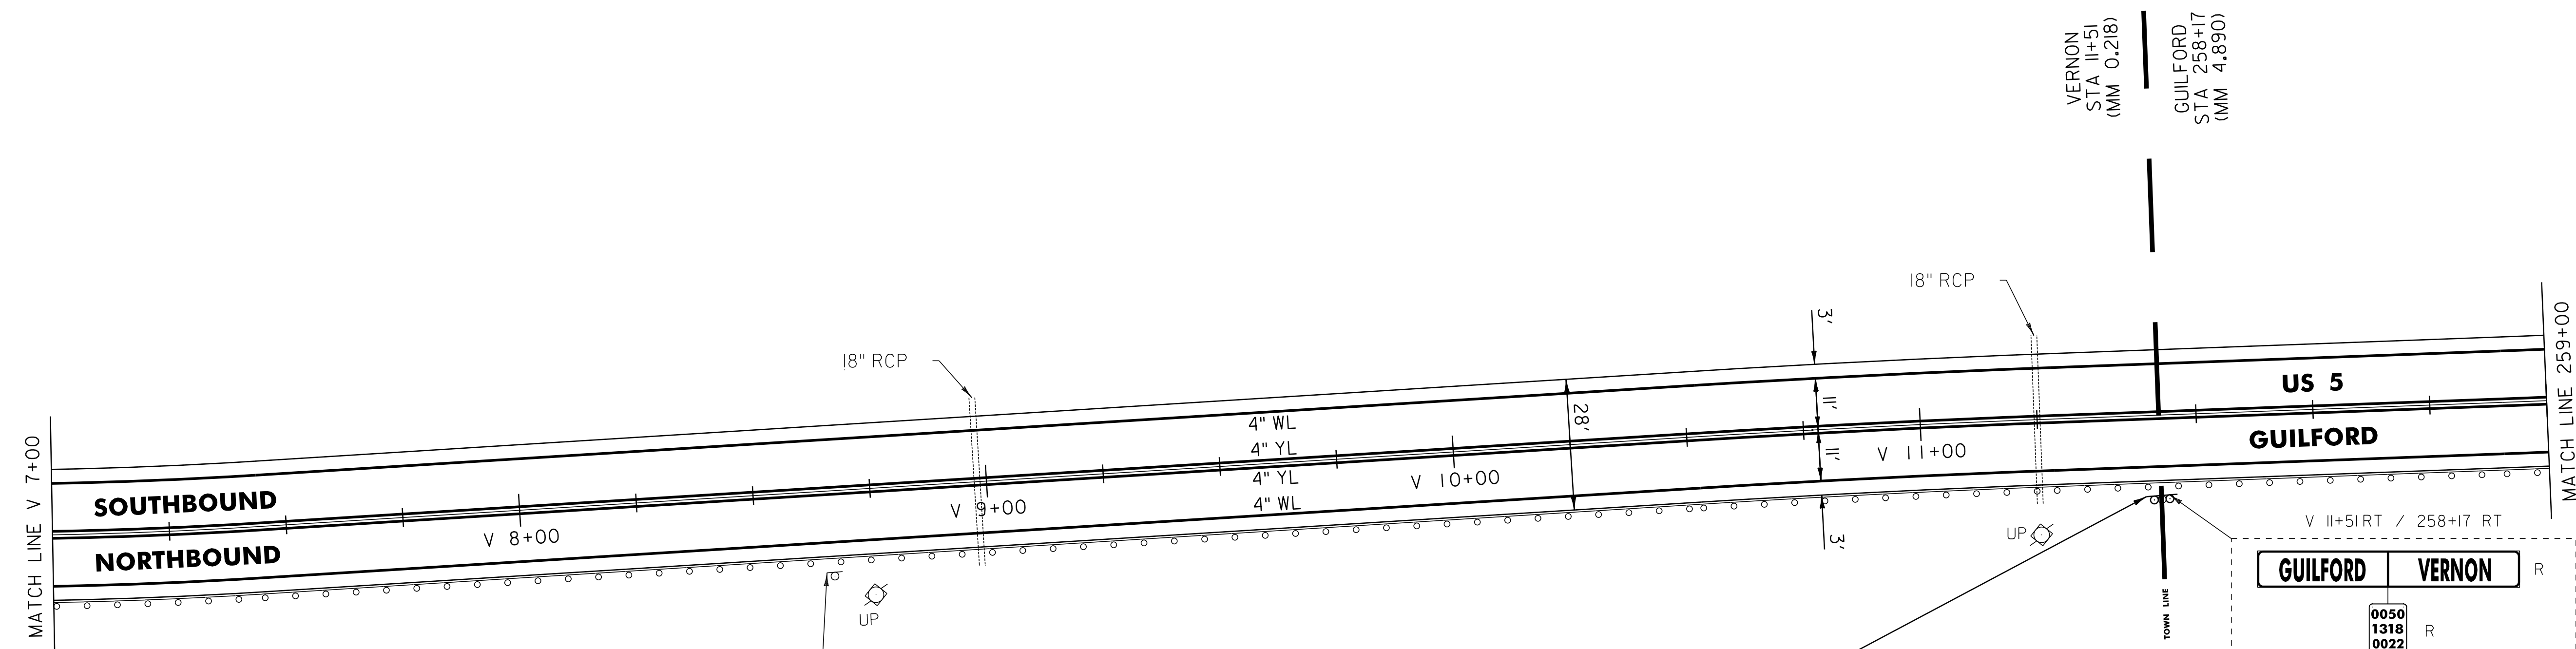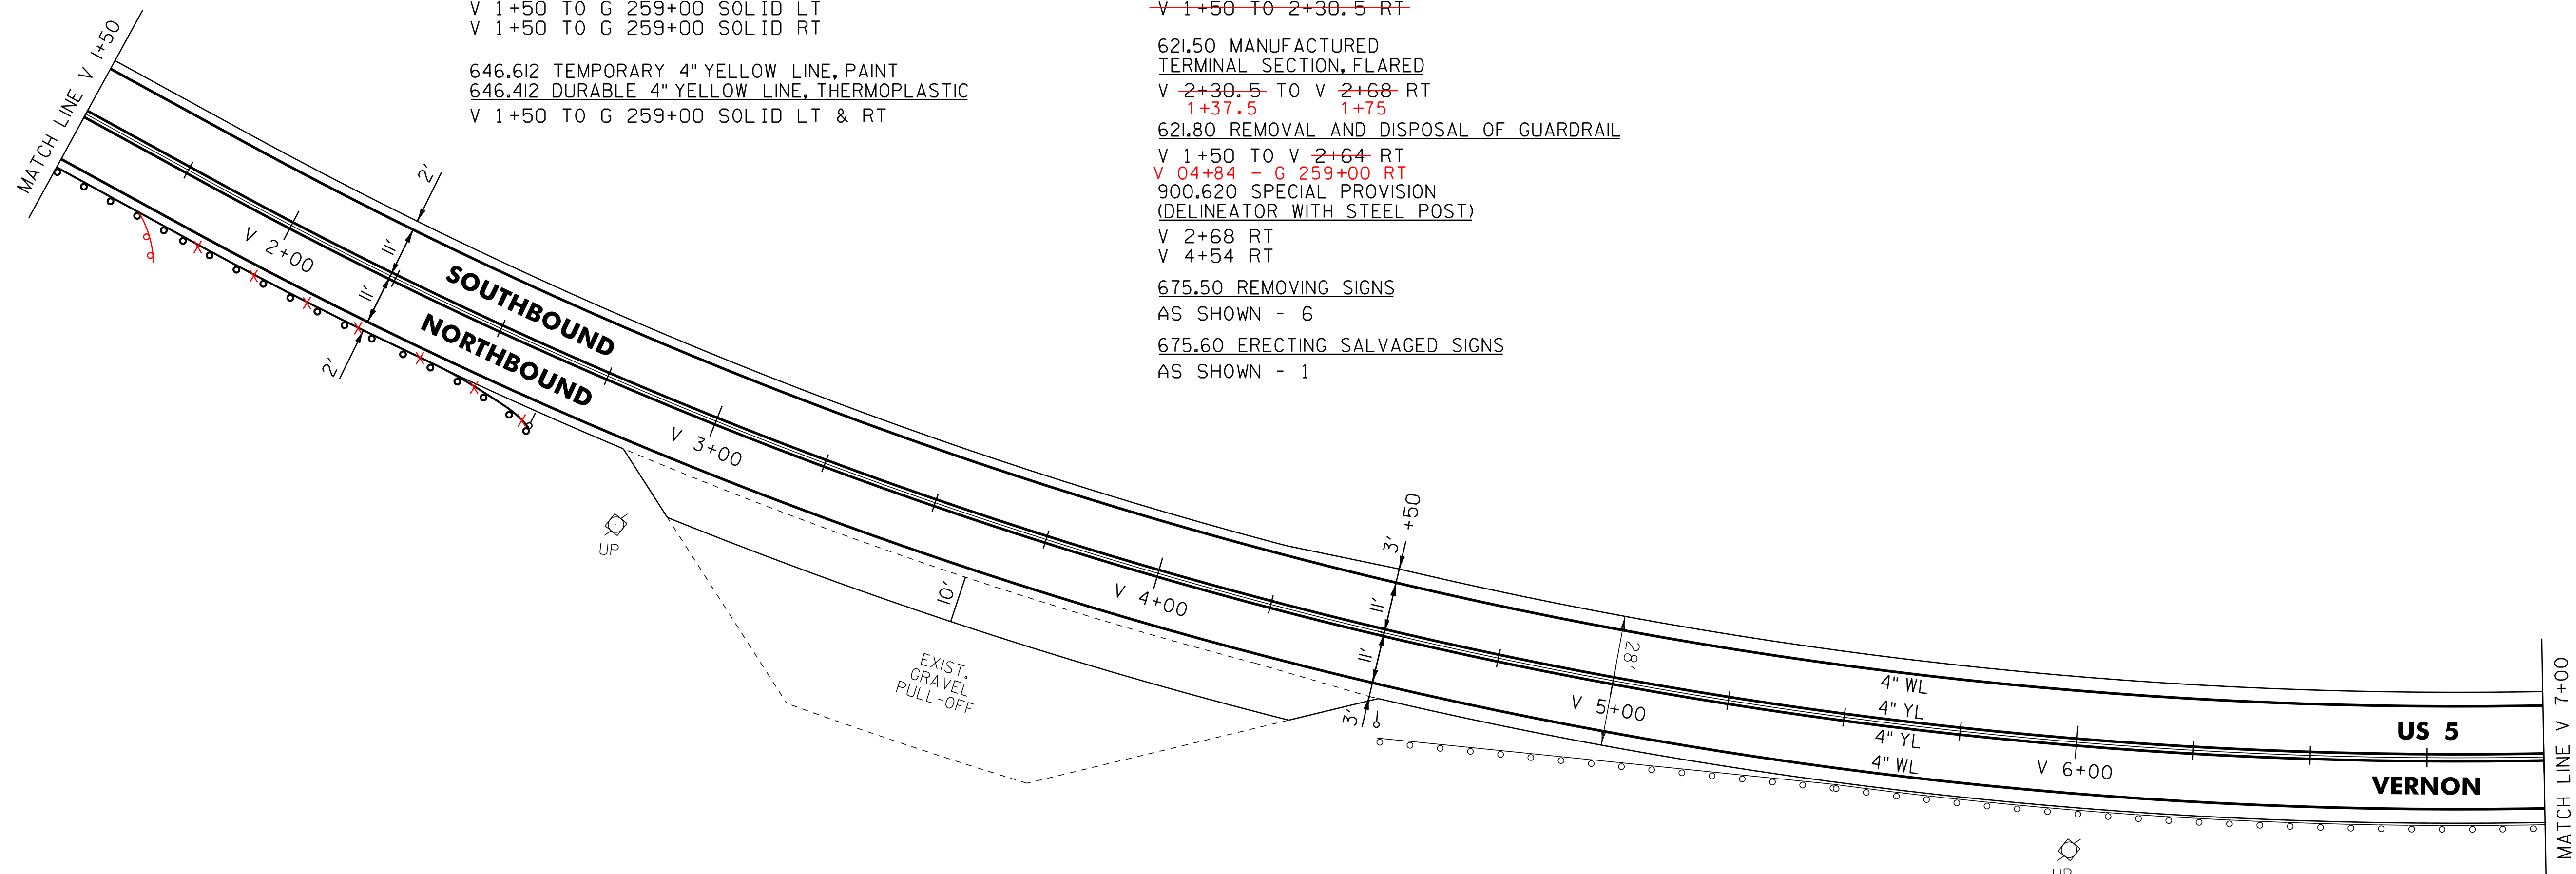

- LEGEND**
- R = REMOVE EXISTING
  - S = SALVAGE
  - R&S = REMOVE AND SALVAGE
  - N = NEW
  - RET = RETAIN
  - B-B = BACK TO BACK
  - = EXISTING GUARDRAIL
  - = PROPOSED GUARDRAIL
  - YL = YELLOW LINE
  - WL = WHITE LINE
  - = DELINEATOR

**ROADWAY LAYOUT 30**

PROJECT NAME: GUILFORD-BRATTLEBORO	PLOT DATE: 29-JAN-2013 11:41
PROJECT NUMBER: STP 2707(1)	DRAWN BY: WWG
FILE NAME: /pave/07cl66/pcl66	CHECKED BY: NLL/PTS
PROJECT LEADER: PTS	SHEET 49 OF 97
DESIGNED BY: NLL	
IPARM FILE NAME: 07Cl66_49	

NOT TO SCALE