

646.602 TEMPORARY 4" WHITE LINE, PAINT
 646.402 DURABLE 4" WHITE LINE, THERMOPLASTIC
 259+00 TO 270+00 SOLID LT
 259+00 TO 270+00 SOLID RT






646.612 TEMPORARY 4" YELLOW LINE, PAINT
 646.412 DURABLE 4" YELLOW LINE, THERMOPLASTIC
 259+00 TO 270+00 SOLID LT & RT

621.50 MANUFACTURED
 TERMINAL SECTION, FLARED
 266+98.5 TO 267+36 RT

621.80 REMOVAL AND DISPOSAL OF GUARDRAIL
~~266+98.5~~ TO 267+36 RT
 359+00
 900.620 SPECIAL PROVISION
 (DELINEATOR WITH STEEL POST)
 267+36 RT

675.50 REMOVING SIGNS
 AS SHOWN - 2

621.20 STEEL BEAM GUARDRAIL
 259+00 - 266+98.5 RT

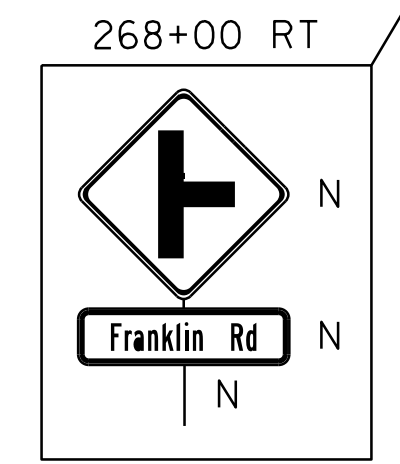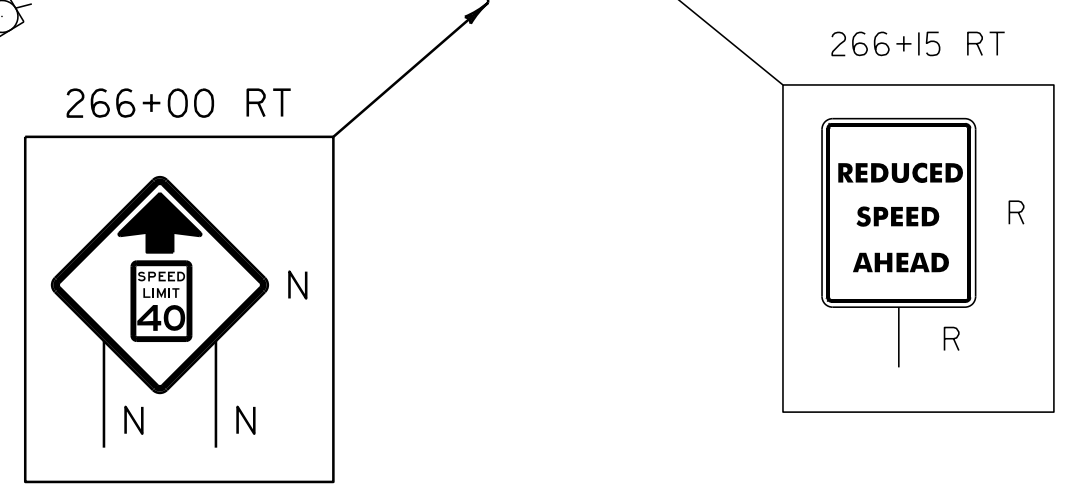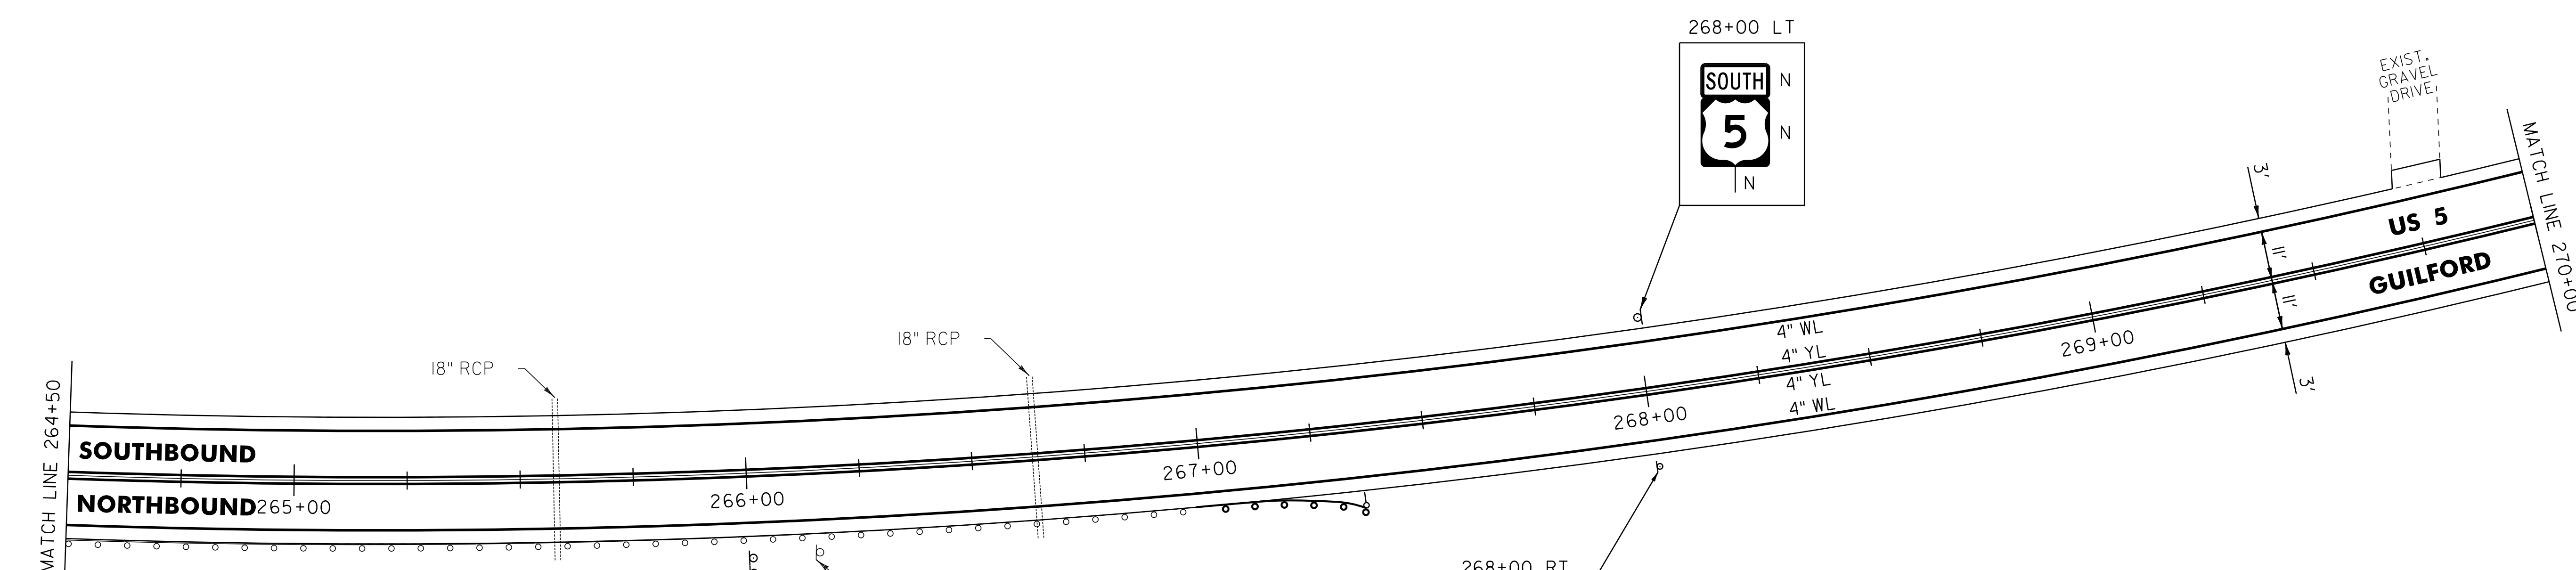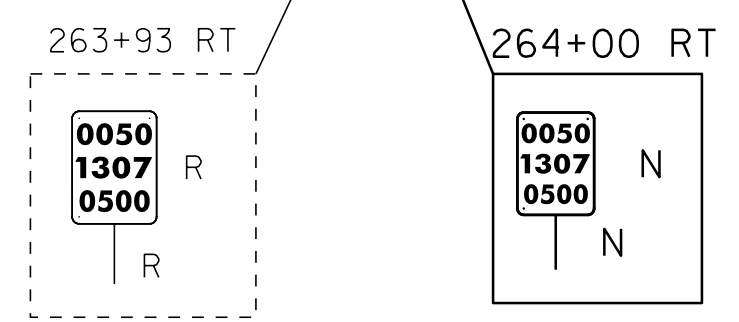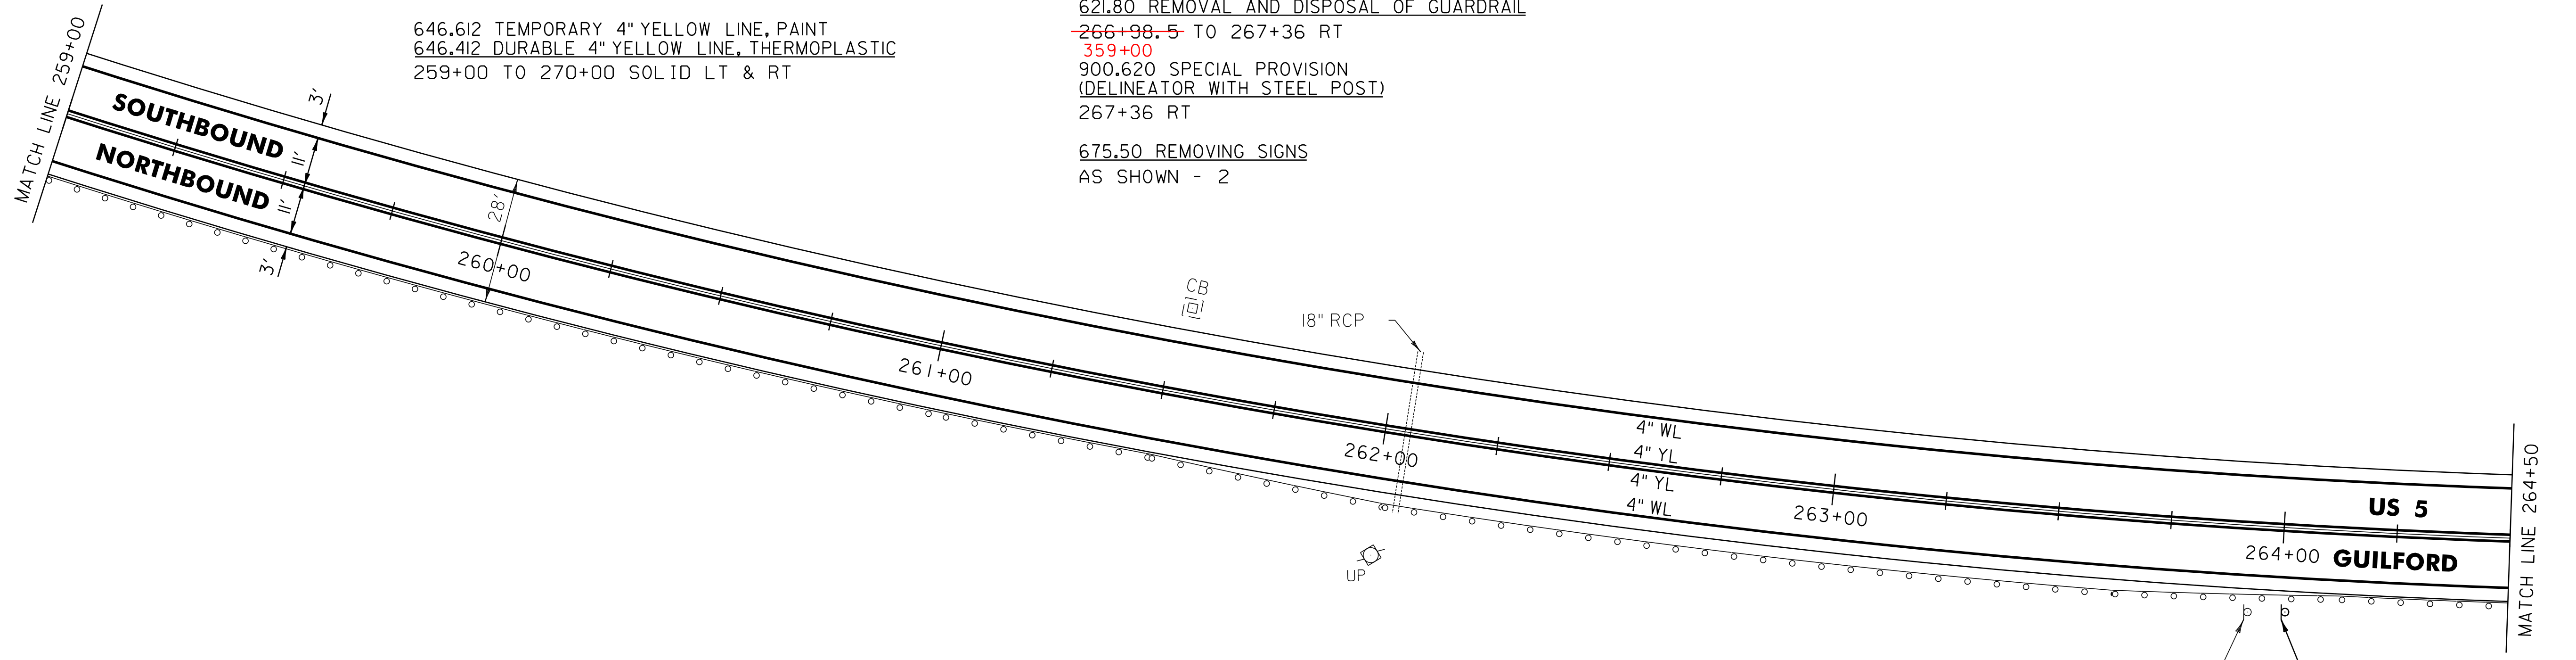

- LEGEND**
- R = REMOVE EXISTING
 - S = SALVAGE
 - R&S = REMOVE AND SALVAGE
 - N = NEW
 - RET = RETAIN
 - B-B = BACK TO BACK
 - = EXISTING GUARDRAIL
 - = PROPOSED GUARDRAIL
 - YL = YELLOW LINE
 - WL = WHITE LINE
 - = DELINEATOR

ROADWAY LAYOUT 31

PROJECT NAME: GUILFORD-BRATTLEBORO	PLOT DATE: 29-JAN-2013 11:41
PROJECT NUMBER: STP 2707(1)	DRAWN BY: WWG
FILE NAME: /pave/07cl66/pcl66	CHECKED BY: NLL/PTS
PROJECT LEADER: PTS	SHEET 50 OF 97
DESIGNED BY: NLL	
IPARM FILE NAME: 07Cl66.50	

NOT TO SCALE