

646.602 TEMPORARY 4" WHITE LINE, PAINT
 646.402 DURABLE 4" WHITE LINE, THERMOPLASTIC
 324+00 TO 325+77 SOLID LT
 324+00 TO 325+95 SOLID RT
 325+77 TO 326+10 SOLID LT (TH 28)
 326+44 TO 326+72 SOLID LT (TH 28)
 326+72 TO 328+11 SOLID LT
 326+79 TO 328+24 SOLID RT
 328+24 TO 328+28 SOLID RT (TH 65)
 328+48 TO 328+68 SOLID RT (TH 65)
 328+55 TO 329+00 SOLID LT
 328+68 TO 329+00 SOLID RT

646.612 TEMPORARY 4" YELLOW LINE, PAINT
 646.412 DURABLE 4" YELLOW LINE, THERMOPLASTIC
 324+00 TO 326+07 SOLID LT & RT
 326+27 DOUBLE SOLID LT (TH 28)
 326+59 TO 328+12 SOLID LT & RT
 328+38 TO 328+45 DOUBLE SOLID RT (TH 65)
 328+68 TO 329+00 SOLID LT & RT

646.682 TEMPORARY 24" STOP BAR, PAINT
 646.482 DURABLE 24" STOP BAR, THERMOPLASTIC
 325+99 TO 326+26 LT (TH 28)
 328+45 TO 328+55 RT (TH 65)

646.692 TEMPORARY LETTER OR SYMBOL, PAINT
 646.492 DURABLE LETTER OR SYMBOL, THERMOPLASTIC
 326+17 LT - STOP (TH 28)
 328+47 RT - STOP (TH 65)

604.42 CHANGING ELEVATION OF SEWER MANHOLES (NON PART.) (TO BE ADJUSTED BY OWNER)
 326+21 LT
 326+32 RT
 325+80 LT 328+40 RT
 621.53 TERMINAL CONNECTOR FOR STEEL BEAM GUARDRAIL
 327+32 RT
 327+32 LT
 327+86 LT
 327+98 RT


621.20 STEEL BEAM GUARDRAIL, GALVANIZED
 326+43 LT 327+07 RT 03
 326+55 TO 327+07 LT
 328+11 TO 328+18 LT
 328+23 TO 328+22 RT (ENDS ON TH 65)
 621.21 H.D. STEEL BEAM GUARDRAIL, GALVANIZED
 327+07 TO 327+32 RT
 327+07 TO 327+32 LT
 327+86 TO 328+11 LT 327+98.5
 327+98 TO 328+23 RT

621.80 REMOVAL AND DISPOSAL OF GUARDRAIL
 326+43 LT 327+32 RT
 326+63 TO 327+32 LT
 327+86 TO 328+18 LT
 327+98 TO 328+22 RT (ENDS ON TH 65)
 900.620 SPECIAL PROVISION (DELINEATOR WITH STEEL POST)
 326+55 LT
 328+18 LT

621.60 ANCHOR FOR STEEL BEAM RAIL
 326+55 LT
 326+82 RT
 328+18 LT
 328+22 RT (ON TH 65)
 328+23 RT

675.50 REMOVING SIGNS
 AS SHOWN - 28

675.60 ERECTING SALVAGED SIGNS
 AS SHOWN - 6

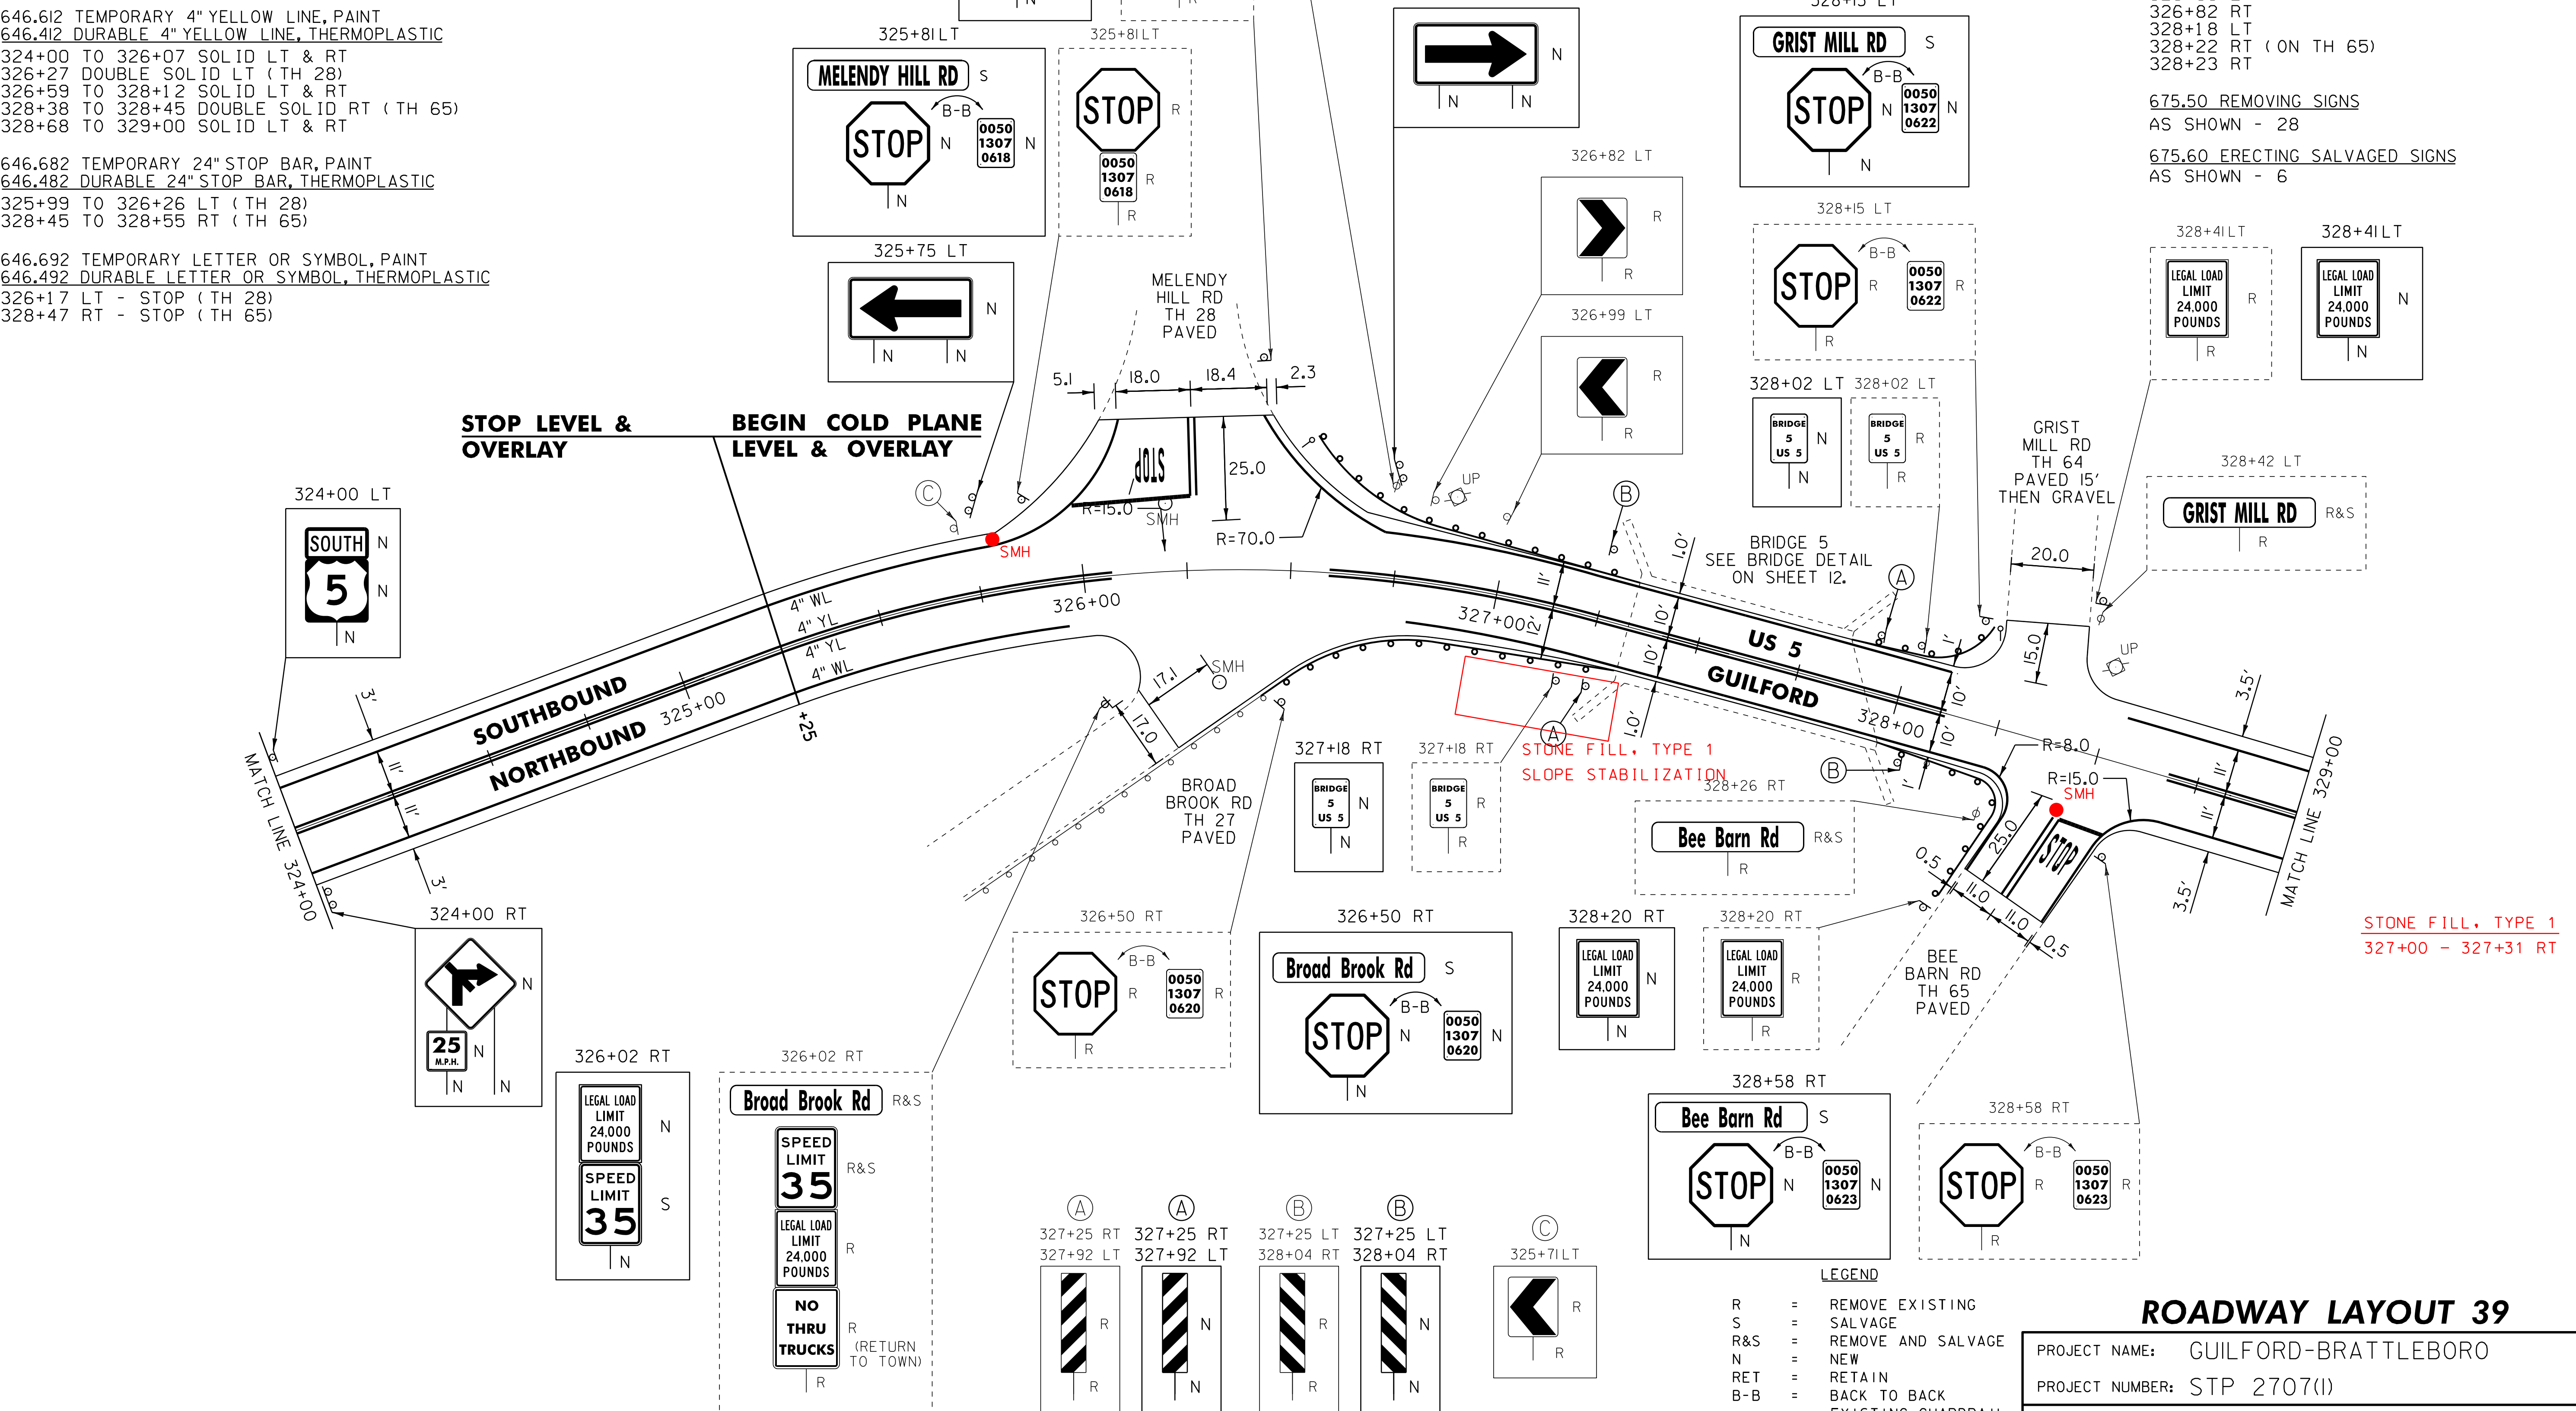

STONE FILL, TYPE 1
 327+00 - 327+31 RT

NOT TO SCALE

- LEGEND
- R = REMOVE EXISTING
 - S = SALVAGE
 - R&S = REMOVE AND SALVAGE
 - N = NEW
 - RET = RETAIN
 - B-B = BACK TO BACK
 - = EXISTING GUARDRAIL
 - = PROPOSED GUARDRAIL
 - YL = YELLOW LINE
 - WL = WHITE LINE
 - ⊙ = DELINEATOR

ROADWAY LAYOUT 39

PROJECT NAME:	GUILFORD-BRATTLEBORO	FILE NAME:	/pave/07cl66/pcl66	PLOT DATE:	29-JAN-2013 11:41
PROJECT NUMBER:	STP 2707(1)	PROJECT LEADER:	PTS	DRAWN BY:	WWG
		DESIGNED BY:	NLL	CHECKED BY:	NLL/PTS
		IPARM FILE NAME:	07C166.58		SHEET 58 OF 97