

646.602 TEMPORARY 4" WHITE LINE, PAINT  
 646.402 DURABLE 4" WHITE LINE, THERMOPLASTIC  
 329+00 TO 330+91 SOLID LT  
 329+00 TO 334+00 SOLID RT  
 330+91 TO 331+13 SOLID LT (TH 1)  
 331+46 TO 331+75 SOLID LT (TH 1)  
 331+75 TO 334+00 SOLID LT

646.612 TEMPORARY 4" YELLOW LINE, PAINT  
 646.412 DURABLE 4" YELLOW LINE, THERMOPLASTIC  
 329+00 TO 331+15 SOLID LT & RT  
 331+30 TO 331+35 DOUBLE SOLID LT (TH 1)  
 331+55 TO 334+00 SOLID LT & RT

646.682 TEMPORARY 24" STOP BAR, PAINT  
 646.482 DURABLE 24" STOP BAR, THERMOPLASTIC  
 331+08 TO 331+34 LT (TH 1)


646.692 TEMPORARY LETTER OR SYMBOL, PAINT  
 646.492 DURABLE LETTER OR SYMBOL, THERMOPLASTIC  
 331+23 LT - STOP (TH 1)

604.412, 604.415, 604.418 REHAB. DROP  
 INLETS, CATCH BASINS, OR MANHOLES,  
 CLASS I, CLASS II OR CLASS III  
 330+80 LT (CB)  
 331+54 LT (CB)  
 604.42 CHANGING ELEVATION OF  
 SEWER MANHOLES (NON PART.)  
 (TO BE ADJUSTED BY OWNER)  
 330+89 LT 329+90 RT 332+50 LT

675.50 REMOVING SIGNS  
 AS SHOWN - 22

675.60 ERECTING SALVAGED SIGNS  
 AS SHOWN - 2

BITUMINOUS GUTTER  
 329+50 LT  
 330+00 RT

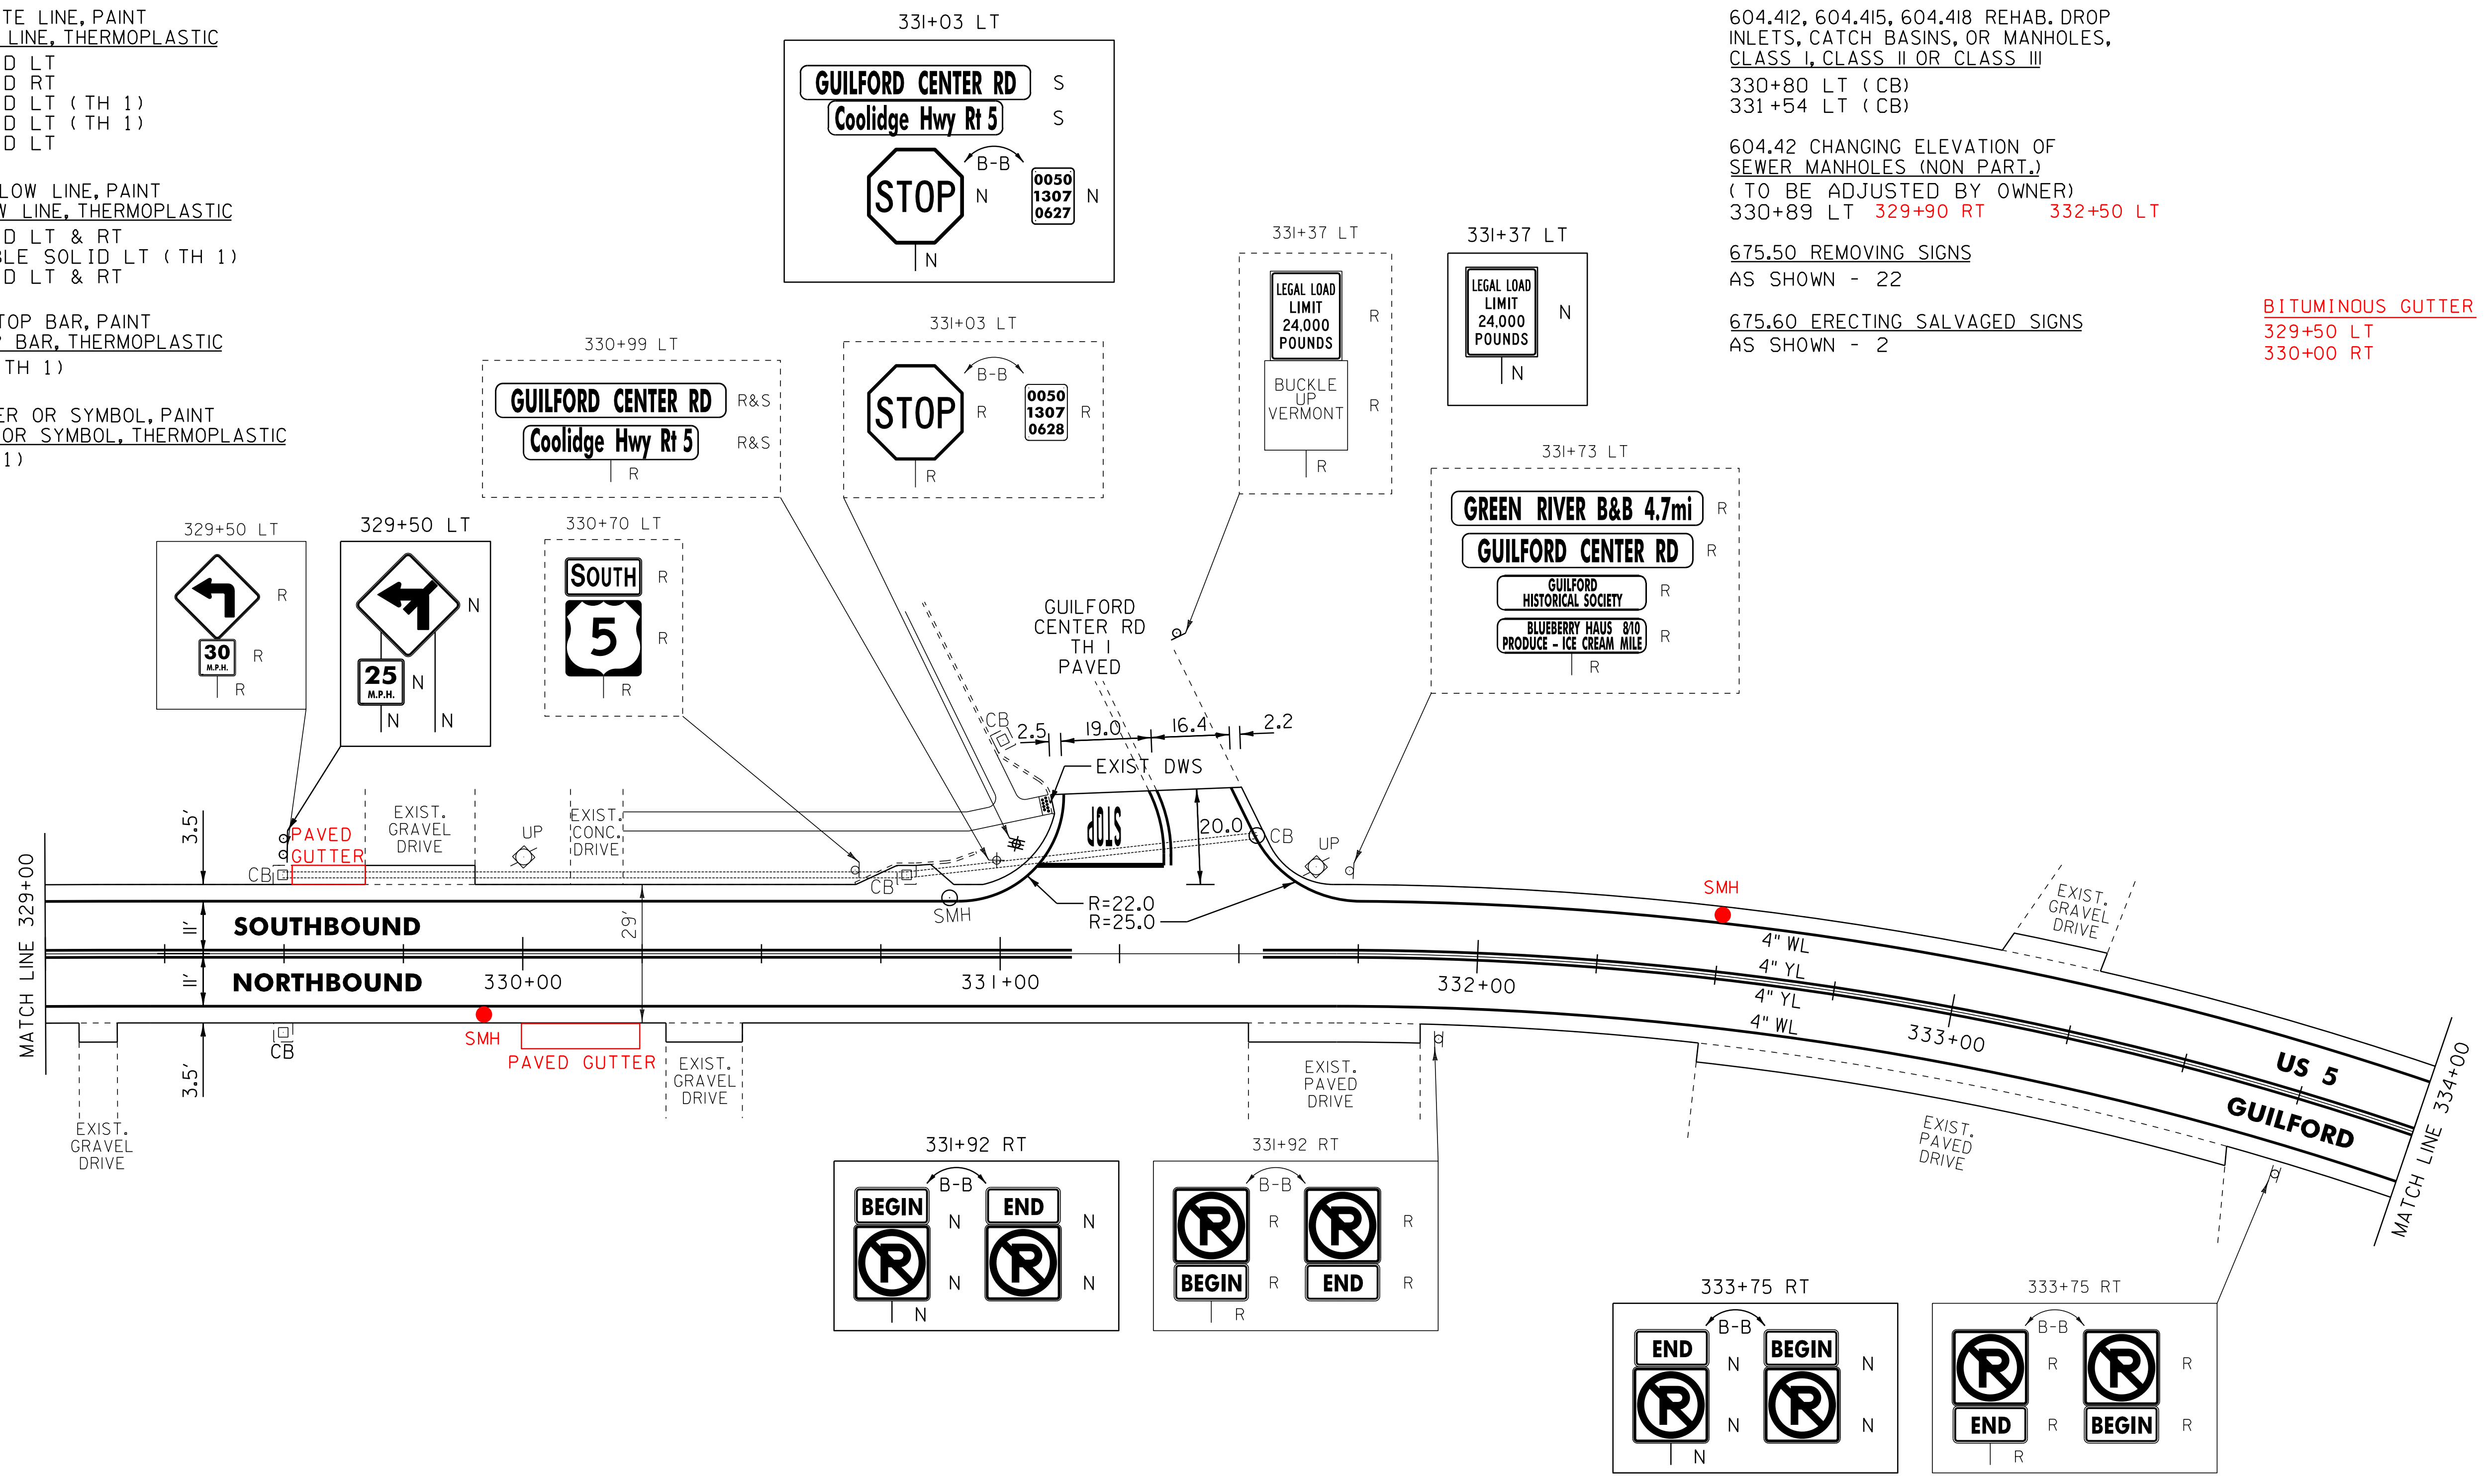

NOT TO SCALE

- LEGEND**
- R = REMOVE EXISTING
  - S = SALVAGE
  - R&S = REMOVE AND SALVAGE
  - N = NEW
  - RET = RETAIN
  - B-B = BACK TO BACK
  - = EXISTING GUARDRAIL
  - = PROPOSED GUARDRAIL
  - YL = YELLOW LINE
  - WL = WHITE LINE
  - = DELINEATOR

**ROADWAY LAYOUT 40**

PROJECT NAME: GUILFORD-BRATTLEBORO  
 PROJECT NUMBER: STP 2707(I)

FILE NAME: /pave/07cl66/pcl66  
 PROJECT LEADER: PTS  
 DESIGNED BY: NLL  
 IPARM FILE NAME: 07Cl66.59

PLOT DATE: 29-JAN-2013 11:41  
 DRAWN BY: WWG  
 CHECKED BY: NLL/PTS  
 SHEET 59 OF 97