

646.602 TEMPORARY 4" WHITE LINE, PAINT  
 646.402 DURABLE 4" WHITE LINE, THERMOPLASTIC  
 349+00 TO 352+45 SOLID LT  
 349+00 TO 354+50 SOLID RT  
 352+45 TO 352+76 SOLID LT (TH 74)  
 353+19 TO 353+43 SOLID LT (TH 74)  
 353+43 TO 354+50 SOLID LT

646.612 TEMPORARY 4" YELLOW LINE, PAINT  
 646.412 DURABLE 4" YELLOW LINE, THERMOPLASTIC  
 349+00 TO 352+74 SOLID LT & RT  
 352+94 DOUBLE SOLID LT (TH 74)  
 353+14 TO 354+50 SOLID LT & RT

646.682 TEMPORARY 24" STOP BAR, PAINT  
 646.482 DURABLE 24" STOP BAR, THERMOPLASTIC  
 352+65 TO 352+93 LT (TH 74)

646.692 TEMPORARY LETTER OR SYMBOL, PAINT  
 646.492 DURABLE LETTER OR SYMBOL, THERMOPLASTIC  
 352+83 LT - STOP (TH 49)


621.20 STEEL BEAM GUARDRAIL, GALVANIZED  
 351+43 TO 352+18 RT  
 351+81 TO 352+43.5 LT  
 621.80 REMOVAL AND DISPOSAL OF GUARDRAIL  
 351+81 TO 352+18 RT  
 351+81 TO 352+18 LT

621.60 ANCHOR FOR STEEL BEAM RAIL  
 351+43 RT  
 351+81 LT  
 352+18 RT  
 352+43.5 LT

900.620 SPECIAL PROVISION  
 (DELINEATOR WITH STEEL POST)  
 351+43 RT  
 351+81 LT  
 352+18 RT  
 352+43.5 LT

675.50 REMOVING SIGNS  
 AS SHOWN - 3

STONE  
 351+00 LT

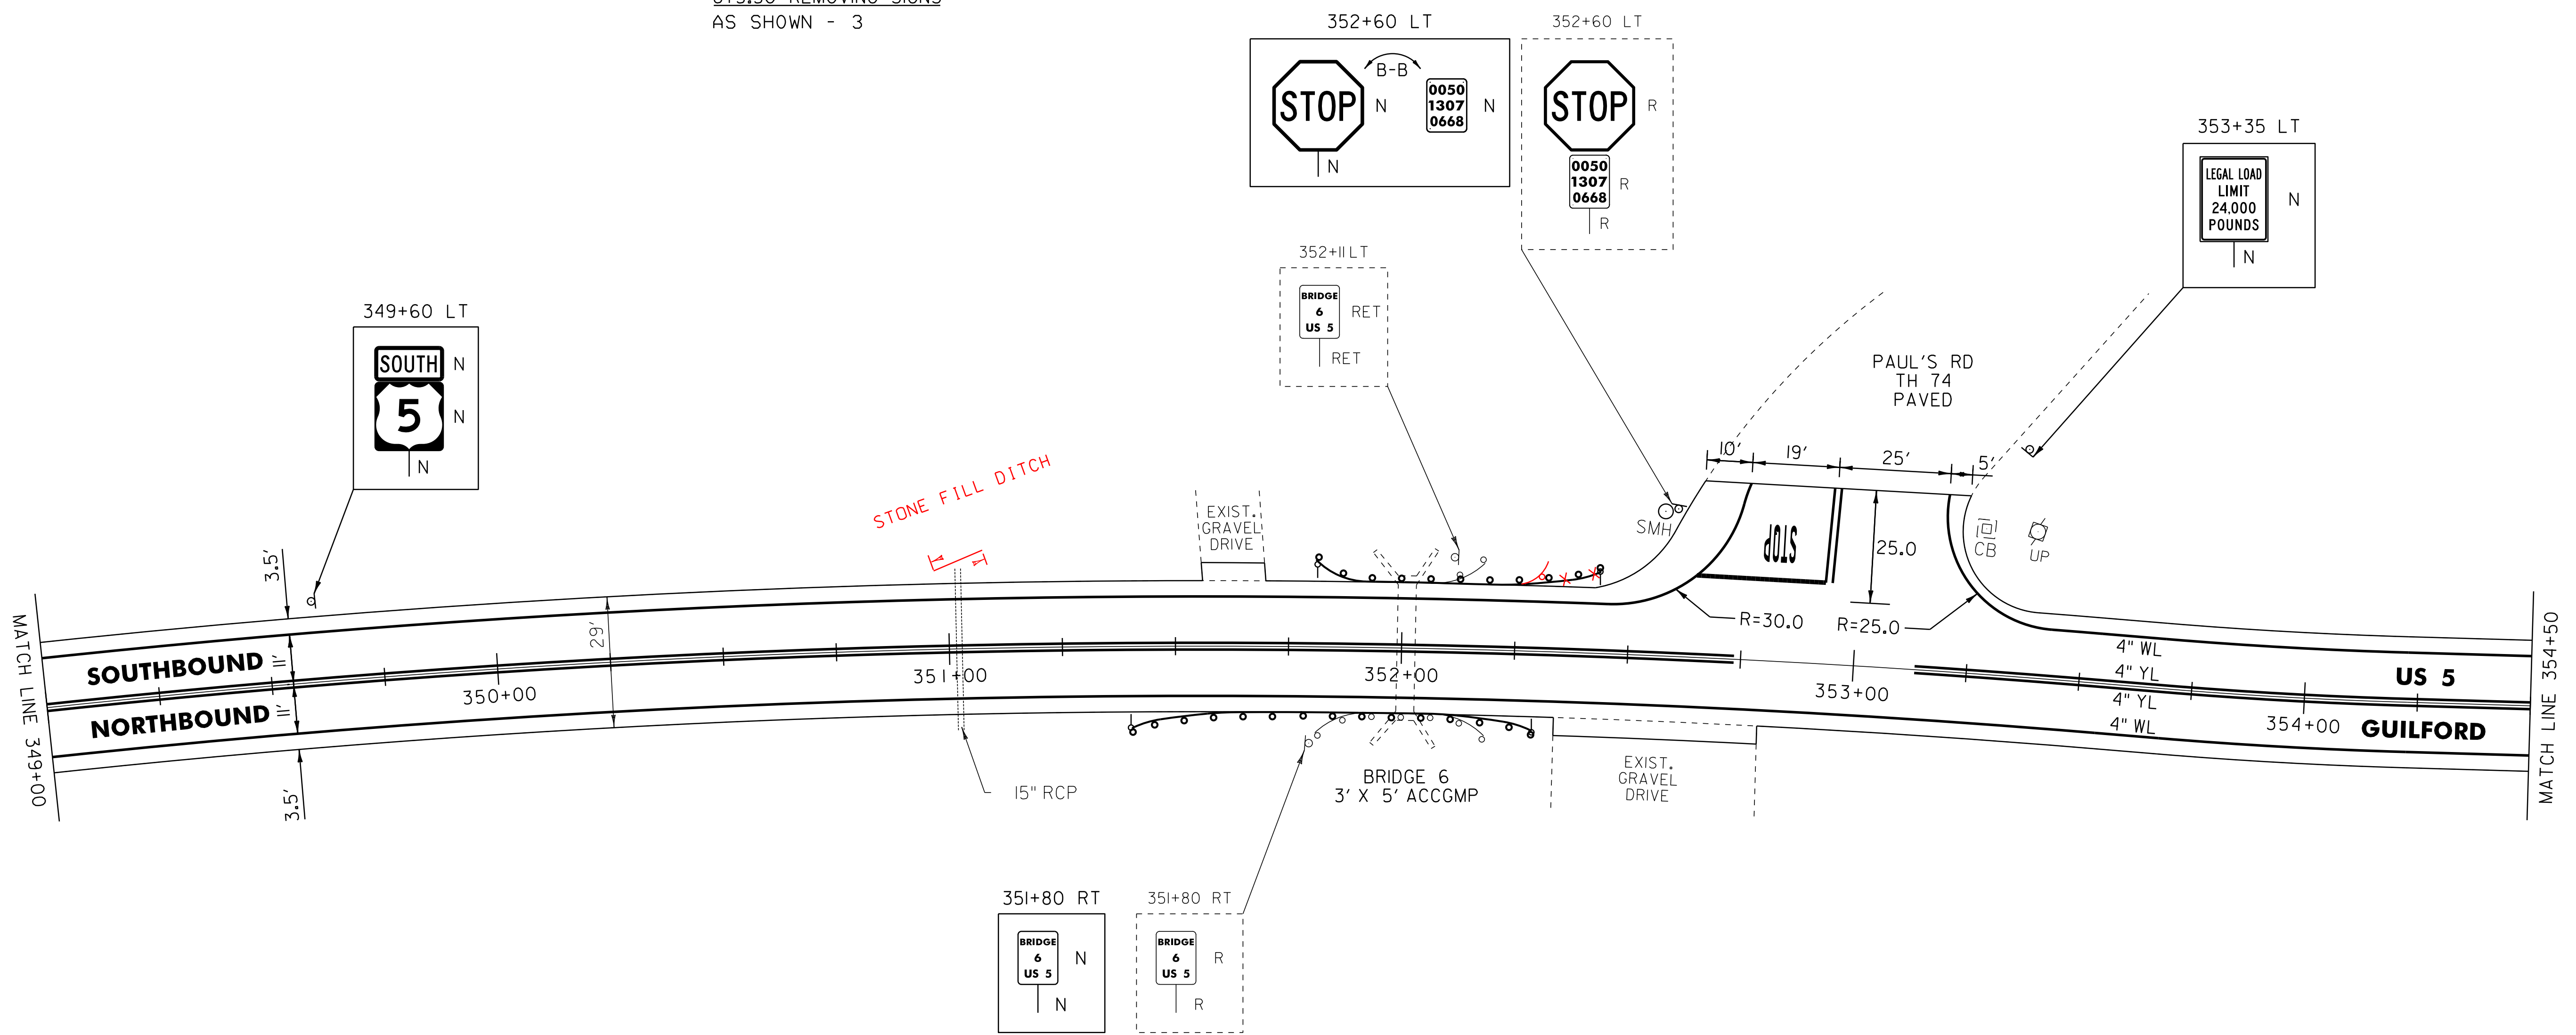

- LEGEND**
- R = REMOVE EXISTING
  - S = SALVAGE
  - R&S = REMOVE AND SALVAGE
  - N = NEW
  - RET = RETAIN
  - B-B = BACK TO BACK
  - = EXISTING GUARDRAIL
  - = PROPOSED GUARDRAIL
  - YL = YELLOW LINE
  - WL = WHITE LINE
  - = DELINEATOR

**ROADWAY LAYOUT 43**

PROJECT NAME: GUILFORD-BRATTLEBORO  
 PROJECT NUMBER: STP 2707(1)

FILE NAME: /pave/07cl66/pcl66  
 PROJECT LEADER: PTS  
 DESIGNED BY: NLL  
 IPARM FILE NAME: 07Cl66.62

PLOT DATE: 29-JAN-2013 11:42  
 DRAWN BY: WWG  
 CHECKED BY: NLL/PTS  
 SHEET 62 OF 97

NOT TO SCALE