


646.602 TEMPORARY 4" WHITE LINE, PAINT  
 646.402 DURABLE 4" WHITE LINE, THERMOPLASTIC  
 354+50 TO B 8+50 SOLID LT  
 354+50 TO B 8+50 SOLID RT

646.612 TEMPORARY 4" YELLOW LINE, PAINT  
 646.412 DURABLE 4" YELLOW LINE, THERMOPLASTIC  
 354+50 TO B 8+50 SOLID LT & RT

621.20 STEEL BEAM GUARDRAIL, GALVANIZED  
~~B 3+77 TO B 4+39.5 RT~~  
~~B 7+36 TO B 8+11 RT~~  
 B 04+12.5 TO B 08+12.5 RT  
 621.80 REMOVAL AND DISPOSAL OF GUARDRAIL  
~~B 3+77 TO B 4+39.5 RT~~ 8+12.5  
~~B 7+36 TO B 8+11 RT~~  
 621.60 ANCHOR FOR STEEL BEAM RAIL  
~~B 3+77 RT~~  
 B 8+11 RT  
 900.620 SPECIAL PROVISION  
 (DELINEATOR WITH STEEL POST)  
 B 3+77 RT  
 B 8+11 RT  
 675.50 REMOVING SIGNS  
 AS SHOWN - 5

621.50 MANUFACTURED TERMINAL SECTION FLARED  
 B 03+77 - 04+12.5  
 STONE FILL, TYPE 1  
 B 4+40 - 4+61 LT  
 BITUMINOUS GUTTER  
 B 8+25 RT

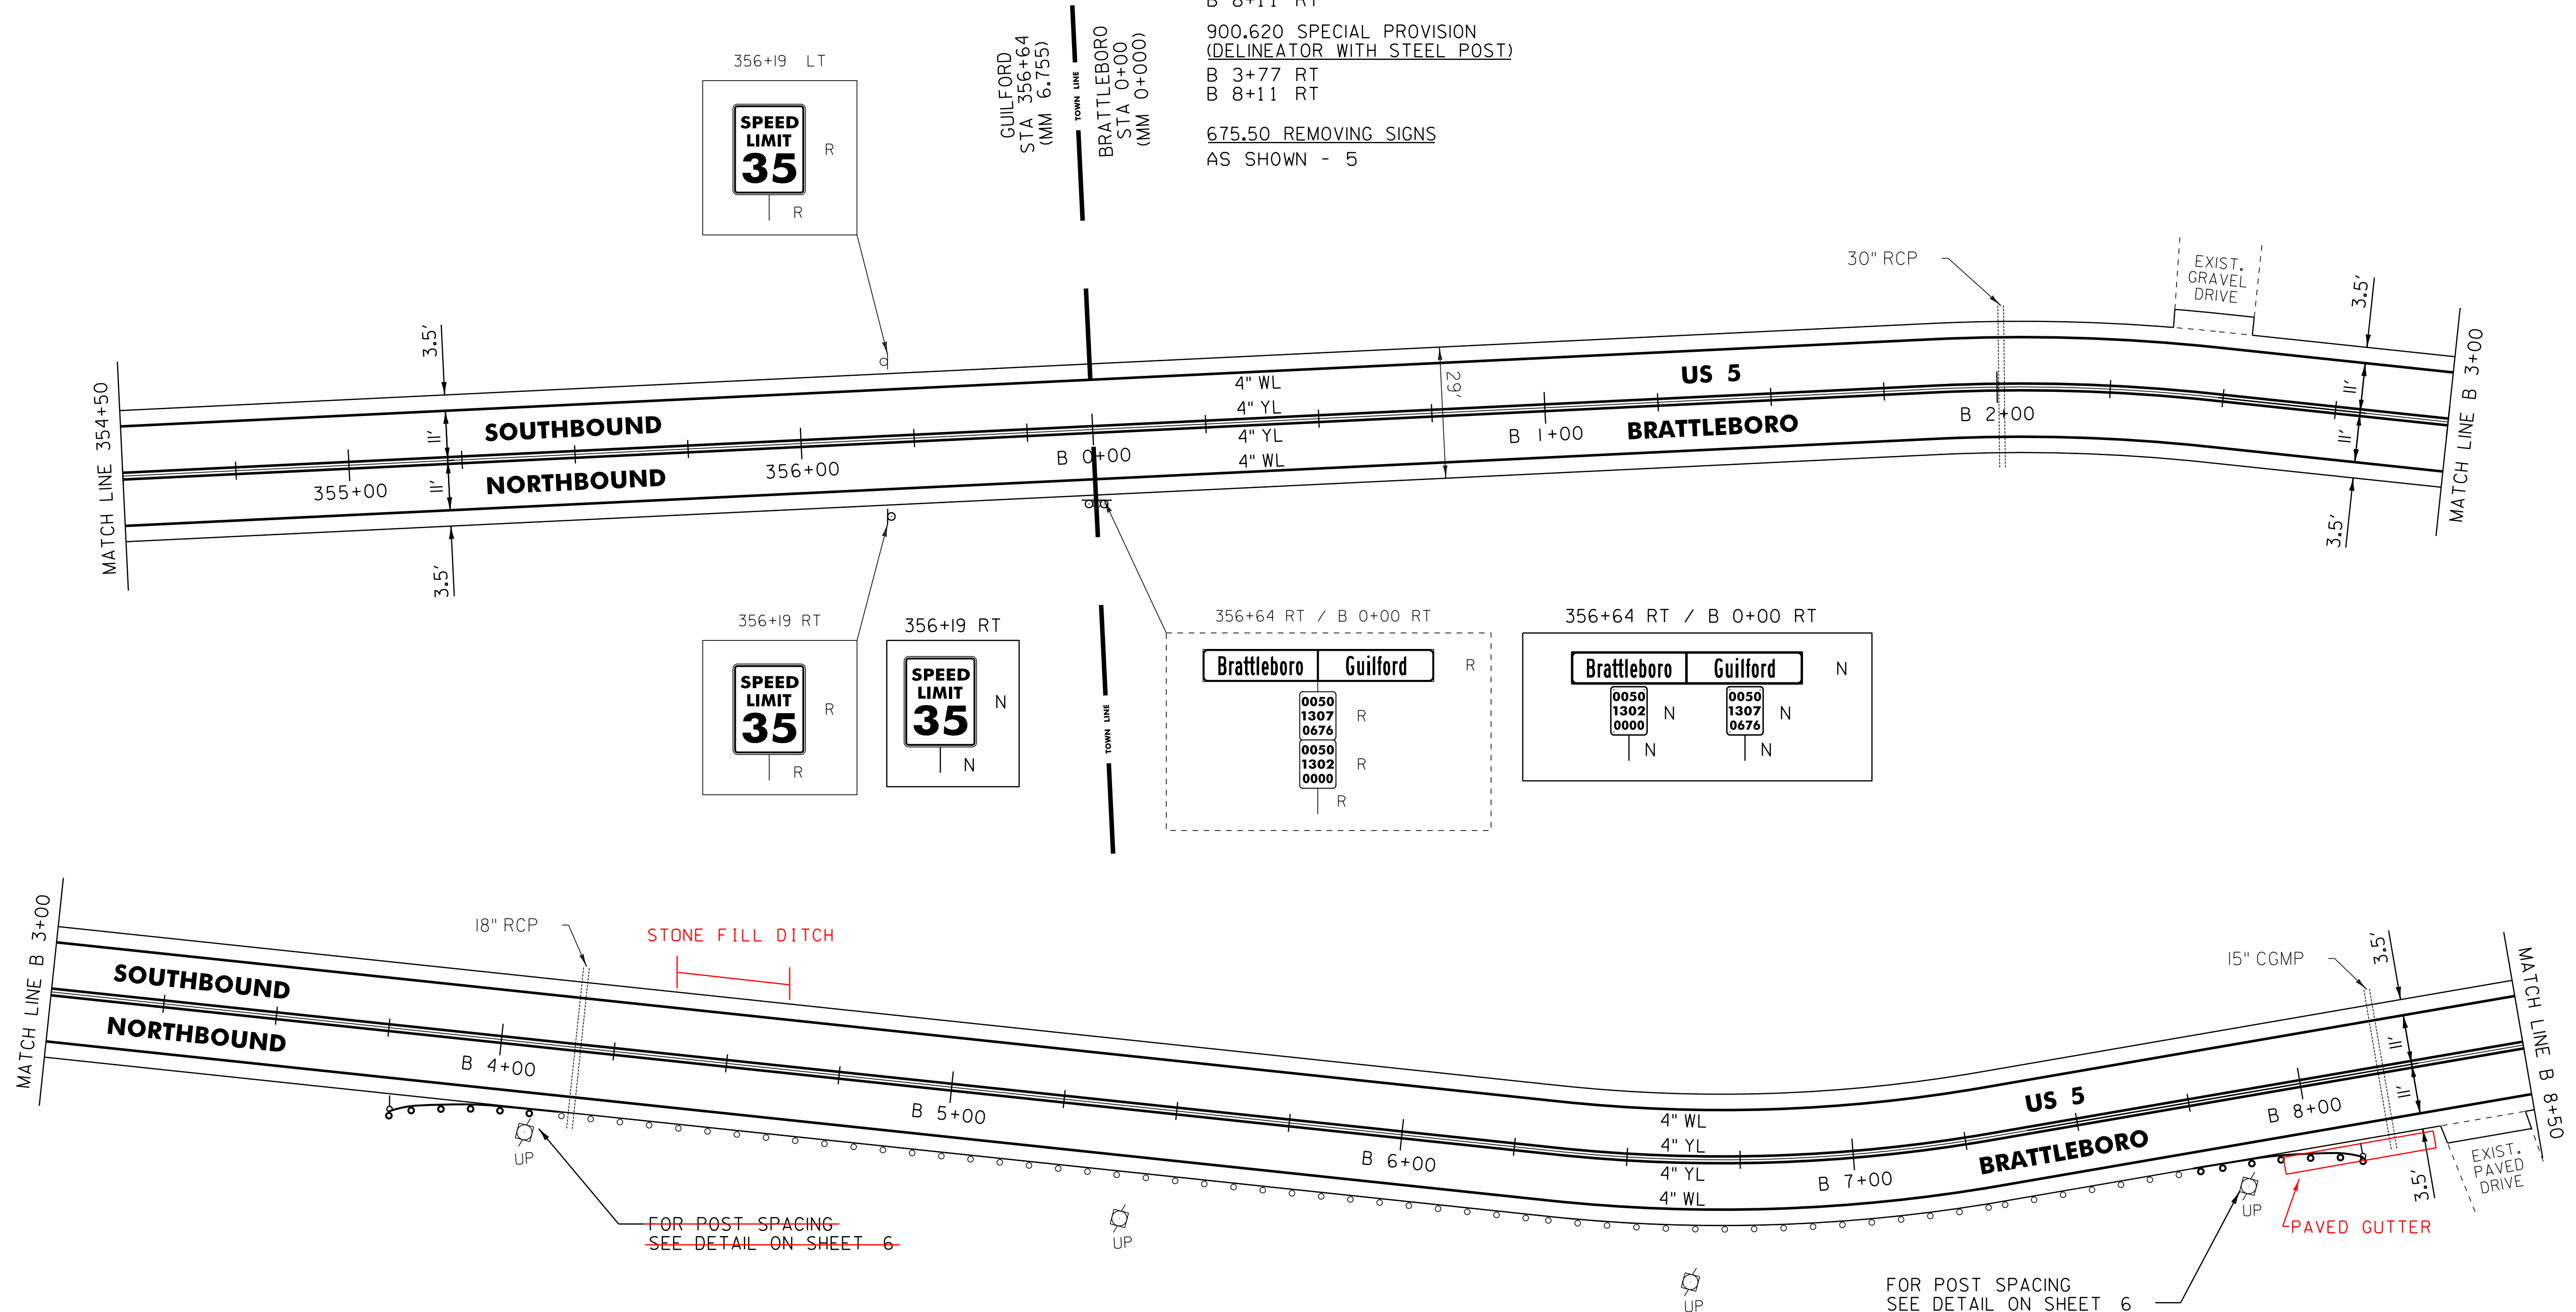

NOT TO SCALE

- LEGEND**
- R = REMOVE EXISTING
  - S = SALVAGE
  - R&S = REMOVE AND SALVAGE
  - N = NEW
  - RET = RETAIN
  - B-B = BACK TO BACK
  - = EXISTING GUARDRAIL
  - = PROPOSED GUARDRAIL
  - YL = YELLOW LINE
  - WL = WHITE LINE
  - = DELINEATOR

**ROADWAY LAYOUT 44**

PROJECT NAME: GUILFORD-BRATTLEBORO  
 PROJECT NUMBER: STP 2707(1)

FILE NAME: /pave/07cl66/pcl66  
 PROJECT LEADER: PTS  
 DESIGNED BY: NLL  
 IPARM FILE NAME: 07Cl66.63

PLOT DATE: 29-JAN-2013 11:42  
 DRAWN BY: WWG  
 CHECKED BY: NLL/PTS  
 SHEET 63 OF 97