

646.602 TEMPORARY 4" WHITE LINE, PAINT
 646.402 DURABLE 4" WHITE LINE, THERMOPLASTIC
 B 33+50 TO B 37+73 SOLID LT
 B 33+50 TO B 37+17 SOLID RT
 B 37+17 TO B 37+28 SOLID RT (TH 83)
 B 37+68 TO B 38+02 SOLID RT (TH 83)

646.602 TEMPORARY 4" WHITE LINE, PAINT
 646.406 DURABLE 4" WHITE LINE, RECESSED POLYUREA
 B 37+73 TO B 38+50 SOLID LT
 B 38+02 TO B 38+50 SOLID RT

646.612 TEMPORARY 4" YELLOW LINE, PAINT
 646.412 DURABLE 4" YELLOW LINE, THERMOPLASTIC
 B 33+50 TO B 37+33 SOLID LT & RT
 B 37+51 TO B 37+52 DOUBLE SOLID RT (TH 83)

646.612 TEMPORARY 4" YELLOW LINE, PAINT
 646.416 DURABLE 4" YELLOW LINE, RECESSED POLYUREA
 B 37+73 TO B 38+50 SOLID LT & RT

646.682 TEMPORARY 24" STOP BAR, PAINT
 646.482 DURABLE 24" STOP BAR, THERMOPLASTIC
 B 37+53 TO B 37+80 RT (TH 83)

646.692 TEMPORARY LETTER OR SYMBOL, PAINT
 646.492 DURABLE LETTER OR SYMBOL, THERMOPLASTIC
 B 37+62 RT - STOP (TH 83)

621.20 STEEL BEAM GUARDRAIL, GALVANIZED
 B 36+43 TO B 37+27 RT (ENDS ON GOLDFINCH LN)
 37+05


621.205 STEEL BEAM GUARDRAIL
 GALVANIZED W/8" POSTS
 B 33+50 TO B 36+43 RT
 37+05

621.80 REMOVAL AND DISPOSAL OF GUARDRAIL
 B 33+50 TO B 37+27 RT

621.60 ANCHOR FOR STEEL BEAM RAIL
 B 37+18 RT
 END ON GOLDFINCH LN

675.50 REMOVING SIGNS
 AS SHOWN - 10

675.60 ERECTING SALVAGED SIGNS
 AS SHOWN - 1

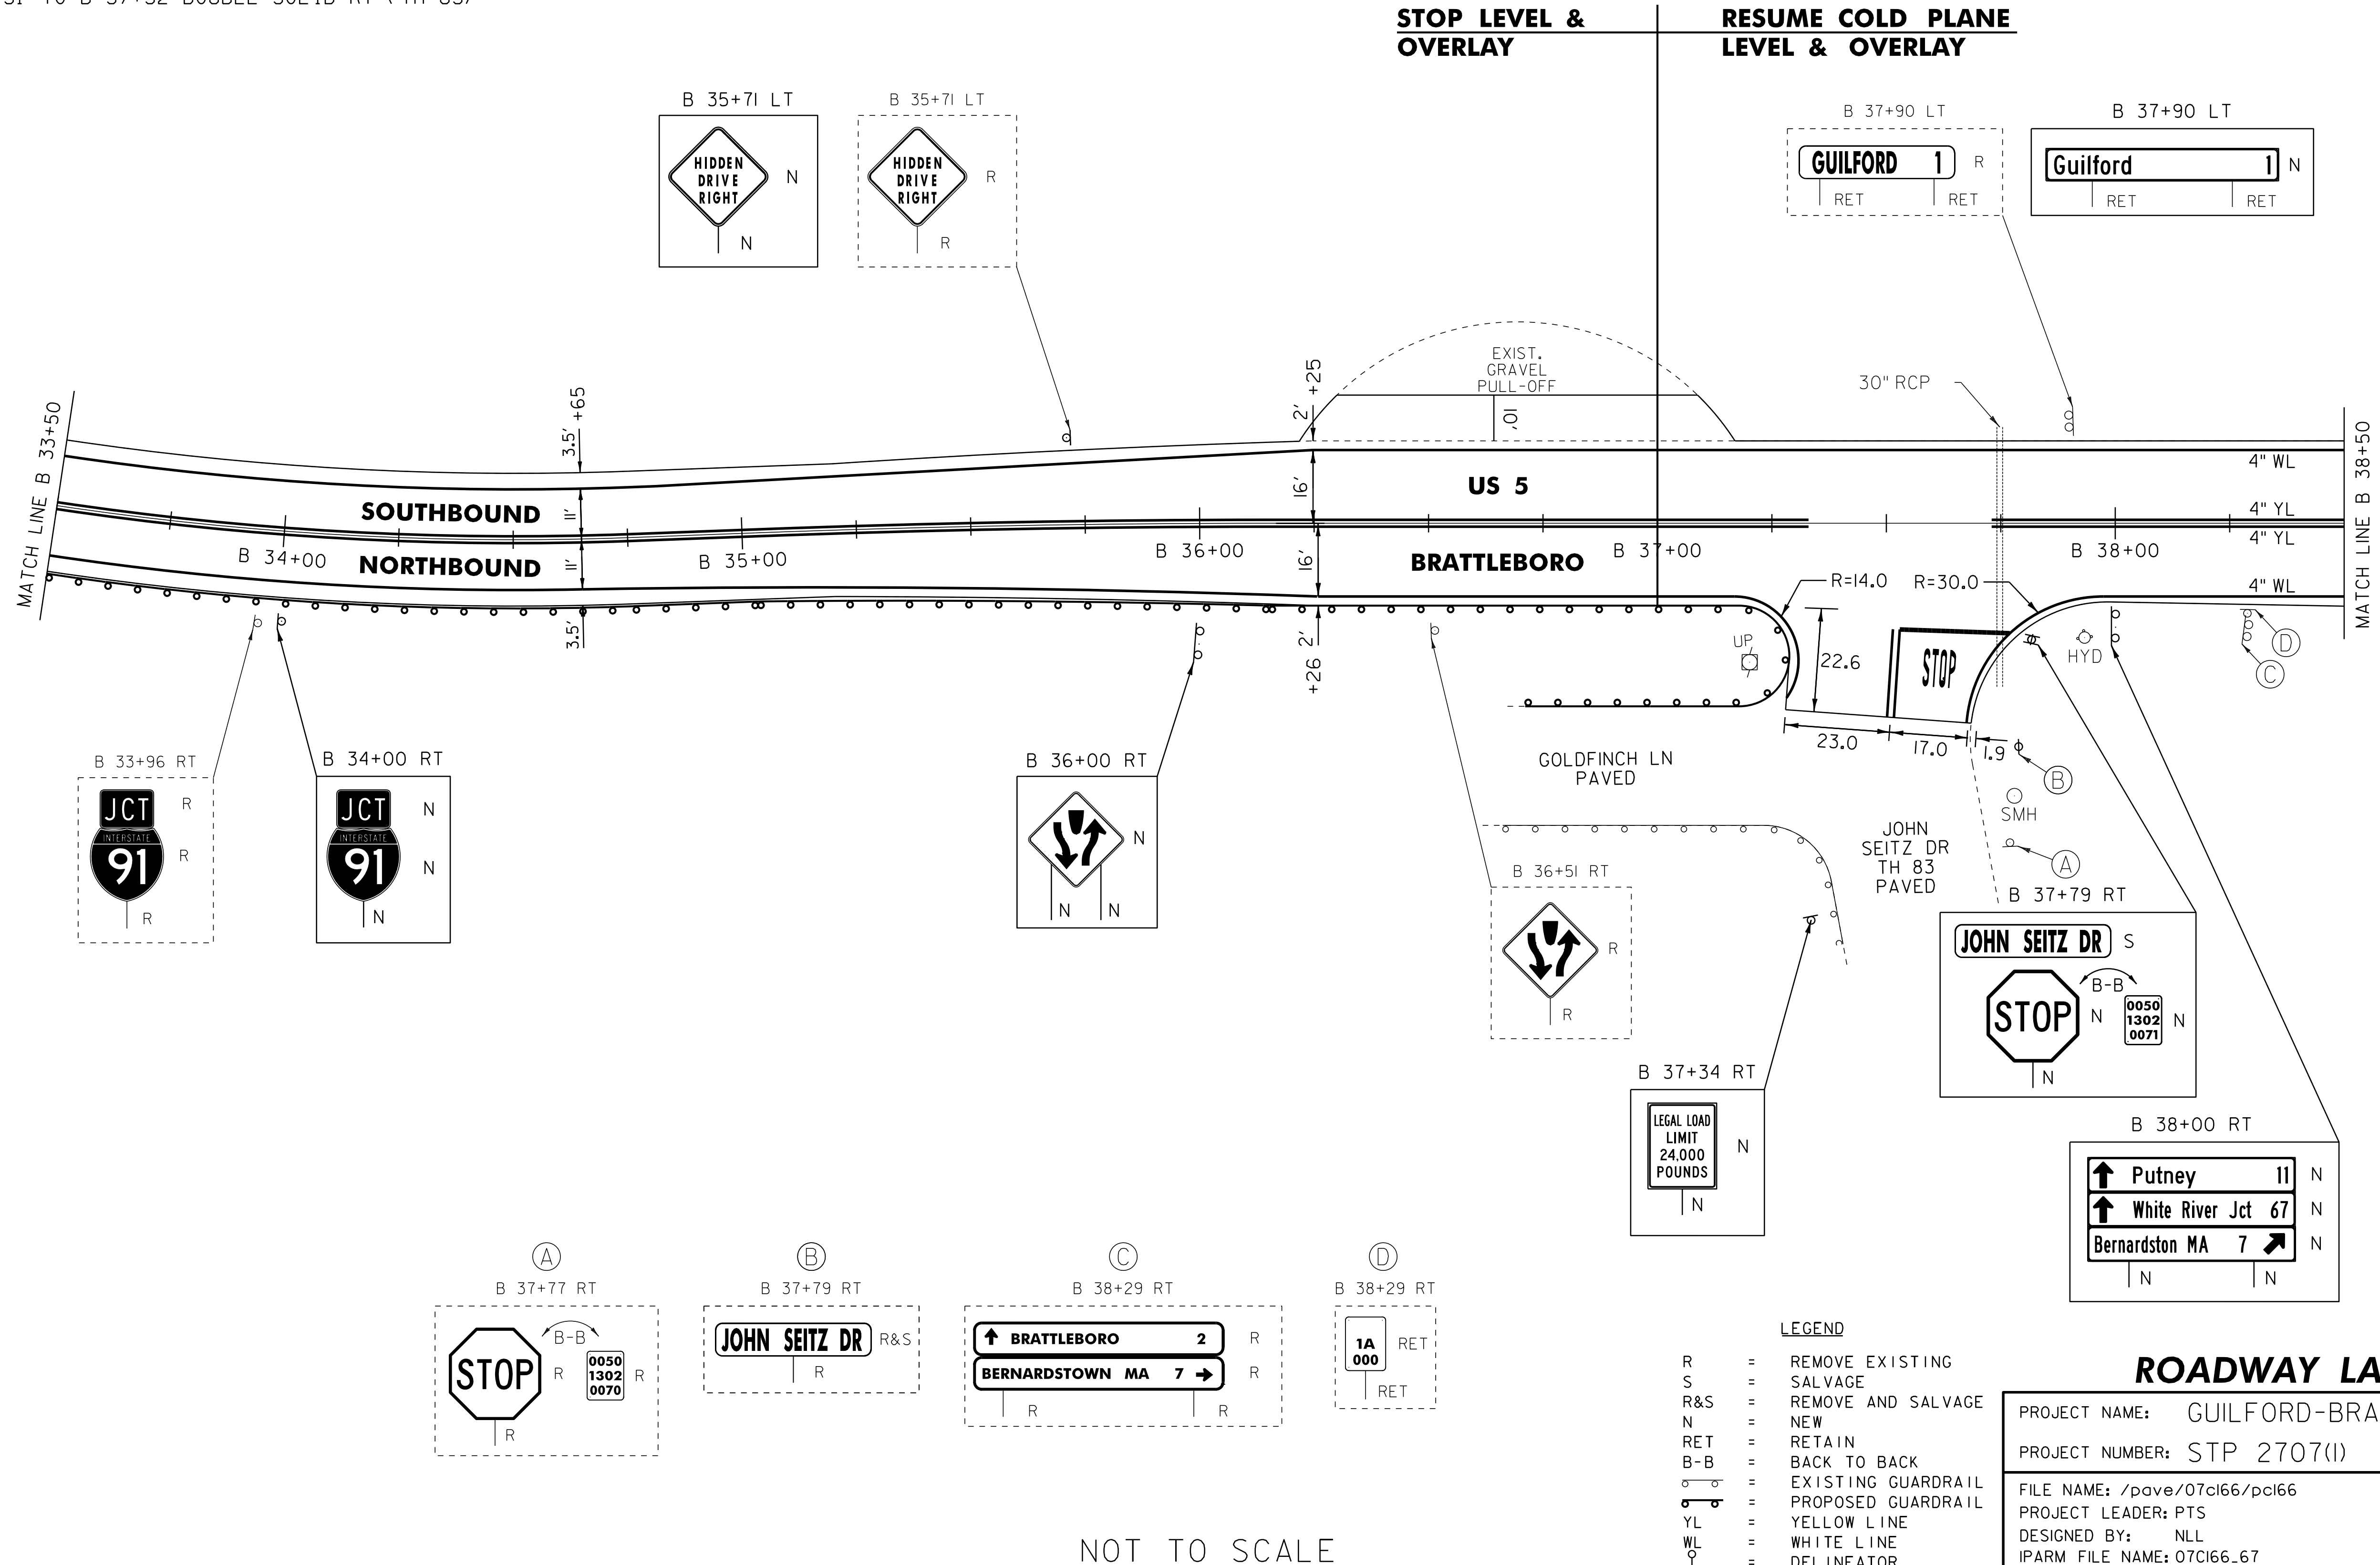

NOT TO SCALE

ROADWAY LAYOUT 48

PROJECT NAME: GUILFORD-BRATTLEBORO
 PROJECT NUMBER: STP 2707(1)

FILE NAME: /pave/07cl66/pcl66
 PROJECT LEADER: PTS
 DESIGNED BY: NLL
 IPARM FILE NAME: 07Cl66.67

PLOT DATE: 29-JAN-2013 11:42
 DRAWN BY: WWG
 CHECKED BY: NLL/PTS
 SHEET 67 OF 97