

646.602 TEMPORARY 4" WHITE LINE, PAINT
 646.406 DURABLE 4" WHITE LINE, RECESSED POLYUREA
 B 43+50 TO B 45+21 SOLID LT
 B 43+50 TO B 48+50 SOLID RT
 B 46+07 TO B 48+50 SOLID LT

646.612 TEMPORARY 4" YELLOW LINE, PAINT
 646.416 DURABLE 4" YELLOW LINE, RECESSED POLYUREA
 B 43+50 TO B 48+50 SOLID LT
 B 43+50 TO B 48+50 SOLID RT

646.642 TEMPORARY 8" WHITE LINE, PAINT
 646.446 DURABLE 8" WHITE LINE, RECESSED POLYUREA
 B 45+21 TO B 45+35 SOLID LT (RAMP D)
 B 45+21 TO B 45+35 SOLID LT (US 5)

604.412, 604.415, 604.418 REHAB. DROP
 INLETS, CATCH BASINS, OR MANHOLES,
 CLASS I, CLASS II OR CLASS III

B 44+74 LT (CB)
 B 44+79 RT (CB)
 B 46+63 RT (CB)
 B 47+00 LT (CB)
 621.20 STEEL BEAM GUARDRAIL, GALVANIZED
 B 43+50 TO B 45+82-5 RT

621.80 REMOVAL AND DISPOSAL OF GUARDRAIL
 B 43+50 TO B 45+83 RT

900.620 SPECIAL PROVISION
 (DELINEATOR WITH STEEL POST)
 B 45+85 RT


621.60 ANCHOR FOR STEEL BEAM RAIL
 B 45+85 RT

618.10 PORTLAND CEMENT
 CONCRETE SIDEWALK, 5 INCH
 B 45+75 TO B 45+80 RT (LANDING)

618.30 DETECTABLE
 WARNING SURFACE (DWS)
 B 45+76 RT

675.50 REMOVING SIGNS
 AS SHOWN - 20

675.60 ERECTING SALVAGED SIGNS
 AS SHOWN - 1

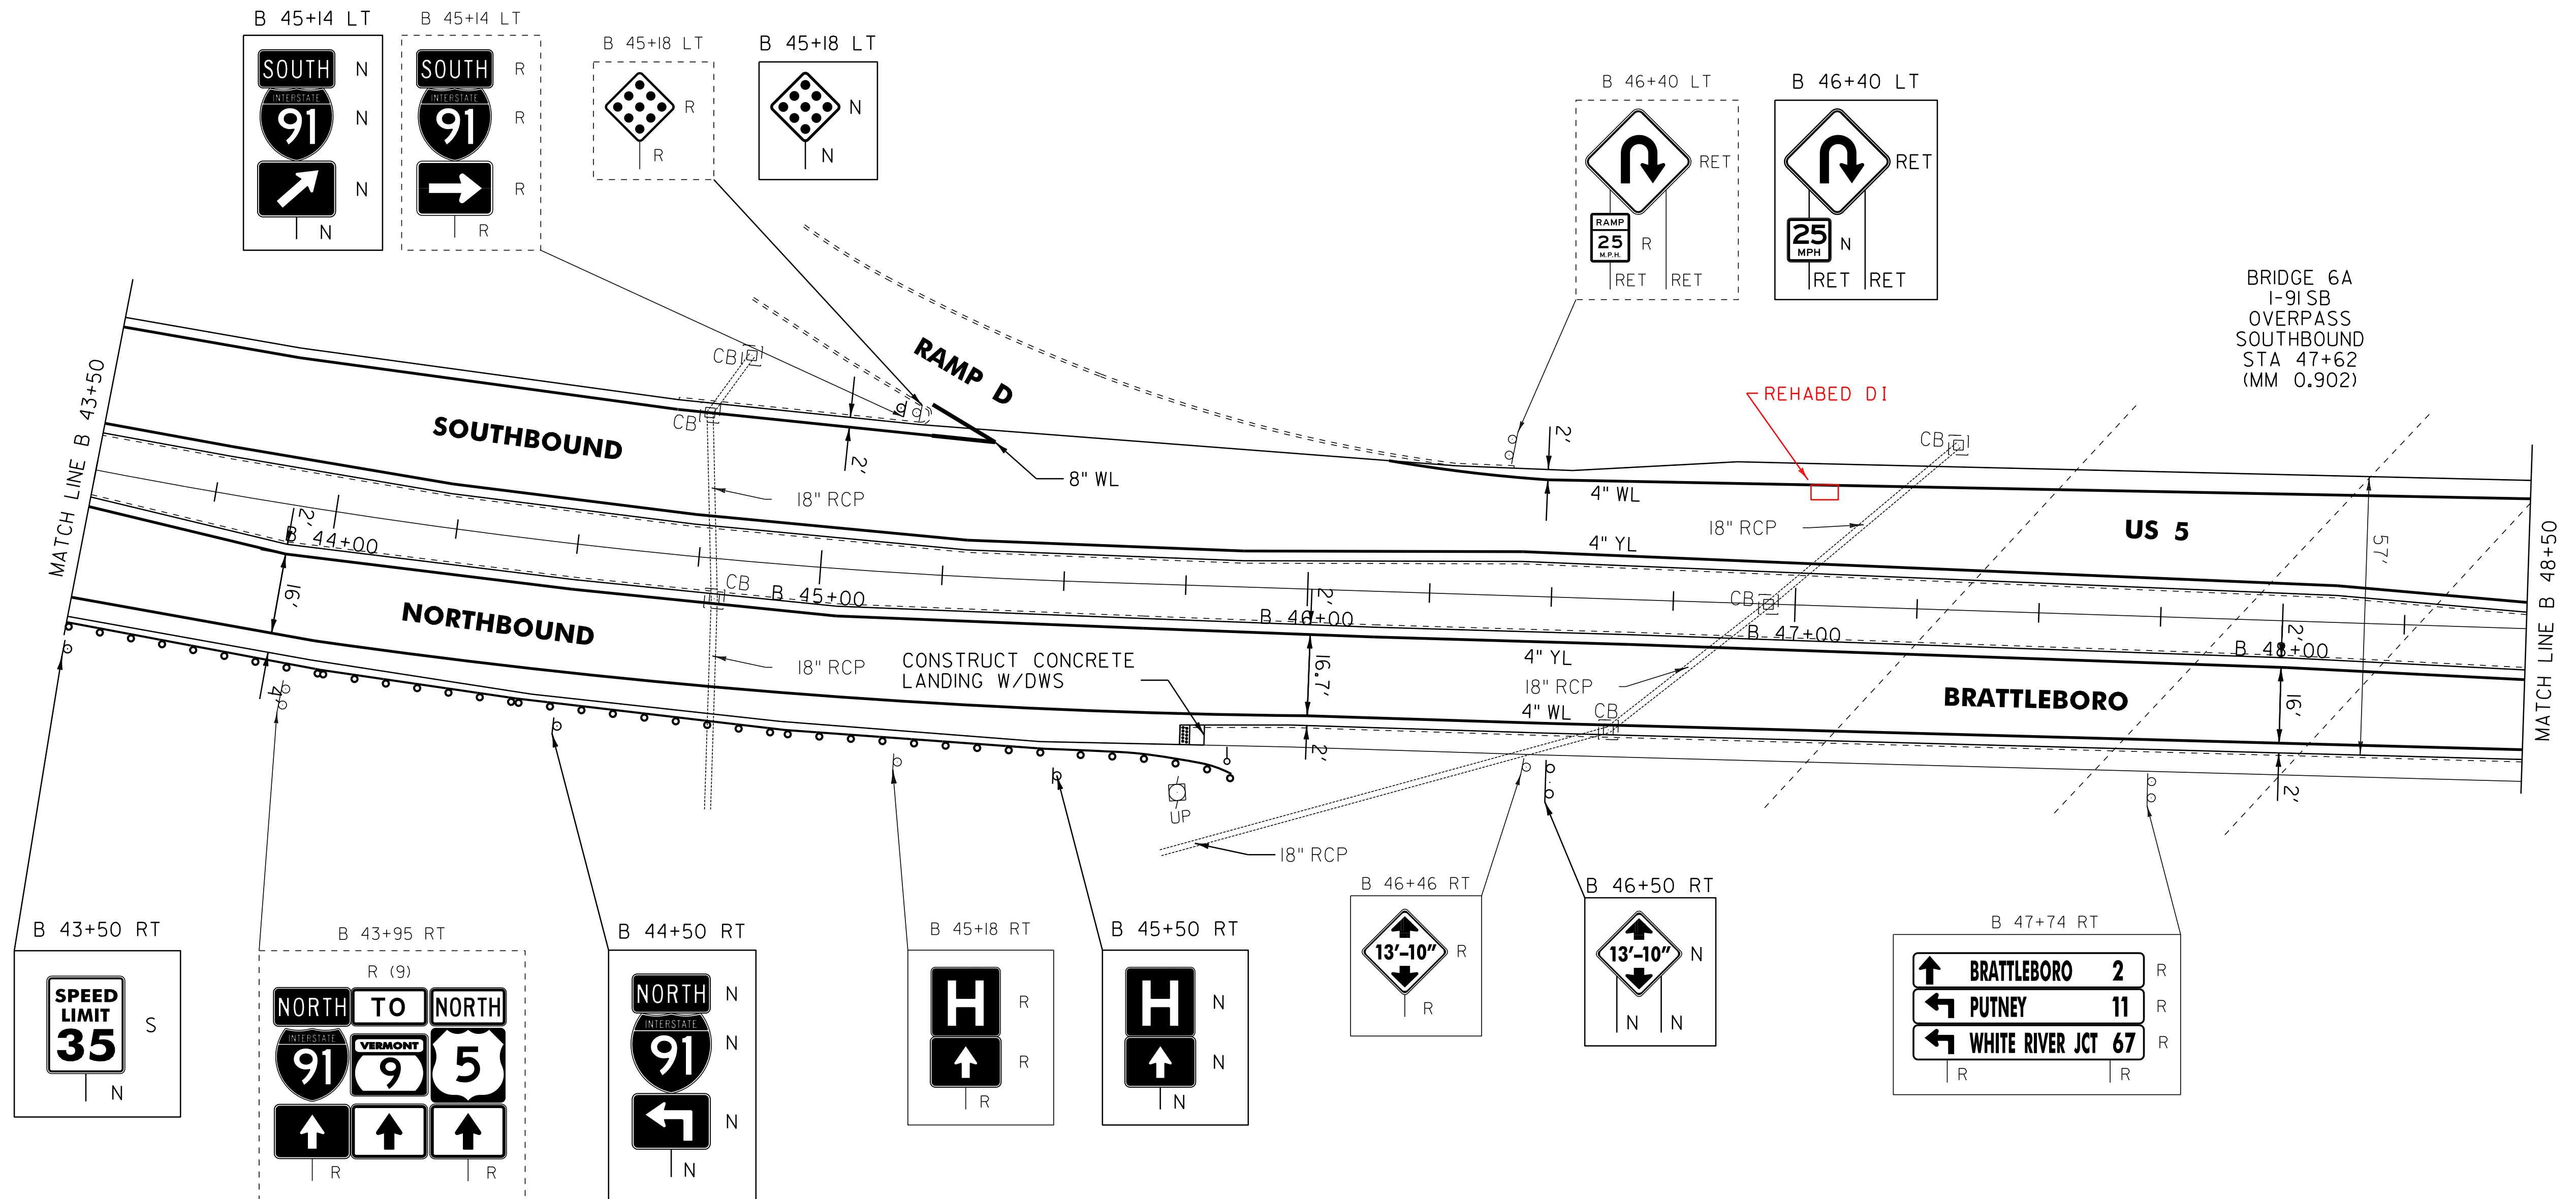

LEGEND

R	= REMOVE EXISTING
S	= SALVAGE
R&S	= REMOVE AND SALVAGE
N	= NEW
RET	= RETAIN
B-B	= BACK TO BACK
—	= EXISTING GUARDRAIL
—	= PROPOSED GUARDRAIL
YL	= YELLOW LINE
WL	= WHITE LINE
○	= DELINEATOR

ROADWAY LAYOUT 50

PROJECT NAME: GUILFORD-BRATTLEBORO	FILE NAME: /pave/07cl66/pcl66	PLOT DATE: 29-JAN-2013 11:42
PROJECT NUMBER: STP 2707(1)	PROJECT LEADER: PTS	DRAWN BY: WWG
	DESIGNED BY: NLL	CHECKED BY: NLL/PTS
	IPARM FILE NAME: 07CI66.69	SHEET 69 OF 97

NOT TO SCALE