


646.602 TEMPORARY 4" WHITE LINE, PAINT
 646.406 DURABLE 4" WHITE LINE, RECESSED POLYUREA
 B 48+50 TO B 52+56 SOLID LT
 B 48+50 TO B 49+12 SOLID RT
 B 49+40 TO B 49+76 SOLID RT
 B 50+14 TO B 53+50 SOLID RT
 B 51+01 TO B 51+60 DOTTED RT (LANE LINE)
 B 51+60 TO B 52+63 SOLID RT (LANE LINE)
 B 52+80 TO B 53+50 SOLID LT

646.612 TEMPORARY 3" YELLOW LINE, PAINT
 646.416 DURABLE 4" YELLOW LINE, RECESSED POLYUREA
 B 48+50 TO B 48+99 SOLID LT TO RT
 B 48+50 TO B 48+99 SOLID RT
 B 49+12 TO B 49+14 SOLID RT (RAMP E)
 B 49+27 TO B 51+94 SOLID LT
 B 49+27 TO B 51+94 SOLID RT
 B 49+74 TO B 49+76 SOLID RT (RAMP E)
 B 51+94 TO B 52+29 DOUBLE SOLID LT
 B 51+94 TO B 52+29 SOLID LT TO RT
 B 52+56 TO B 52+58 SOLID LT (RAMP G)
 B 52+95 TO B 53+50 SOLID RT
 B 53+00 TO B 53+50 SOLID LT

646.81 PAINTED CURB
 B 48+50 TO B 48+97 LT (ISLAND LT)
 B 48+67 TO B 48+97 RT (ISLAND NOSE)
 B 49+29 TO B 49+59 LT & RT (ISLAND NOSE)
 B 49+95 TO B 50+43 LT (ISLAND LT)
 B 50+13 TO B 50+43 RT (ISLAND RT)
 B 50+99 TO B 51+94 LT & RT (ISLAND)
 B 52+92 TO B 53+50 LT & RT (ISLAND)
 646.452 DURABLE 8" YELLOW LINE, THERMOPLASTIC
 B 51+93 TO B 52+27 LT

646.692 TEMPORARY LETTER OR SYMBOL, PAINT
 B 52+25 RT - LEFT TURN ARROW
 646.492 DURABLE LETTER OR SYMBOL, THERMOPLASTIC
 B 51+64 RT - ONLY
 B 52+25 RT - LEFT TURN ARROW
 604.412, 604.415, 604.418 REHAB. DROP INLETS, CATCH BASINS, OR MANHOLES, CLASS I, CLASS II OR CLASS III
 B 49+11 RT (CB)
 B 50+05 LT (OTDI)
 B 51+78 RT (CB)
 B 52+54 LT (OTDI)
 B 50+05 RT (CB)
 604.40 CHANGING ELEVATION OF DROP INLETS, CATCH BASINS, OR MANHOLES (NON PART.) (TO BE ADJUSTED BY OWNER)
 B 52+44 RT (TMH)
 B 49+15 RT (PART)

618.10 PORTLAND CEMENT CONCRETE SIDEWALK, 5 INCH
 B 49+06 TO B 49+15 RT (RAMP TYPE I)
 B 49+29 TO B 49+39 RT (RAMP TYPE I)
 618.30 DETECTABLE WARNING SURFACE (DWS)
 B 49+10 RT
 B 49+31 RT
~~616.40 REMOVING AND RESETTING CURB~~
~~B 49+07 TO B 49+16 RT (RAMP E)~~
~~B 49+29 TO B 49+36 RT (RAMP E)~~
 675.50 REMOVING SIGNS
 AS SHOWN - 41
 675.60 ERECTING SALVAGED SIGNS
 AS SHOWN - 7

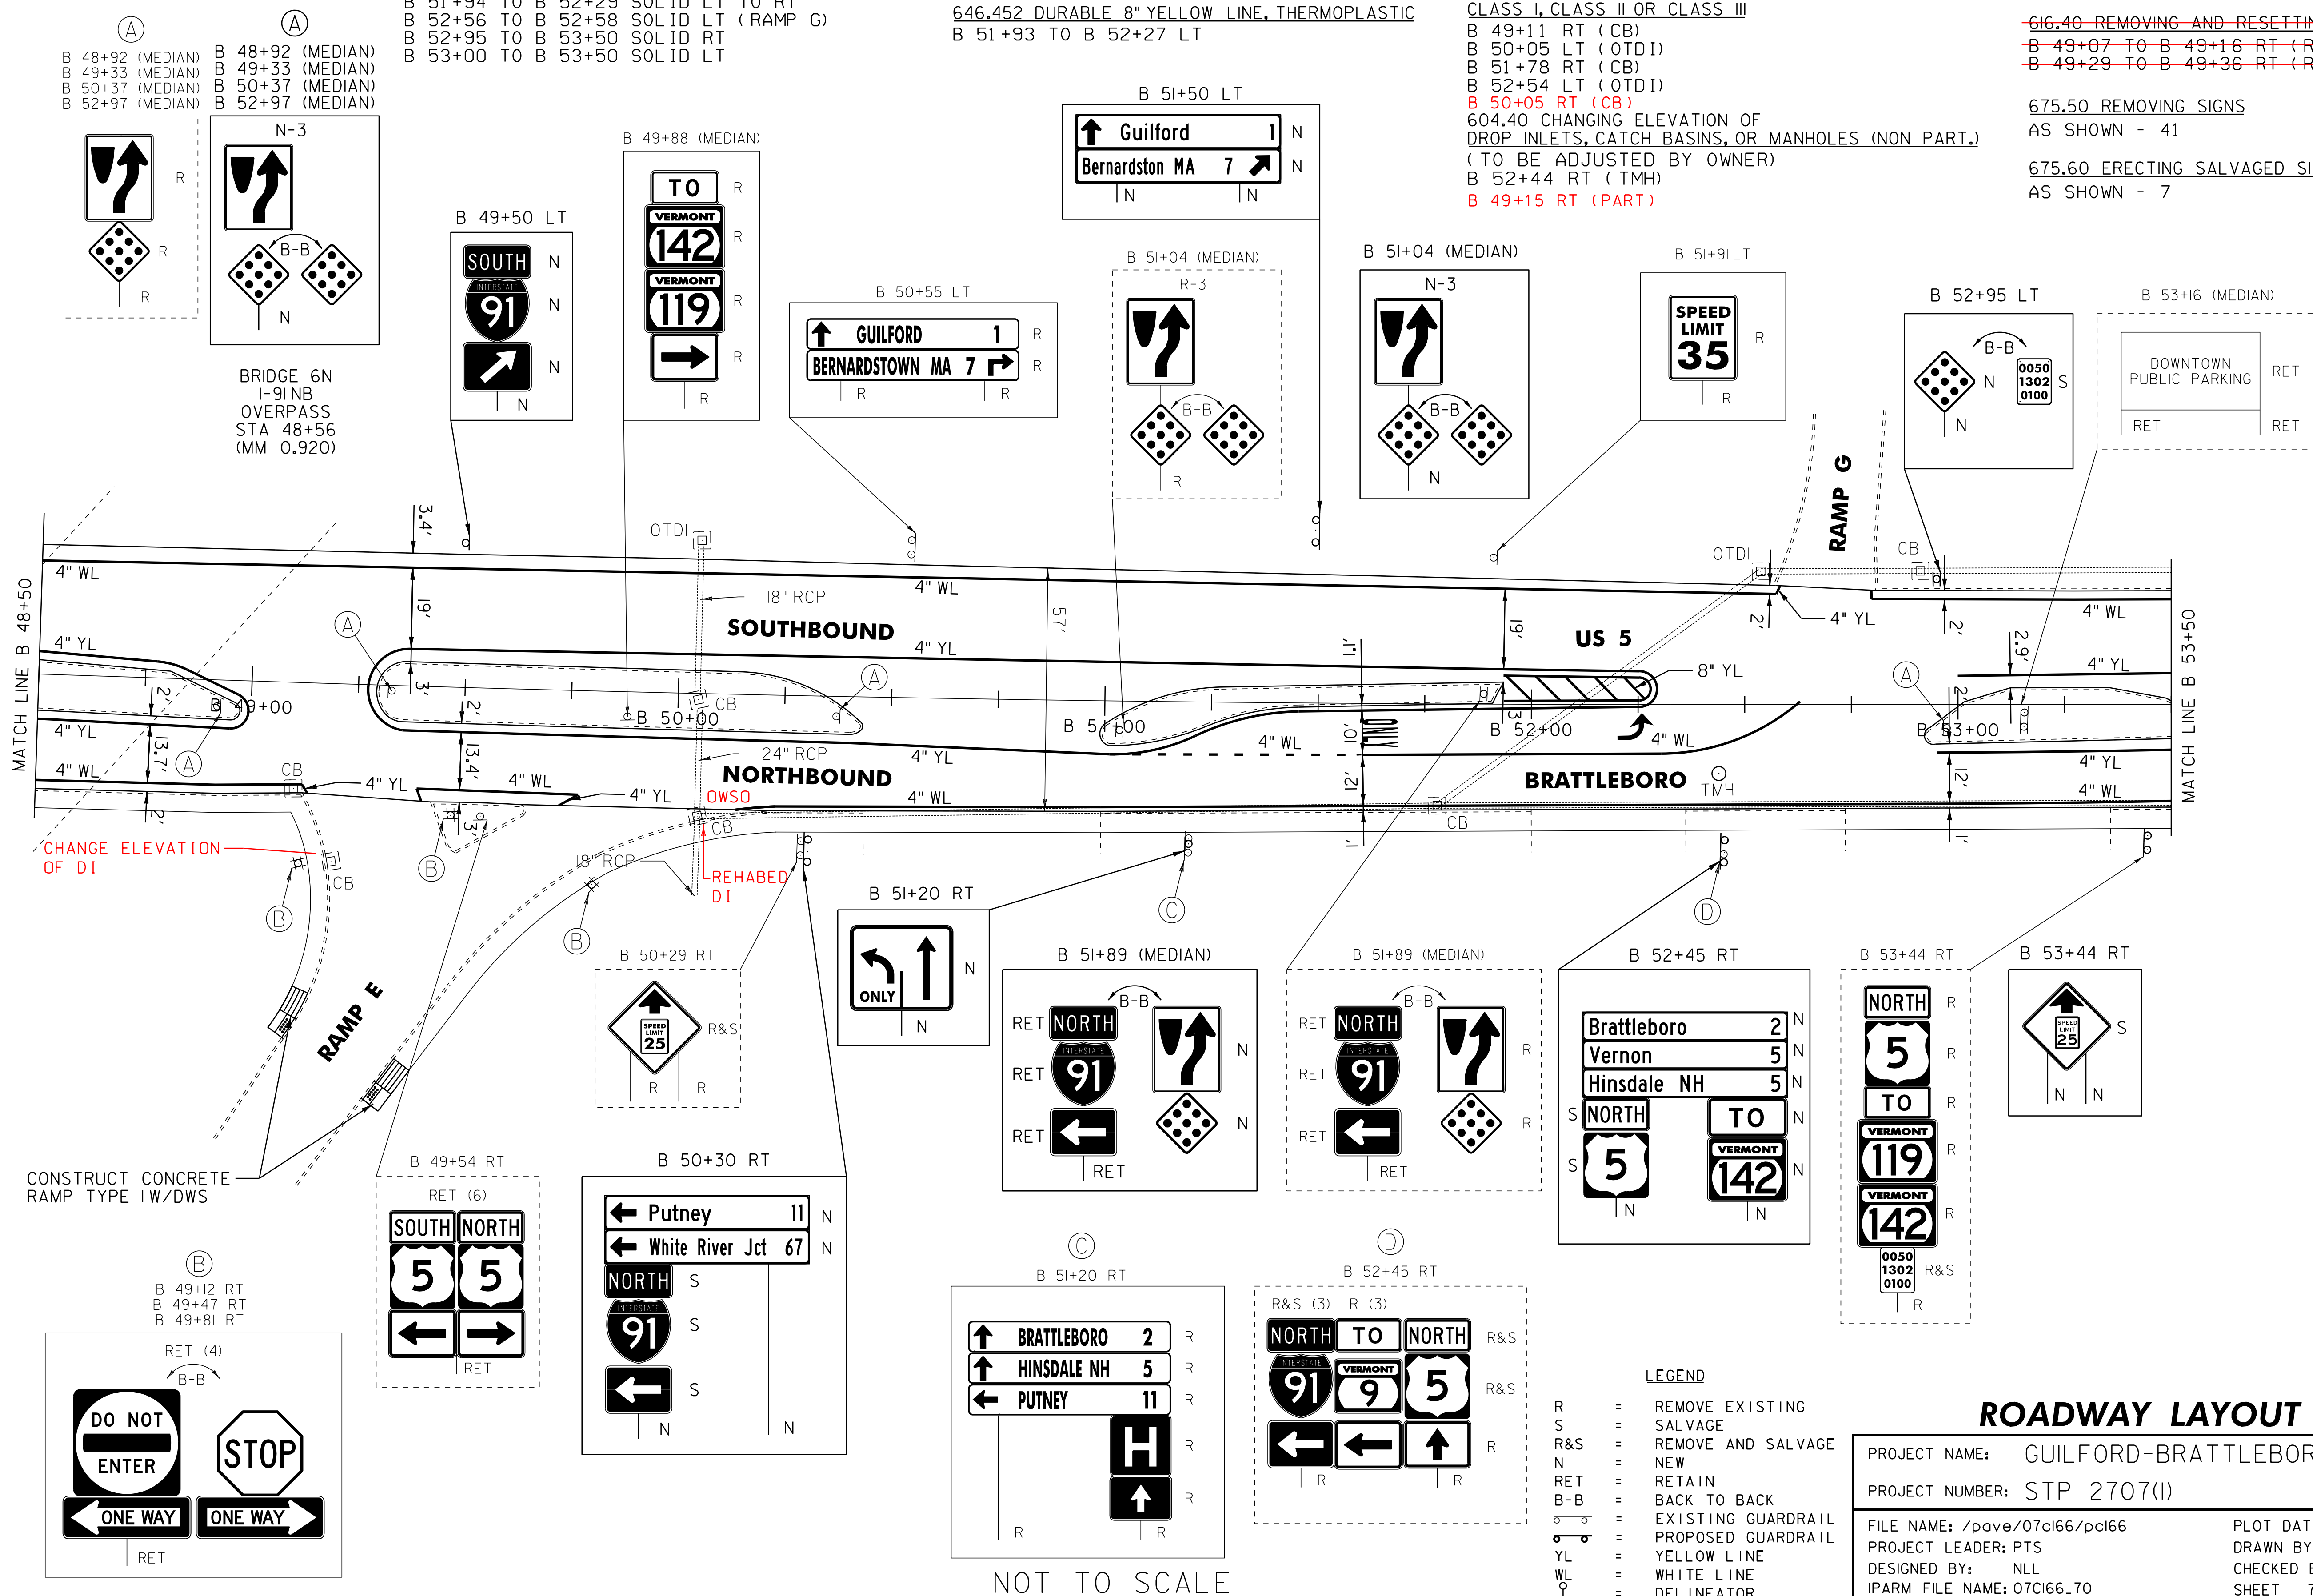

BRIDGE 6N
 I-91 NB
 OVERPASS
 STA 48+56
 (MM 0.920)

CHANGE ELEVATION OF DI

REHABED DI

CONSTRUCT CONCRETE RAMP TYPE IW/DWS

NOT TO SCALE

ROADWAY LAYOUT 51

PROJECT NAME: GUILFORD-BRATTLEBORO
 PROJECT NUMBER: STP 2707(1)
 FILE NAME: /pave/07cl66/pcl66
 PROJECT LEADER: PTS
 DESIGNED BY: NLL
 IPARM FILE NAME: 07Cl66_70

PLOT DATE: 29-JAN-2013 11:42
 DRAWN BY: WWG
 CHECKED BY: NLL/PTS
 SHEET 70 OF 97

LEGEND

- R = REMOVE EXISTING
- S = SALVAGE
- R&S = REMOVE AND SALVAGE
- N = NEW
- RET = RETAIN
- B-B = BACK TO BACK
- = EXISTING GUARDRAIL
- - - = PROPOSED GUARDRAIL
- YL = YELLOW LINE
- WL = WHITE LINE
- = DELINEATOR