

646.602 TEMPORARY 4" WHITE LINE, PAINT
 646.406 DURABLE 4" WHITE LINE, RECESSED POLYUREA
 B 53+50 TO B 54+75 SOLID LT
 B 53+50 TO B 56+85 SOLID RT
 B 55+22 TO B 57+66 SOLID LT
 B 55+65 TO B 57+00 DOTTED RT (LANE LINE)
 B 57+42 TO B 57+66 SOLID RT (LANE LINE)
 B 57+47 TO B 57+66 SOLID RT

646.452 DURABLE 8" YELLOW LINE, THERMOPLASTIC
 B 55+66 TO B 57+00 LT
 646.642 TEMPORARY 8" WHITE LINE, PAINT
 646.446 DURABLE 8" WHITE LINE, RECESSED POLYUREA
 B 54+75 TO B 54+90 LT (RAMP H)
 B 54+75 TO B 54+90 LT (US 5)

646.81 PAINTED CURB
 53+50 TO 53+61 LT & RT (ISLAND)
 54+25 TO 54+74 LT & RT (ISLAND)
 55+07 TO 55+67 LT & RT (ISLAND)

604.40 CHANGING ELEVATION OF
 DROP INLETS, CATCH BASINS, OR MANHOLES
 B 57+16 RT (DMH)(NON-PART)
~~B 57+07 TO B 57+14 RT~~
~~B 57+39 TO B 57+48 RT~~

604.412, 604.415, 604.418 REHAB. DROP
 INLETS, CATCH BASINS, OR MANHOLES,
 CLASS I, CLASS II OR CLASS III
 B 53+58 RT (CB)
 B 54+77 LT (CB)
 B 55+66 RT (CB)
 B 56+69 LT (CB)
 B 56+82 RT (CB)
 B 57+44 RT (CB)

646.612 TEMPORARY 4" YELLOW LINE, PAINT
 646.416 DURABLE 4" YELLOW LINE, RECESSED POLYUREA
 B 53+50 TO B 55+28 SOLID LT
 B 53+50 TO B 55+65 SOLID RT
 B 55+28 TO B 57+00 DOUBLE SOLID LT
 B 55+65 TO B 57+00 DOUBLE SOLID RT TO LT
 B 57+40 TO B 57+66 DOUBLE SOLID LT

646.702 TEMPORARY CROSSWALK MARKING, PAINT
 646.502 DURABLE CROSSWALK MARKING, THERMOPLASTIC
 B 57+14 TO B 57+38 RT (TH 534)

618.10 PORTLAND CEMENT
 CONCRETE SIDEWALK, 5 INCH
 B 57+04 TO B 57+14 RT (RAMP TYPE I)
 B 57+39 TO B 57+48 RT (RAMP TYPE I)
 B 55+60 RT B 56+82 RT

618.30 DETECTABLE
 WARNING SURFACE (DWS)
 B 57+12 RT
 B 57+41 RT


604.42 CHANGING ELEVATION
 OF SEWER MANHOLES (NON PART.)
 (TO BE ADJUSTED BY OWNER)
 B 56+52 RT
 B 57+24 RT

646.492 DURABLE LETTER
 OR SYMBOL, THERMOPLASTIC
 B 57+46 CL - ONLY

629.20 ADJUST
 ELEVATION OF VALVE BOX (NON PART.)
 (TO BE ADJUSTED BY OWNER)
 B 55+35 LT
 B 55+65 LT
 B 57+12 LT

675.50 REMOVING SIGNS
 AS SHOWN - 32

675.60 ERECTING SALVAGED SIGNS
 AS SHOWN - 2

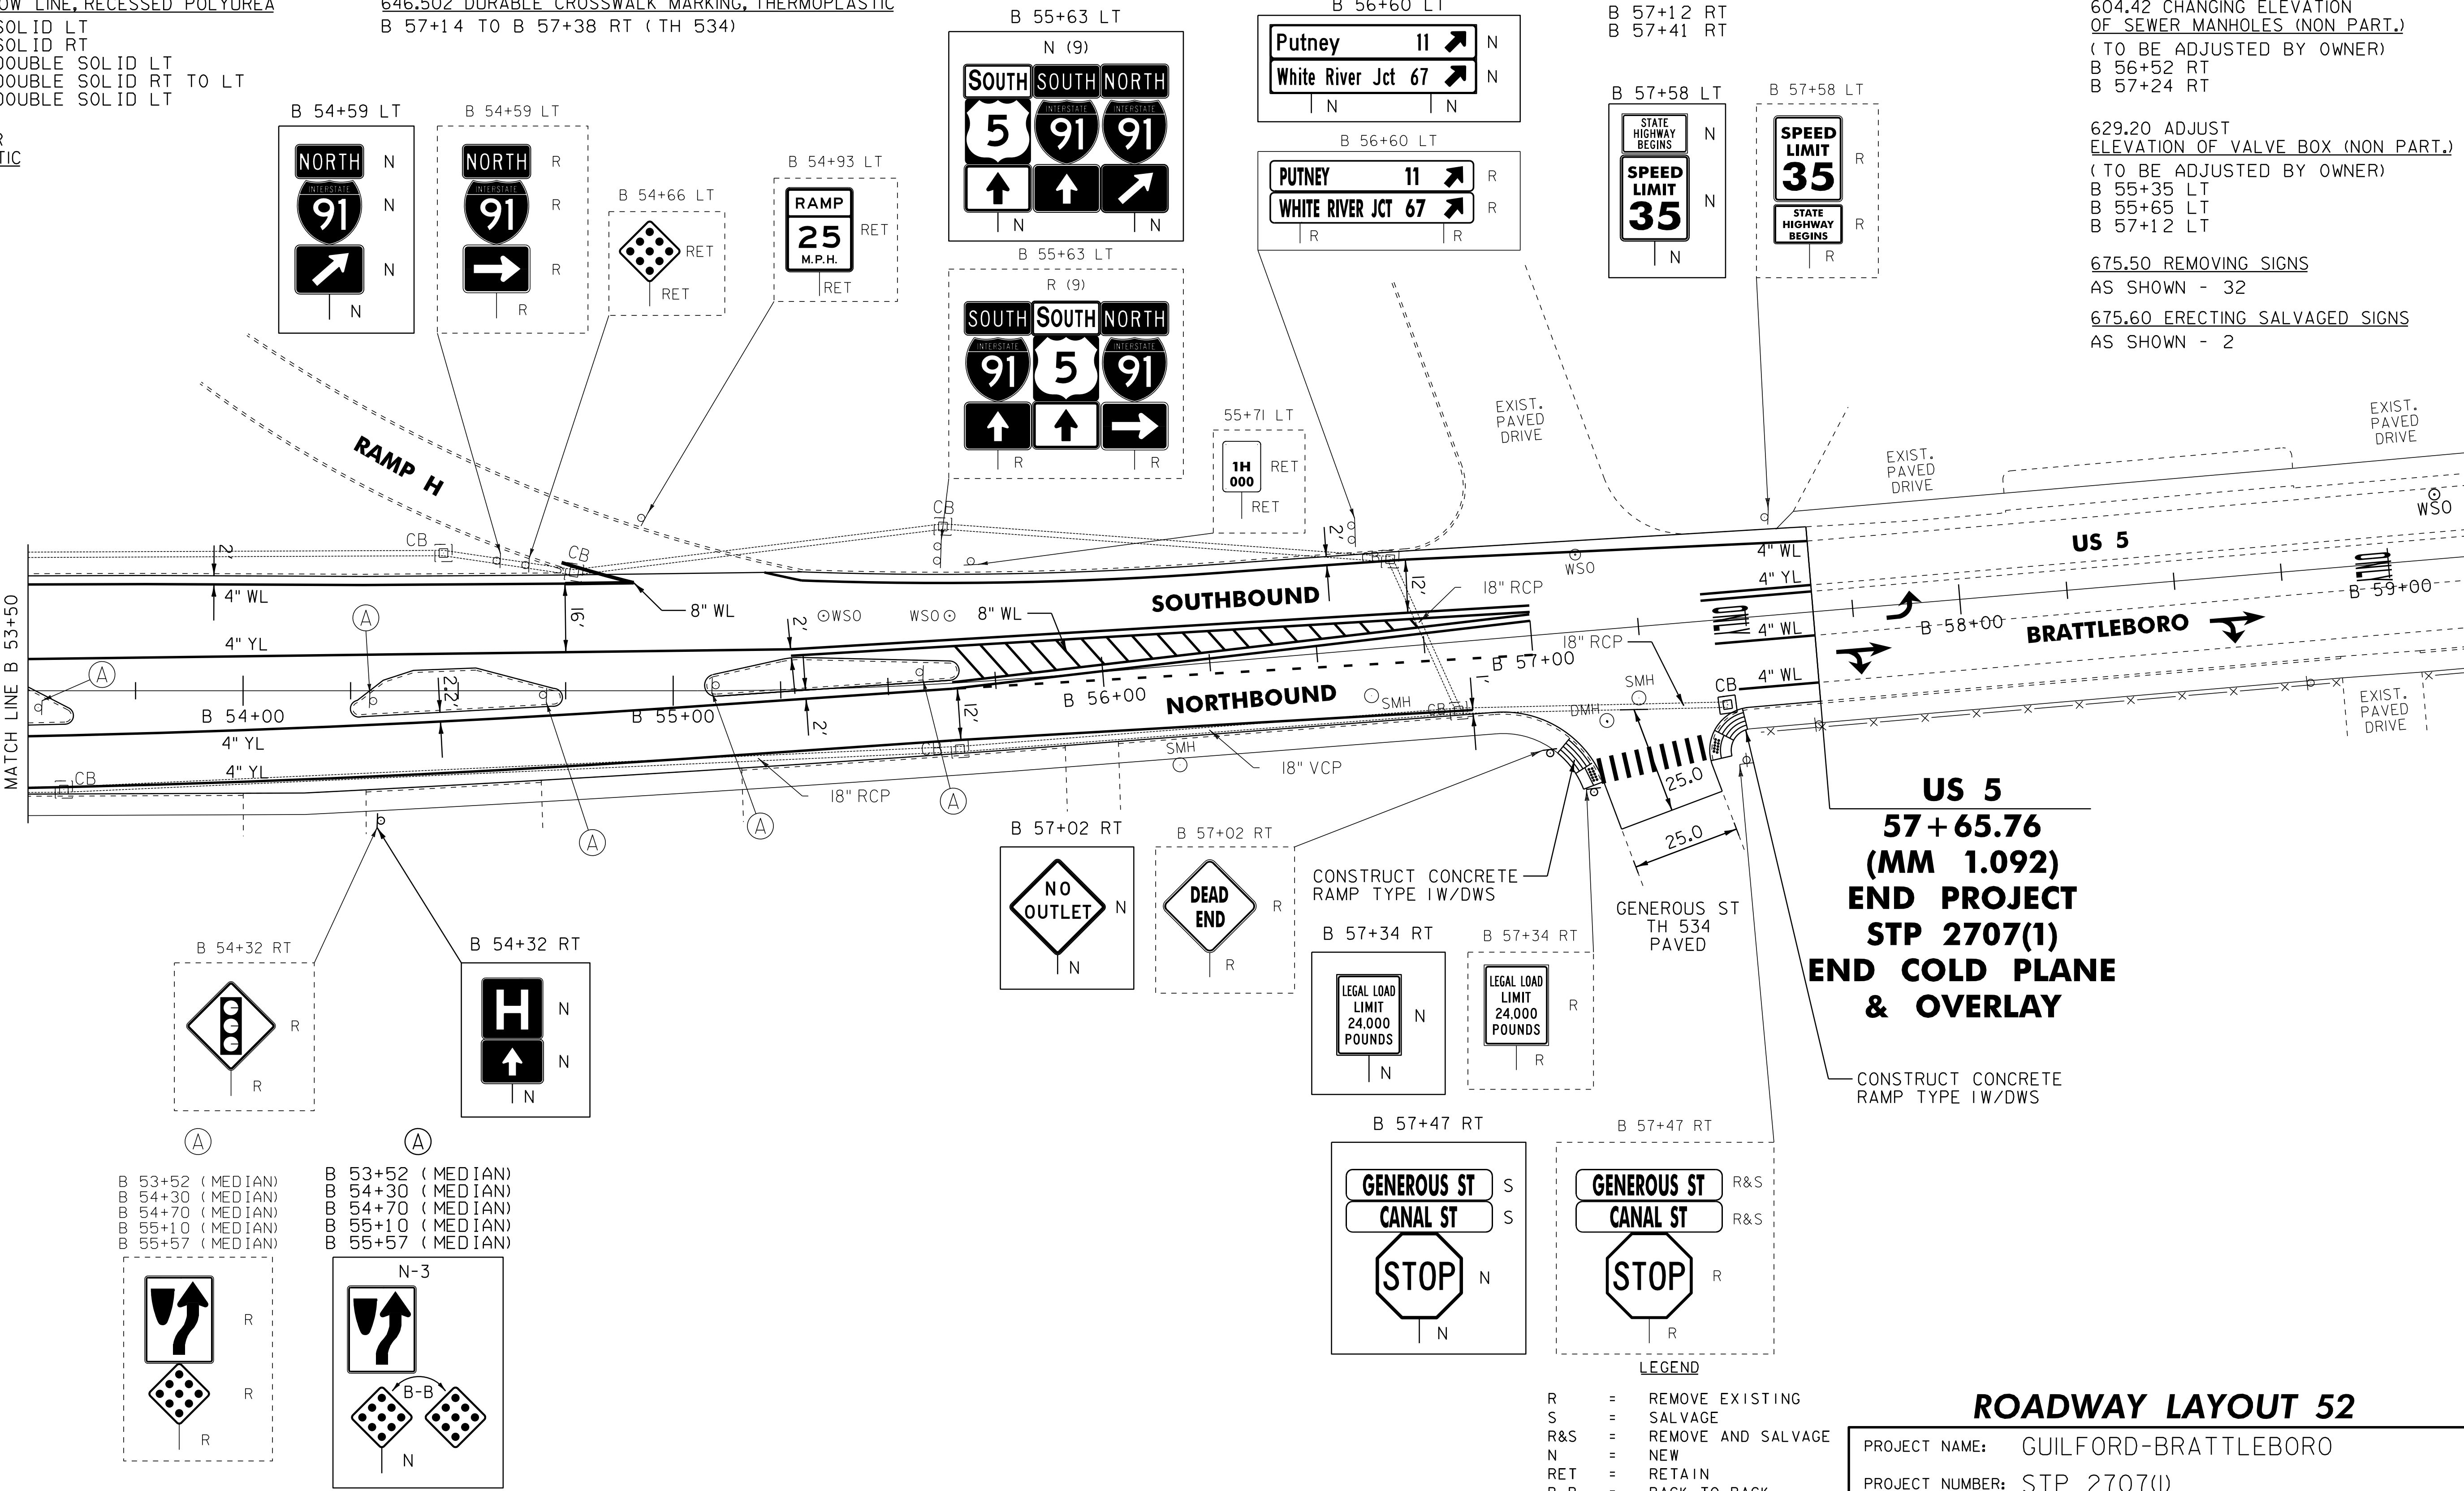

US 5
57+65.76
(MM 1.092)
END PROJECT
STP 2707(1)
END COLD PLANE
& OVERLAY

B 53+52 (MEDIAN)
 B 54+30 (MEDIAN)
 B 54+70 (MEDIAN)
 B 55+10 (MEDIAN)
 B 55+57 (MEDIAN)

B 53+52 (MEDIAN)
 B 54+30 (MEDIAN)
 B 54+70 (MEDIAN)
 B 55+10 (MEDIAN)
 B 55+57 (MEDIAN)

- LEGEND
- R = REMOVE EXISTING
 - S = SALVAGE
 - R&S = REMOVE AND SALVAGE
 - N = NEW
 - RET = RETAIN
 - B-B = BACK TO BACK
 - = EXISTING GUARDRAIL
 - = PROPOSED GUARDRAIL
 - YL = YELLOW LINE
 - WL = WHITE LINE
 - = DELINEATOR

NOT TO SCALE

ROADWAY LAYOUT 52

PROJECT NAME: GUILFORD-BRATTLEBORO
 PROJECT NUMBER: STP 2707(1)

FILE NAME: /pave/07cl66/pcl66
 PROJECT LEADER: PTS
 DESIGNED BY: NLL
 IPARM FILE NAME: 07Cl66_71

PLOT DATE: 29-JAN-2013 11:42
 DRAWN BY: WWG
 CHECKED BY: NLL/PTS
 SHEET 71 OF 97