


STATE OF VERMONT
AGENCY OF TRANSPORTATION



PROPOSED IMPROVEMENT
TOWNS OF CASTLETON, IRA, & WEST RUTLAND
COUNTY OF RUTLAND
VT. ROUTE 4A & VT. ROUTE 30

CASTLETON CLASS I
AC STP 2908(1)
SEE SHEET 90
FOR ADDITIONAL PROJECT INFORMATION
AND THE SUPERPAVE DESIGN CRITERIA

CASTLETON
AC STP 2909(1)
SEE SHEET 120
FOR ADDITIONAL PROJECT INFORMATION
AND THE SUPERPAVE DESIGN CRITERIA.

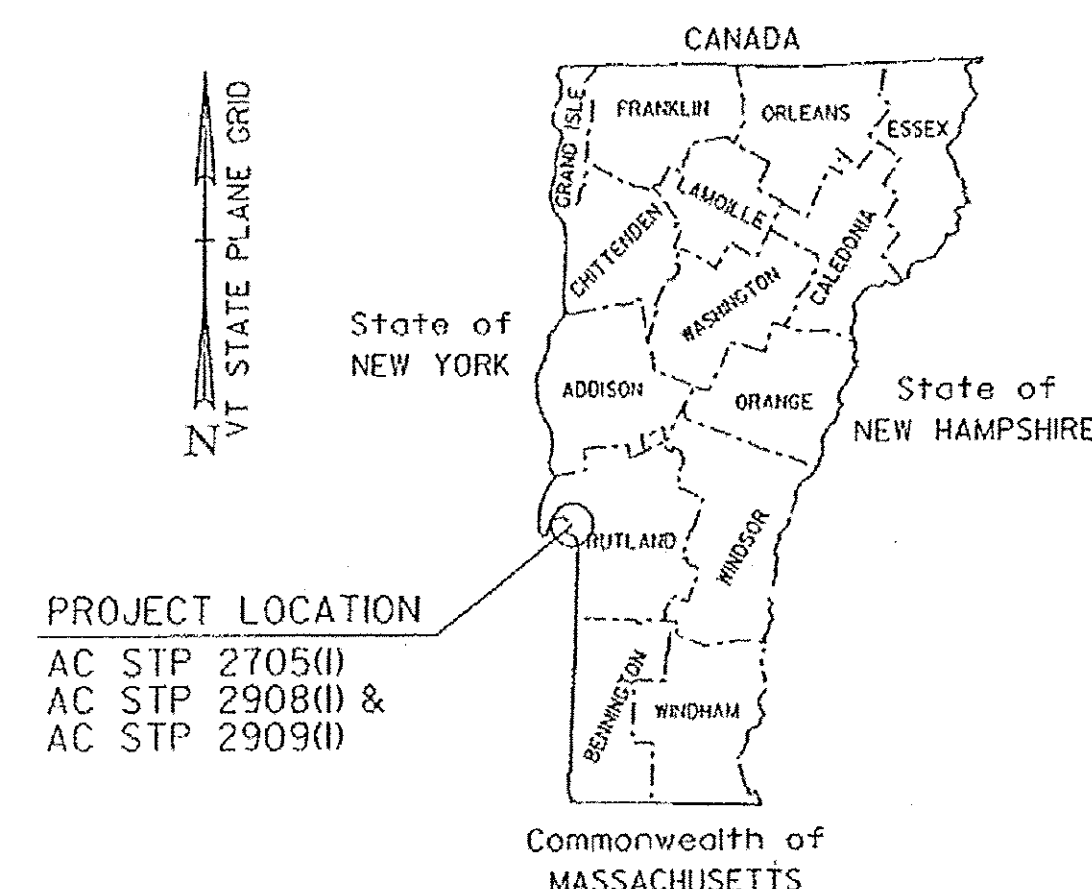


RECORD PLANS

RECORD PLANS BY: TIM POCKETTE & STEPHEN KENT

DATE 05-13-78

NOTE: Any further information concerning final quantities, amounts or other details relative to this project may be found at Central Files in the electronic archives.

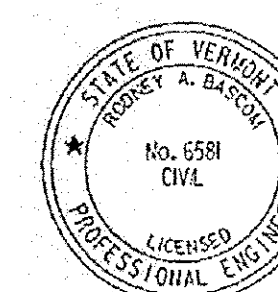

PLANS PREPARED BY

Rodney A. Brown

CHIA

QUALITY ASSURANCE PROGRAM: LEVEL 3

CONVENTIONAL SYMBOLS

COUNTY LINE

TOWN LINE

LIMITS OF ACCESS

POINT OF ACCESS

FENCE LINE

STONE WALL

TRAVELED WAY

GUARD RAIL

RAILROAD

SURVEY LINE

CULVERT

POWER POLE

TELEPHONE POLE

TREES

CONTROL OF ACCESS

PROPERTY LINE

R.O.W. TAKING LINE

SLOPE RIGHTS

TOP OF CUT

TOE OF SLOPE

SURVEYED BY : NA
SURVEYED DATE :NA

DATUM	
VERTICAL	NA
HORIZONTAL	NA

BEGIN AC STP 2909(1)
VT. ROUTE 30
CASTLETON
MM 1.530 =
STA 80+78.40

BEGIN AC STP 2908(1)
VT. ROUTE 4A
CASTLETON CLASS 1
MM 2.789 = STA 147+25.92

END AC STP 2909(I)
VT. ROUTE 30
CASTLETON
MM 5.190 = STA 274+03.20

END AC STP 2705(1)
CASTLETON STATE HIGHWAY
CASTLETON
MM 0.406 = STA 21+43.68

END AC STP 2908(I)
VT. ROUTE 4A
CASTLETON CLASS I
MM 3.854 = STA 203+49.12

BEGIN AC STP 2705(I)
VT. ROUTE 4A
CASTLETON-WEST RUTLAND
MM 3.854 = STA 203+49.12

END AC STP 2705(I)
VT. ROUTE 4A
CASTLETON-WEST RUTLAND
MM 1.798 = STA 94+93.44

PROCTOR

RUTLAND

CLARENDON

DEPARTMENT OF TRANSPORTATION
FEDERAL HIGHWAY ADMINISTRATOR
APPROVED Mark D. Kishel 9-22-11
DIRECTOR OF PROGRAM DEVELOPMENT
APPROVED Paul J. Jones DATE 9/19/11
PROJECT MANAGER : MIKE FOWLER
PROJECT NAME : CASTLETON-WEST RUTLAND
& CASTLETON
PROJECT NUMBER : AC STP 2705 (I) , AC STP 2908 (I)
& AC STP 2909 (I)
SHEET 1 OF 152 SHEETS

FILE NAME = V:\Projects\ANY\K2\22234\CAD00\MSTN\07C168_Contract_Planes.dgn
DATE/TIME = 9/16/2011