



646.402 DURABLE 4 INCH WHITE LINE, THERMOPLASTIC OR
 646.403 DURABLE 4 INCH WHITE LINE, EPOXY PAINT OR
 646.404 DURABLE 4 INCH WHITE LINE, POLYUREA
 (ALL LINES WILL INCLUDE EDGE LINE BREAKS AND
 RADIUS FOR TOWN HIGHWAYS)
 CASTLETON:
 STA 215+25.00 - STA 226+50.00 EDGE LINE LT & RT

646.602 TEMPORARY 4 INCH WHITE LINE, PAINT
 (ALL LINES WILL INCLUDE EDGE LINE BREAKS AND
 RADIUS FOR TOWN HIGHWAYS)
 CASTLETON:
 STA 215+25.00 - STA 226+50.00 EDGE LINE LT & RT

646.412 DURABLE 4 INCH YELLOW LINE, THERMOPLASTIC OR
 646.413 DURABLE 4 INCH YELLOW LINE, EPOXY PAINT OR
 646.414 DURABLE 4 INCH YELLOW LINE, POLYUREA
 (ALL LINES WILL INCLUDE C/L BREAKS FOR
 TOWN HIGHWAYS) S=SOLID, D=DASHED
 CASTLETON:
 STA 216+25.00 - STA 226+50.00 LT @ RT
 STA 215+25.00 - STA 216+25.00 DOUBLE SOLID MEDIAN LT & RT

646.612 TEMPORARY 4 INCH YELLOW LINE, PAINT
 (ALL LINES WILL INCLUDE C/L BREAKS FOR
 TOWN HIGHWAYS) S=SOLID, D=DASHED
 CASTLETON:
 STA 216+25.00 - STA 226+50.00 LT @ RT
 STA 215+25.00 - STA 216+25.00 DOUBLE SOLID MEDIAN LT & RT

675.50 REMOVING SIGNS
 AS SHOWN - 17
 675.60 ERECTING SALVAGED SIGNS
 AS SHOWN - 1
 TH-8
 CRAMPTON RD
 MM 4.182 = STA 220+80.96
 (ASPHALT)

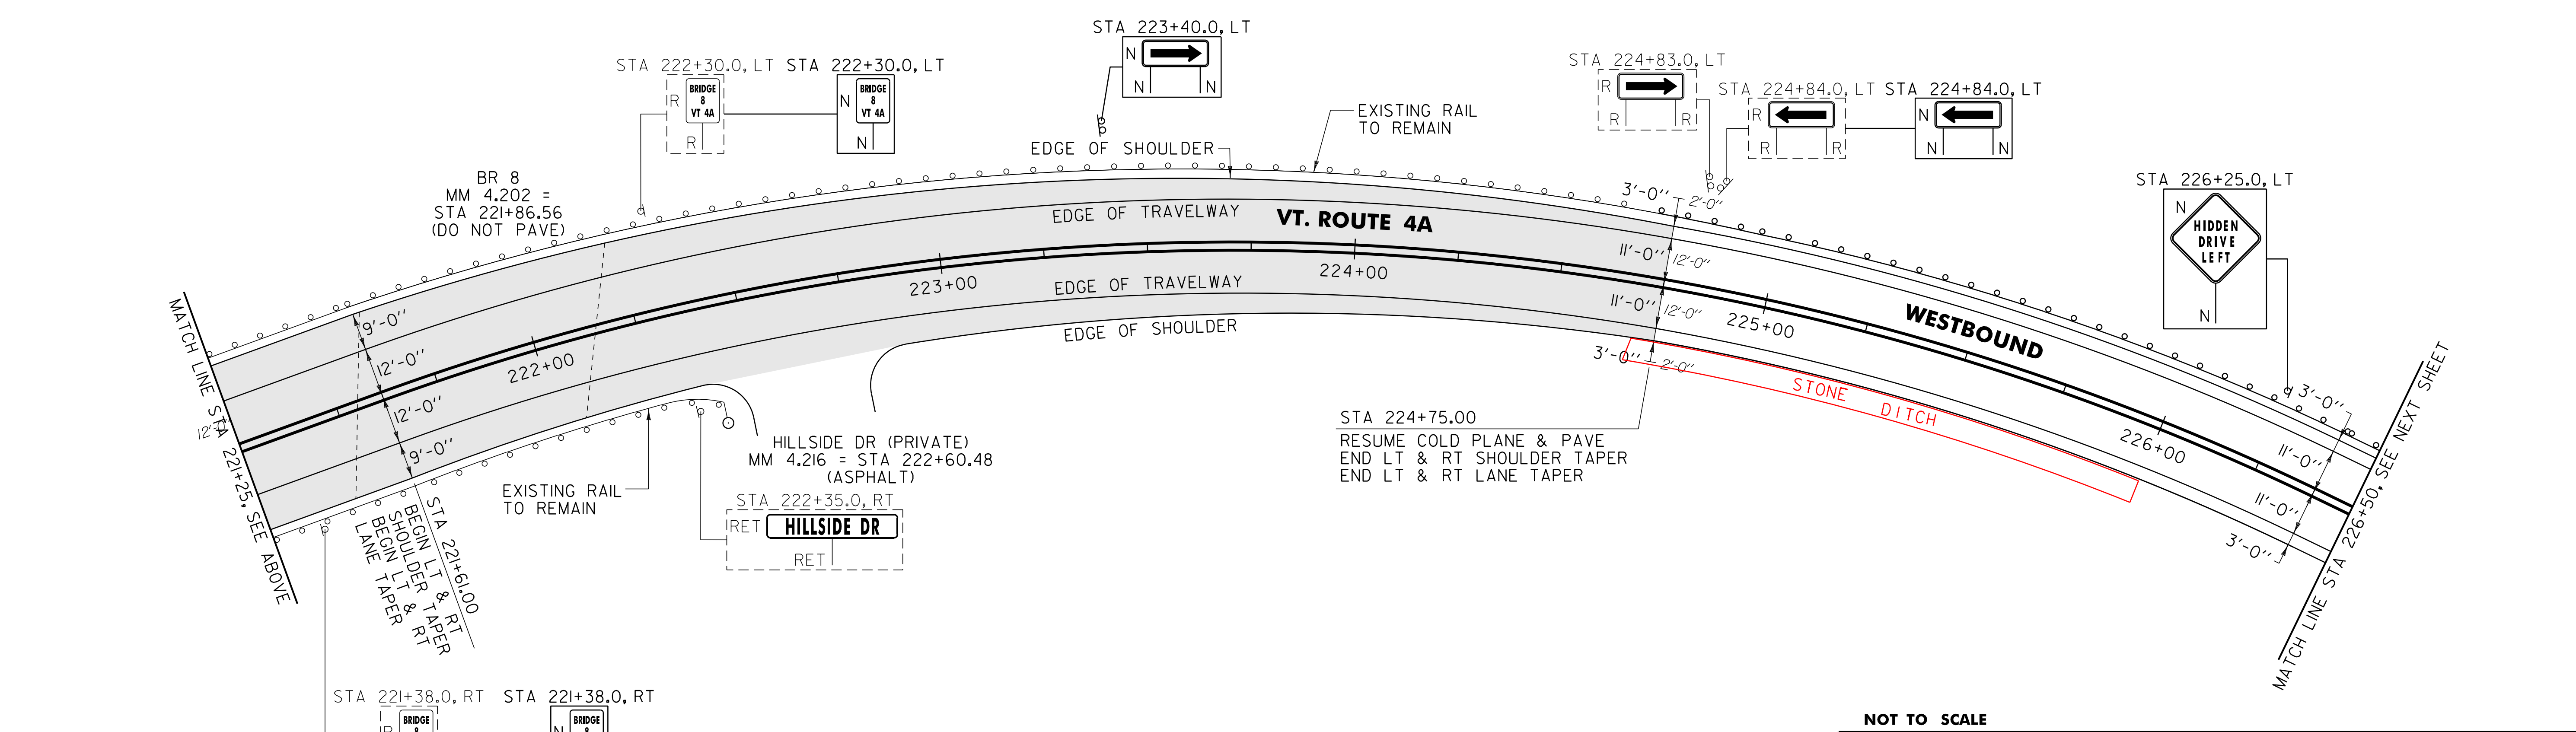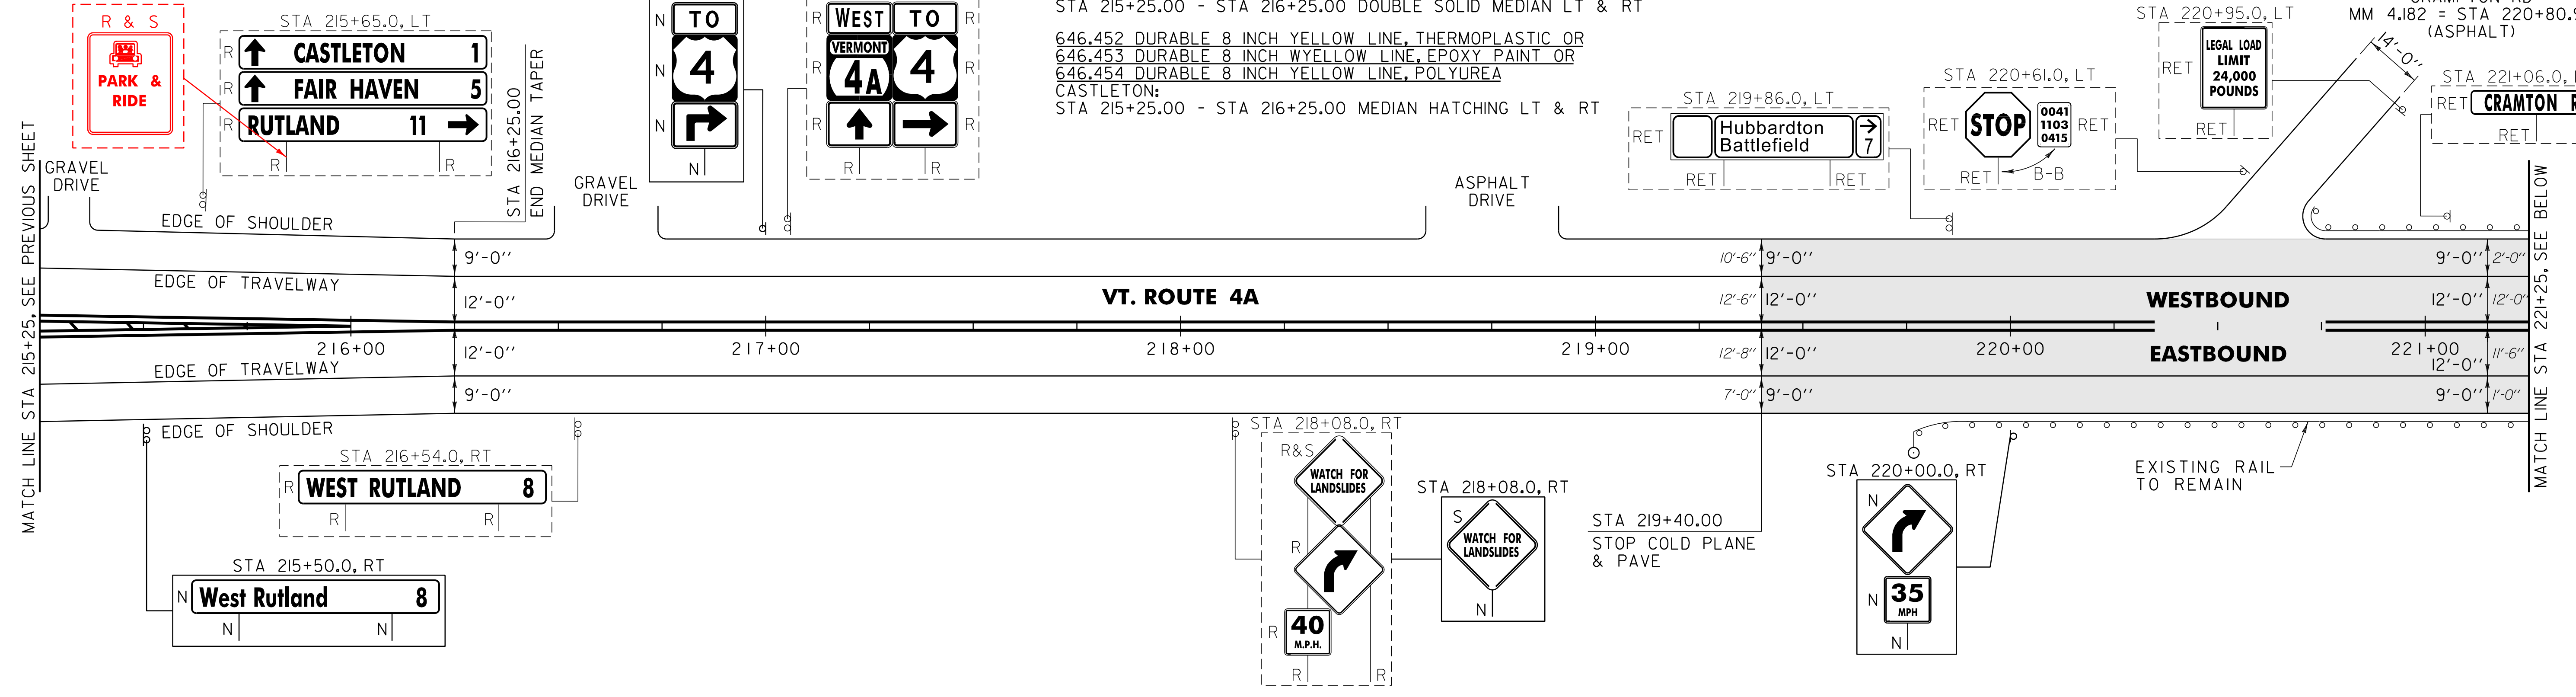

NO PAVING WORK
 TO BE PERFORMED
 IN THIS AREA

621.205 STEEL BEAM GUARDRAIL, GALVANIZED W/8 FEET POSTS
 CASTLETON:
 STA 224+72.0 - STA 226+50.0 LT (178.0 LF)
 621.80 REMOVAL AND DISPOSAL OF GUARDRAIL
 CASTLETON:
 STA 224+72.0 - STA 226+50.0 LT (178.0 LF)

SIGN LEGEND
 R = REMOVE
 S = SALVAGE
 N = NEW
 RET = RETAIN
 B-B = BACK TO BACK
 EXISTING = - - - - -
 NEW = _____

NOT TO SCALE

PROJECT LAYOUT SHEET #3	PROJECT NAME: CASTLETON - WEST RUTLAND	FILE NAME: p07cl68.dgn	PLOT DATE: 04-JUN-2013 09:2
	PROJECT NUMBER: STP 2705(1)	PROJECT LEADER: D.E.G.	DRAWN BY: W.G.P.
		DESIGNED BY: M.J.M.	CHECKED BY: D.E.G.
		IPARM FILE: p07cl68i03.i	SHEET 24 OF 152