

646.402 DURABLE 4 INCH WHITE LINE, THERMOPLASTIC OR  
 646.403 DURABLE 4 INCH WHITE LINE, EPOXY PAINT OR  
 646.404 DURABLE 4 INCH WHITE LINE, POLYUREA  
 (ALL LINES WILL INCLUDE EDGE LINE BREAKS AND  
 RADIUS FOR TOWN HIGHWAYS)  
 IRA:  
 STA 19+25.00 - STA 31+25.00 EDGE LINE LT & RT



646.602 TEMPORARY 4 INCH WHITE LINE, PAINT  
 (ALL LINES WILL INCLUDE EDGE LINE BREAKS AND  
 RADIUS FOR TOWN HIGHWAYS)  
 IRA:  
 STA 19+25.00 - STA 31+25.00 EDGE LINE LT & RT

646.412 DURABLE 4 INCH YELLOW LINE, THERMOPLASTIC OR  
 646.413 DURABLE 4 INCH YELLOW LINE, EPOXY PAINT OR  
 646.414 DURABLE 4 INCH YELLOW LINE, POLYUREA  
 (ALL LINES WILL INCLUDE C/L BREAKS FOR  
 TOWN HIGHWAYS) S=SOLID, D=DASHED  
 IRA:  
 STA 19+25.00 - STA 31+25.00

LT C RT  
 S - S

646.612 TEMPORARY 4 INCH YELLOW LINE, PAINT  
 (ALL LINES WILL INCLUDE C/L BREAKS FOR  
 TOWN HIGHWAYS) S=SOLID, D=DASHED  
 IRA:  
 STA 19+25.00 - STA 31+25.00

LT C RT  
 S - S

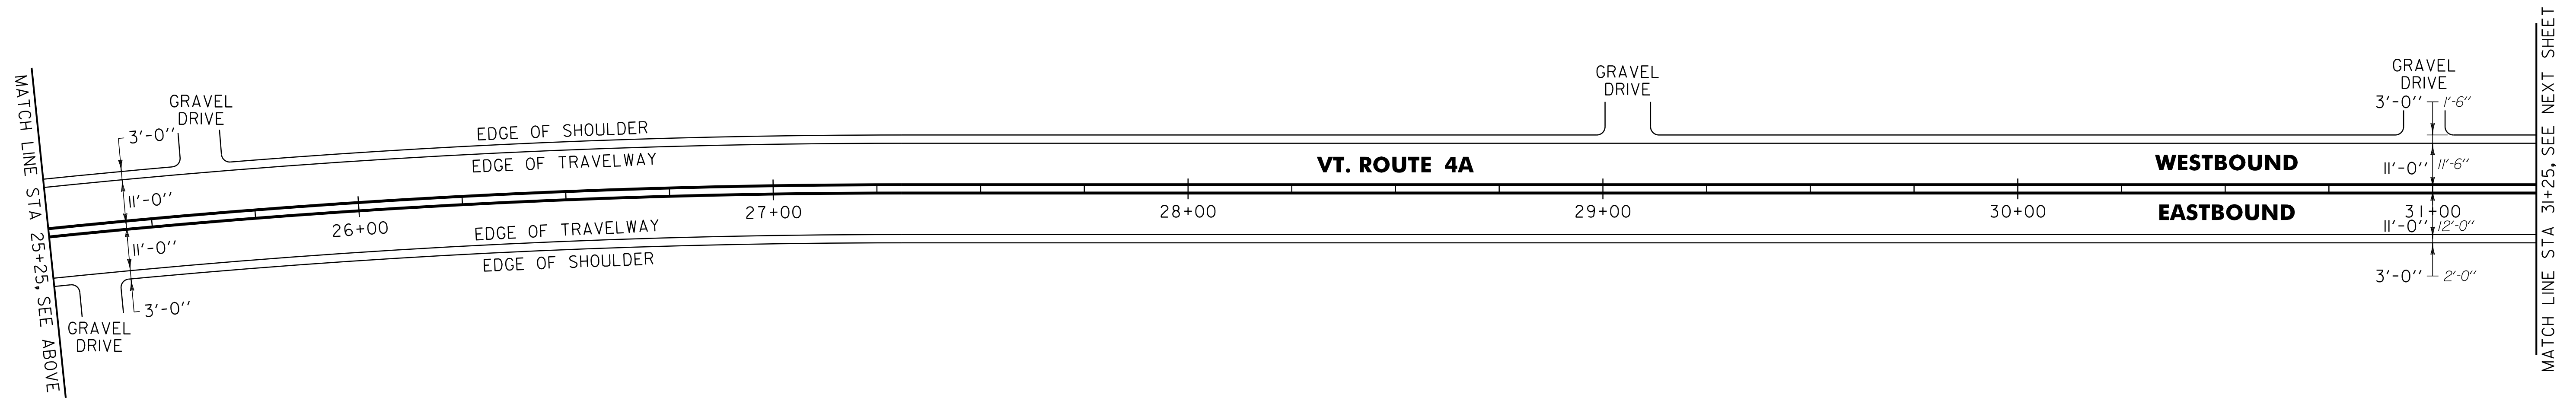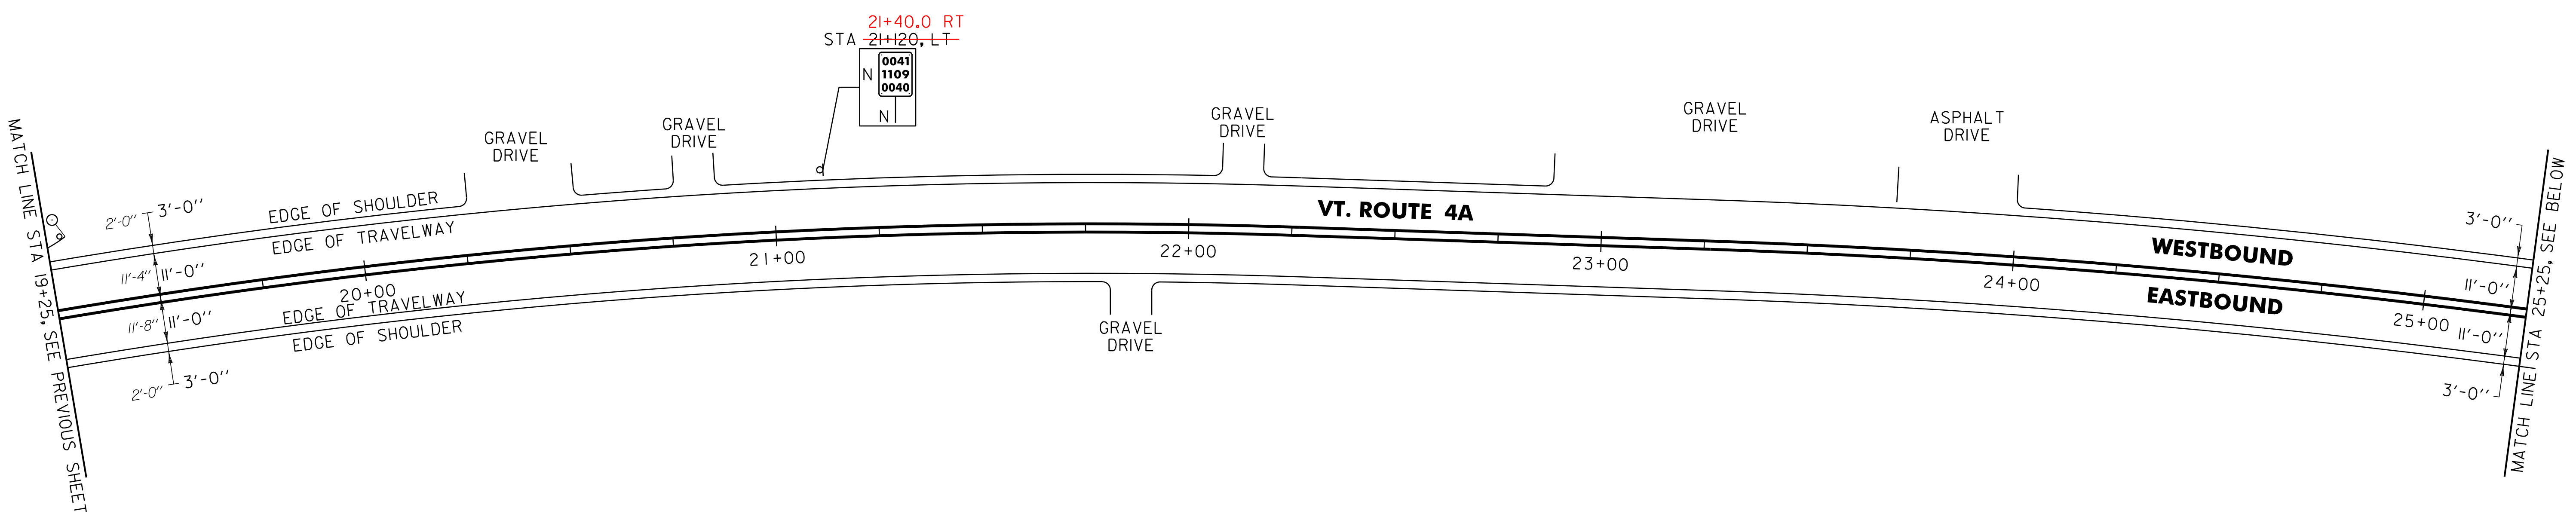

621.20 STEEL BEAM GUARDRAIL, GALVANIZED  
 IRA:  
 STA 19+25.0 - STA 19+32.9 LT (7.9 LF)  
 621.60 ANCHOR FOR STEEL BEAM RAIL  
 CASTLETON:  
 STA 19+26.4 LT  
 676.10 DELINEATOR WITH STEEL POST  
 IRA:  
 STA 19+32.9 LT

**SIGN LEGEND**  
 R = REMOVE  
 S = SALVAGE  
 N = NEW  
 RET = RETAIN  
 B-B = BACK TO BACK  
 EXISTING = - - - - -  
 NEW = \_\_\_\_\_

<b>PROJECT LAYOUT SHEET #18</b>	<b>NOT TO SCALE</b>	
	PROJECT NAME: CASTLETON - WEST RUTLAND	
	PROJECT NUMBER: STP 2705(i)	
	FILE NAME: p07cl68.dgn	PLOT DATE: 04-JUN-2013 09:2
PROJECT LEADER: D.E.G.	DRAWN BY: W.G.P.	
DESIGNED BY: M.J.M.	CHECKED BY: D.E.G.	
IPARM FILE: p07cl68i18.i	SHEET 39 OF 152	