


646.402 DURABLE 4 INCH WHITE LINE, THERMOPLASTIC OR
 646.403 DURABLE 4 INCH WHITE LINE, EPOXY PAINT OR
 646.404 DURABLE 4 INCH WHITE LINE, POLYUREA
 (ALL LINES WILL INCLUDE EDGE LINE BREAKS AND RADIUS FOR TOWN HIGHWAYS)
 IRA:
 STA 43+25.00 - STA 55+25.00 EDGE LINE LT & RT

646.412 DURABLE 4 INCH YELLOW LINE, THERMOPLASTIC OR
 646.413 DURABLE 4 INCH YELLOW LINE, EPOXY PAINT OR
 646.414 DURABLE 4 INCH YELLOW LINE, POLYUREA
 (ALL LINES WILL INCLUDE C/L BREAKS FOR TOWN HIGHWAYS) S=SOLID, D=DASHED
 IRA:
 STA 43+25.00 - STA 55+25.00 LT C RT
 S - S

646.602 TEMPORARY 4 INCH WHITE LINE, PAINT
 (ALL LINES WILL INCLUDE EDGE LINE BREAKS AND RADIUS FOR TOWN HIGHWAYS)
 IRA:
 STA 43+25.00 - STA 55+25.00 EDGE LINE LT & RT

646.612 TEMPORARY 4 INCH YELLOW LINE, PAINT
 (ALL LINES WILL INCLUDE C/L BREAKS FOR TOWN HIGHWAYS) S=SOLID, D=DASHED
 IRA:
 STA 43+25.00 - STA 55+25.00 LT C RT
 S - S

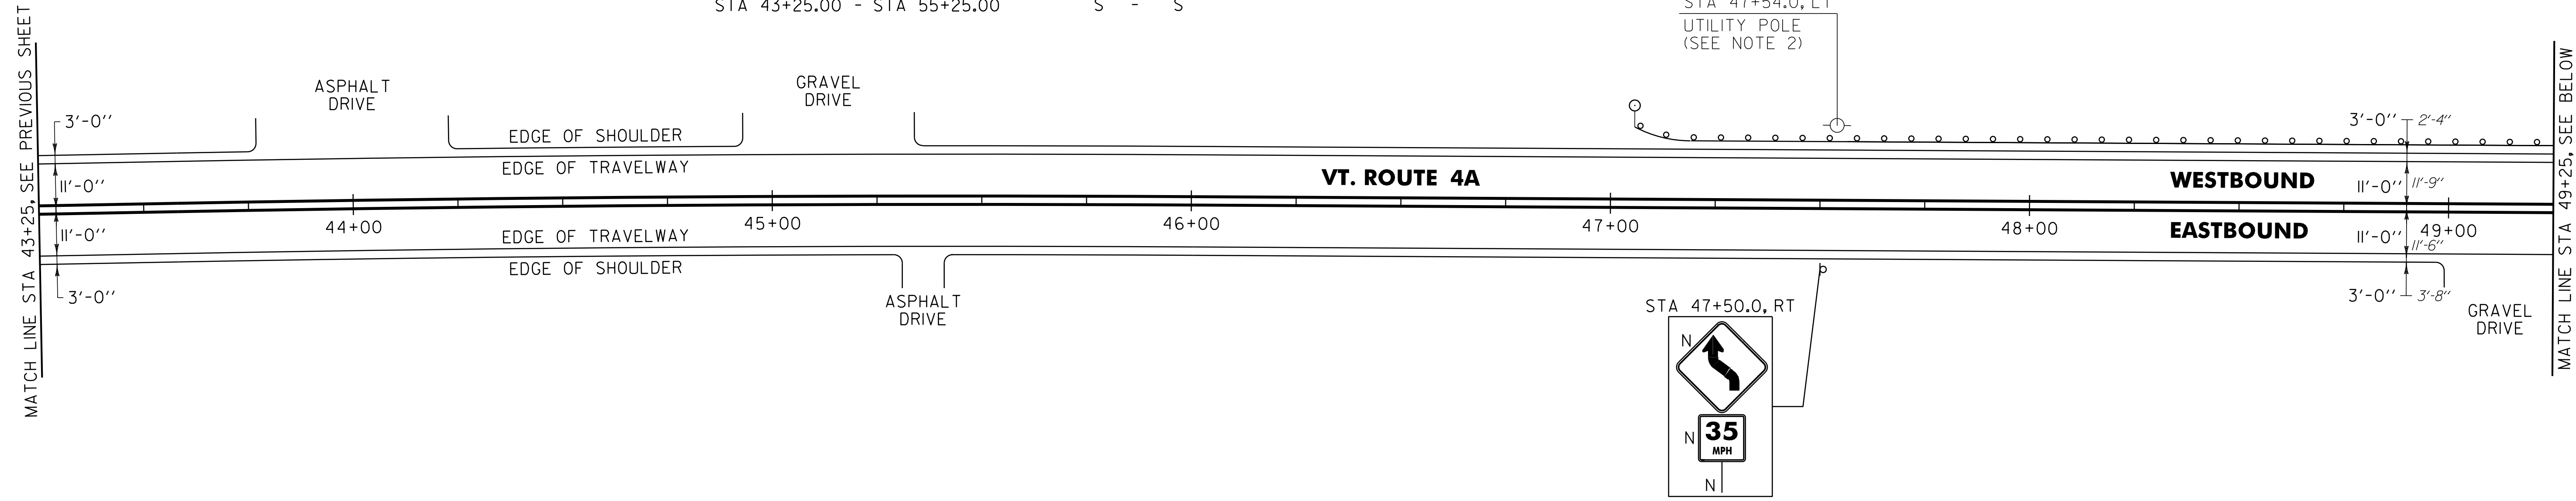

62L20 STEEL BEAM GUARDRAIL, GALVANIZED
 IRA:
 STA 49+68.3 - STA 50+20.3 RT (52.0 LF)
 STA 51+07.8 - STA 51+47.3 RT (39.5 LF)

62L205 STEEL BEAM GUARDRAIL, GALVANIZED W/8 FEET POSTS
 IRA:
 STA 47+05.8 - STA 50+20.3 LT (334.5 LF)
 STA 51+07.8 - STA 55+25.0 LT (417.2 LF)


62L216 HD STEEL BEAM GUARDRAIL, GALVANIZED/NESTED
 IRA:
 STA 50+20.3 - STA 51+07.8 RT (87.5 LF)

62L217 HD STEEL BEAM GUARDRAIL, GALVANIZED/NESTED W/8 FEET POSTS
 IRA:
 STA 50+20.3 - STA 51+07.8 LT (87.5 LF)

62L60 ANCHOR FOR STEEL BEAM GUARDRAIL
 IRA:
 STA 47+12.3 LT
 STA 49+74.8 RT
 STA 51+40.8 RT

62L80 REMOVAL AND DISPOSAL OF GUARDRAIL
 IRA:
 STA 47+48.0 - STA 55+25.0 LT (777.0 LF)
 STA 49+72.0 - STA 51+37.0 RT (165.0 LF)

676.10 DELINEATOR WITH STEEL POST
 IRA:
 STA 47+05.8 LT
 STA 49+68.3 RT
 STA 51+47.3 RT

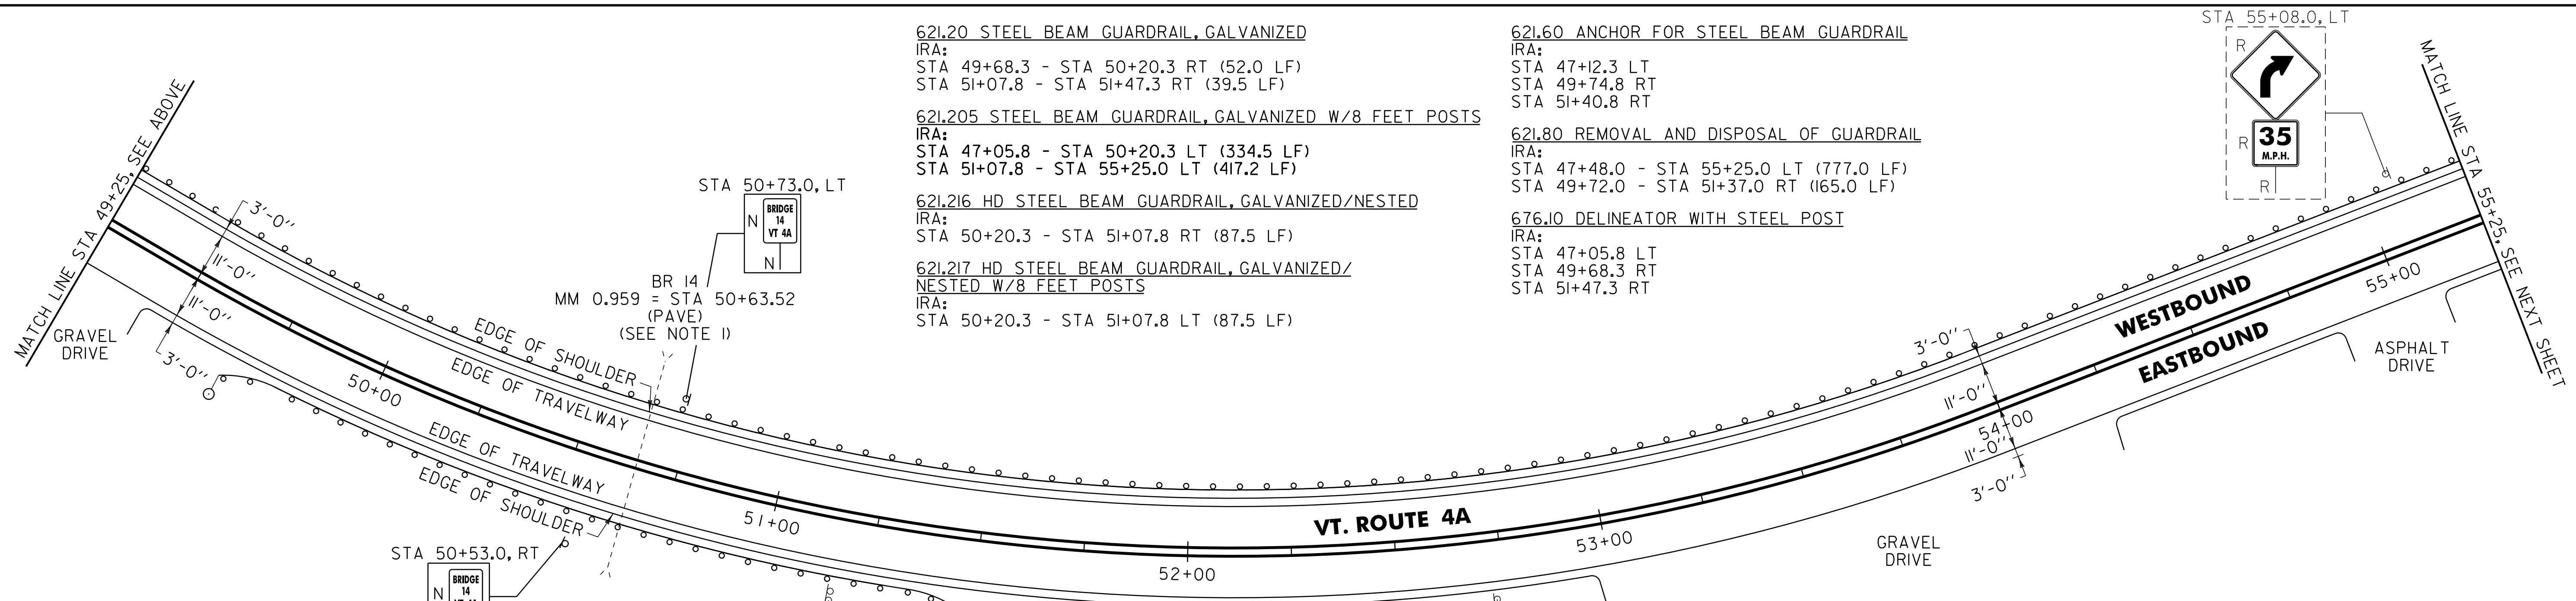

- NOTES:
- SEE SHEET 9 FOR DOUBLE-NESTED GUARDRAIL SYSTEM.
 - SEE SHEET 10 FOR REDUCED STEEL BEAM GUARDRAIL POST SPACING AT UTILITY POLE DETAIL.

SIGN LEGEND
 R = REMOVE
 S = SALVAGE
 N = NEW
 RET = RETAIN
 B-B = BACK TO BACK
 EXISTING = _____
 NEW = _____

PROJECT LAYOUT SHEET #20	NOT TO SCALE	
	PROJECT NAME: CASTLETON - WEST RUTLAND	PROJECT NUMBER: STP 2705(1)
	FILE NAME: p07cl68.dgn	PLOT DATE: 04-JUN-2013 09:2
	PROJECT LEADER: D.E.G.	DRAWN BY: W.G.P.
DESIGNED BY: M.J.M.	CHECKED BY: D.E.G.	
IPARM FILE: p07cl68i20.i	SHEET 41 OF 152	