

646.402 DURABLE 4 INCH WHITE LINE, THERMOPLASTIC OR  
646.403 DURABLE 4 INCH WHITE LINE, EPOXY PAINT OR  
646.404 DURABLE 4 INCH WHITE LINE, POLYUREA  
(ALL LINES WILL INCLUDE EDGE LINE BREAKS AND  
RADIUS FOR TOWN HIGHWAYS)  
IRA:  
STA 55+25.00 - STA 61+25.00 EDGE LINE LT & RT


646.412 DURABLE 4 INCH YELLOW LINE, THERMOPLASTIC OR  
646.413 DURABLE 4 INCH YELLOW LINE, EPOXY PAINT OR  
646.414 DURABLE 4 INCH YELLOW LINE, POLYUREA  
(ALL LINES WILL INCLUDE C/L BREAKS FOR  
TOWN HIGHWAYS) S=SOLID, D=DASHED  
IRA:  
STA 55+25.00 - STA 61+25.00

646.602 TEMPORARY 4 INCH WHITE LINE, PAINT  
(ALL LINES WILL INCLUDE EDGE LINE BREAKS AND  
RADIUS FOR TOWN HIGHWAYS)  
IRA:  
STA 55+25.00 - STA 61+25.00 EDGE LINE LT & RT

646.612 TEMPORARY 4 INCH YELLOW LINE, PAINT  
(ALL LINES WILL INCLUDE C/L BREAKS FOR  
TOWN HIGHWAYS) S=SOLID, D=DASHED  
IRA:  
STA 55+25.00 - STA 61+25.00

LT C RT  
S - S

LT C RT  
S - S

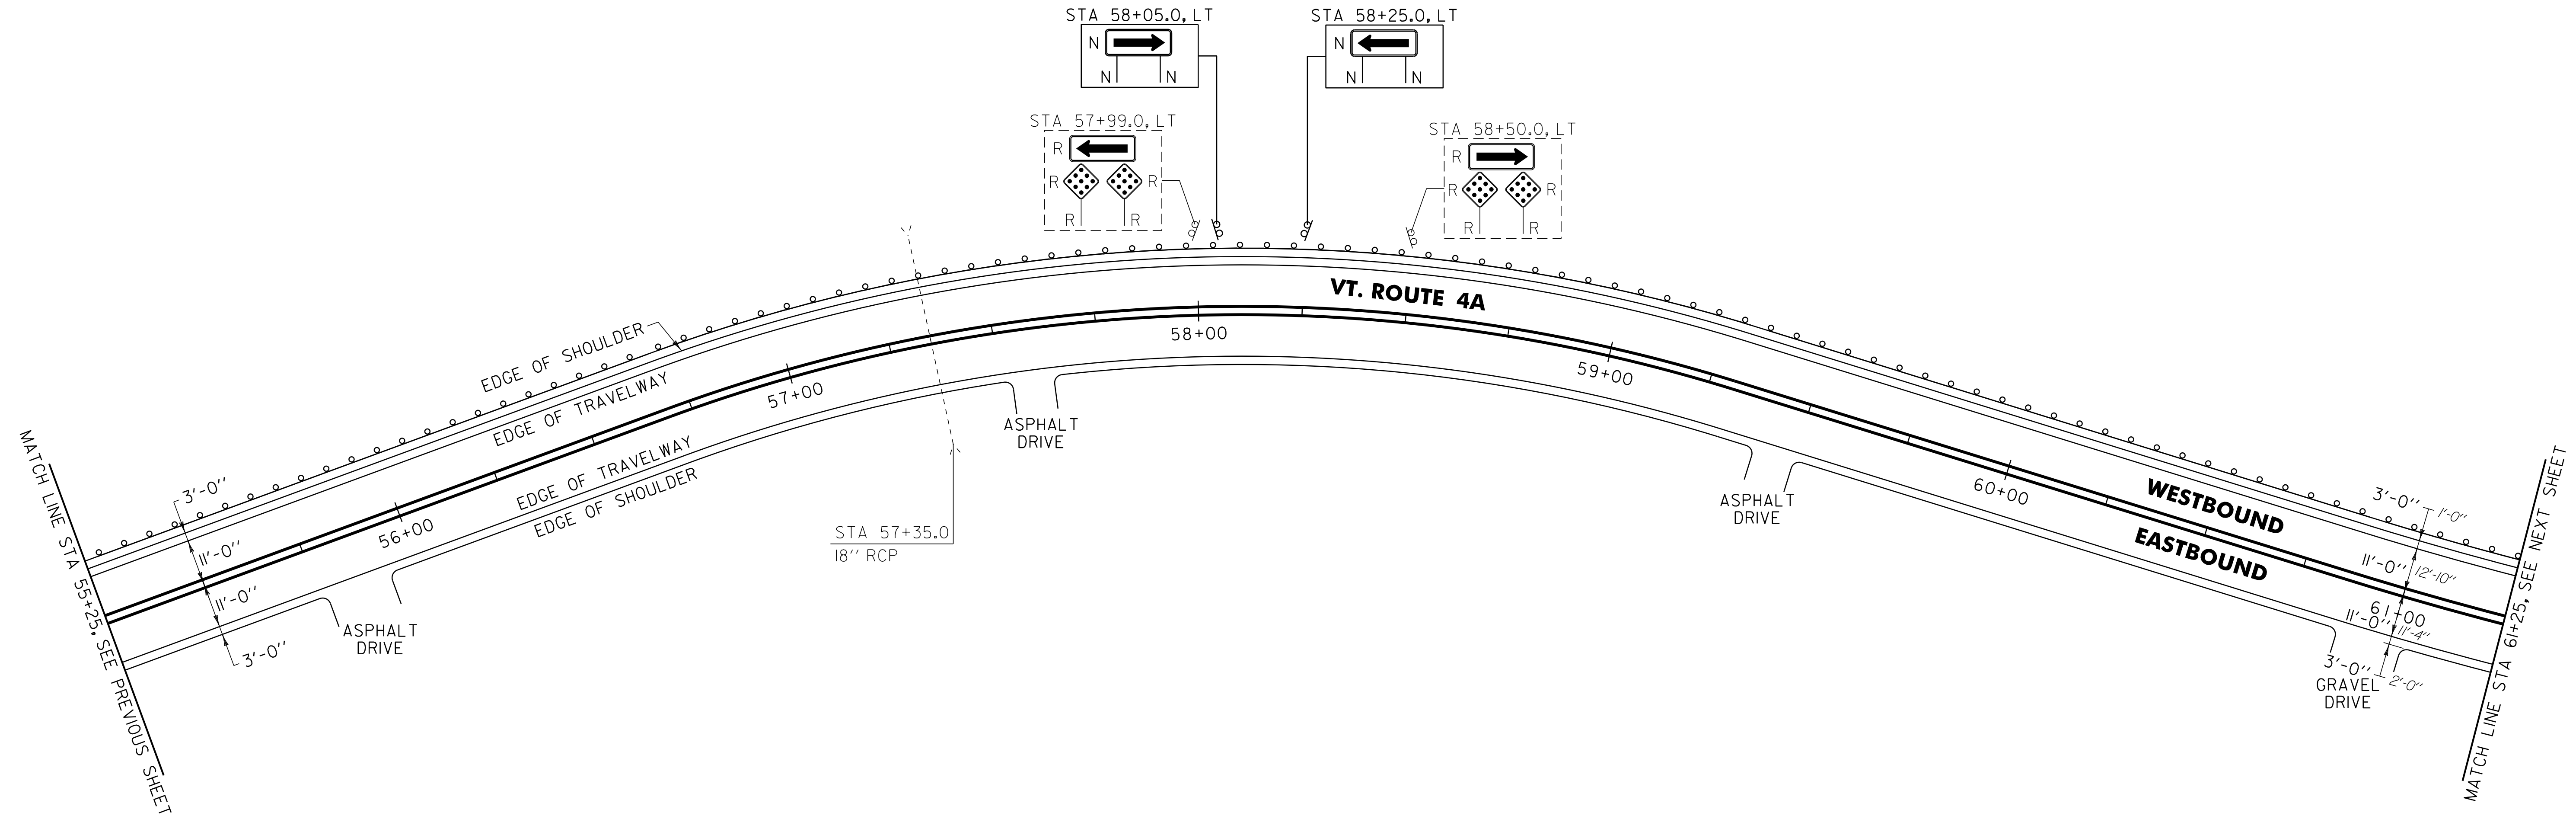

62L205 STEEL BEAM GUARDRAIL, GALVANIZED W/8 FEET POSTS  
IRA:  
STA 55+25.0 - STA 61+25.0 LT (600.0 LF)

62L80 REMOVAL AND DISPOSAL OF GUARDRAIL  
IRA:  
STA 55+25.0 - STA 61+25.0 (600.0 LF)

**SIGN LEGEND**  
R = REMOVE  
S = SALVAGE  
N = NEW  
RET = RETAIN  
B-B = BACK TO BACK  
EXISTING = - - - - -  
NEW = \_\_\_\_\_

NOT TO SCALE

<b>PROJECT LAYOUT SHEET #21</b>	PROJECT NAME: CASTLETON - WEST RUTLAND	FILE NAME: p07cl68.dgn	PLOT DATE: 04-JUN-2013 09:2
	PROJECT NUMBER: STP 2705(i)	PROJECT LEADER: D.E.G.	DRAWN BY: W.G.P.
		DESIGNED BY: M.J.M.	CHECKED BY: D.E.G.
		IPARM FILE: p07cl68i21.i	SHEET 42 OF 152