

646.402 DURABLE 4 INCH WHITE LINE, THERMOPLASTIC OR
 646.403 DURABLE 4 INCH WHITE LINE, EPOXY PAINT OR
 646.404 DURABLE 4 INCH WHITE LINE, POLYUREA
 (ALL LINES WILL INCLUDE EDGE LINE BREAKS AND
 RADIUS FOR TOWN HIGHWAYS)
 WEST RUTLAND:
 STA 4+25.00 - STA 16+25.00 EDGE LINE LT & RT

646.412 DURABLE 4 INCH YELLOW LINE, THERMOPLASTIC OR
 646.413 DURABLE 4 INCH YELLOW LINE, EPOXY PAINT OR
 646.414 DURABLE 4 INCH YELLOW LINE, POLYUREA
 (ALL LINES WILL INCLUDE C/L BREAKS FOR
 TOWN HIGHWAYS) S=SOLID, D=DASHED
 WEST RUTLAND:
 STA 4+25.00 - STA 5+80.00 S - D
 STA 5+80.00 - STA 13+72.00 D - S
 STA 13+72.00 - STA 16+25.00 S - S


646.602 TEMPORARY 4 INCH WHITE LINE, PAINT
 (ALL LINES WILL INCLUDE EDGE LINE BREAKS AND
 RADIUS FOR TOWN HIGHWAYS)
 WEST RUTLAND:
 STA 4+25.00 - STA 16+25.00 EDGE LINE LT & RT

646.612 TEMPORARY 4 INCH YELLOW LINE, PAINT
 (ALL LINES WILL INCLUDE C/L BREAKS FOR
 TOWN HIGHWAYS) S=SOLID, D=DASHED
 WEST RUTLAND:
 STA 4+25.00 - STA 5+80.00 LT C RT
 S - D
 STA 5+80.00 - STA 13+72.00 D - S
 STA 13+72.00 - STA 16+25.00 S - S

675.50 REMOVING SIGNS
 AS SHOWN - 1


MATCH LINE STA 4+25, SEE PREVIOUS SHEET

MATCH LINE STA 10+25, SEE BELOW

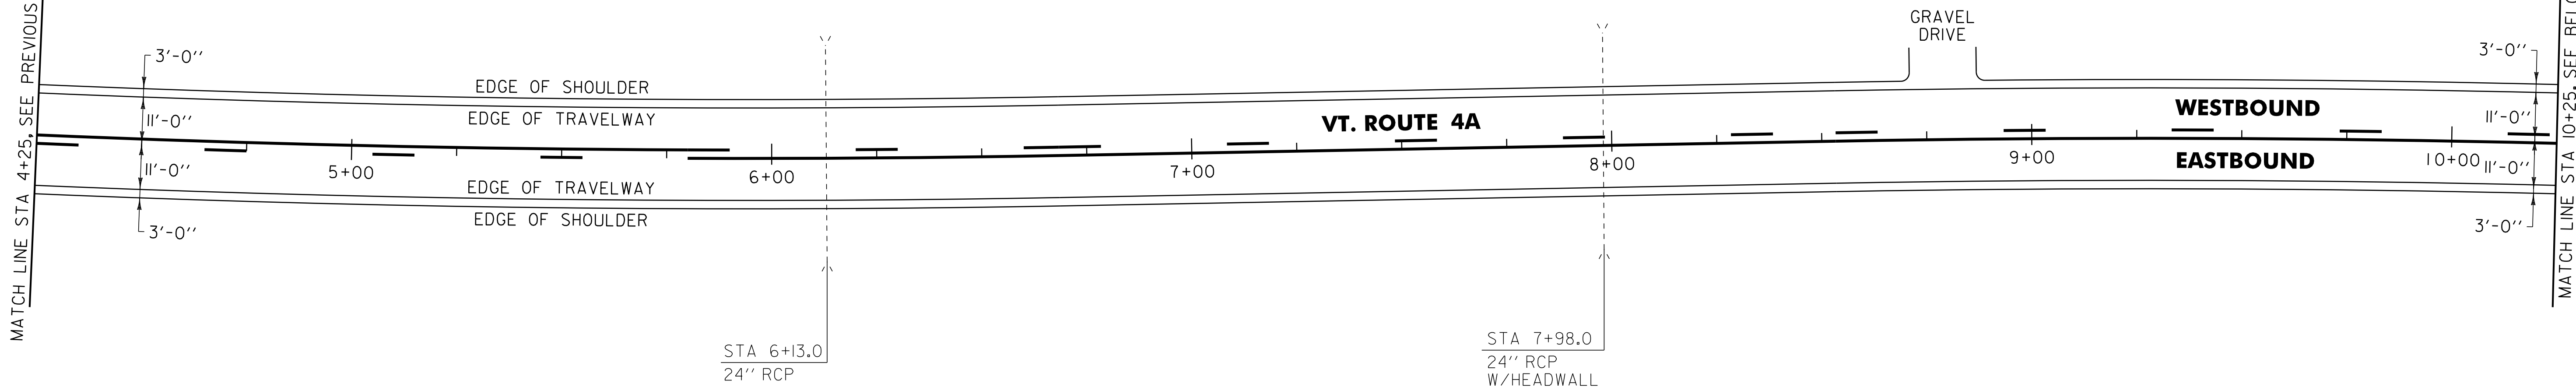

MATCH LINE STA 10+25, SEE ABOVE

MATCH LINE STA 16+25, SEE NEXT SHEET

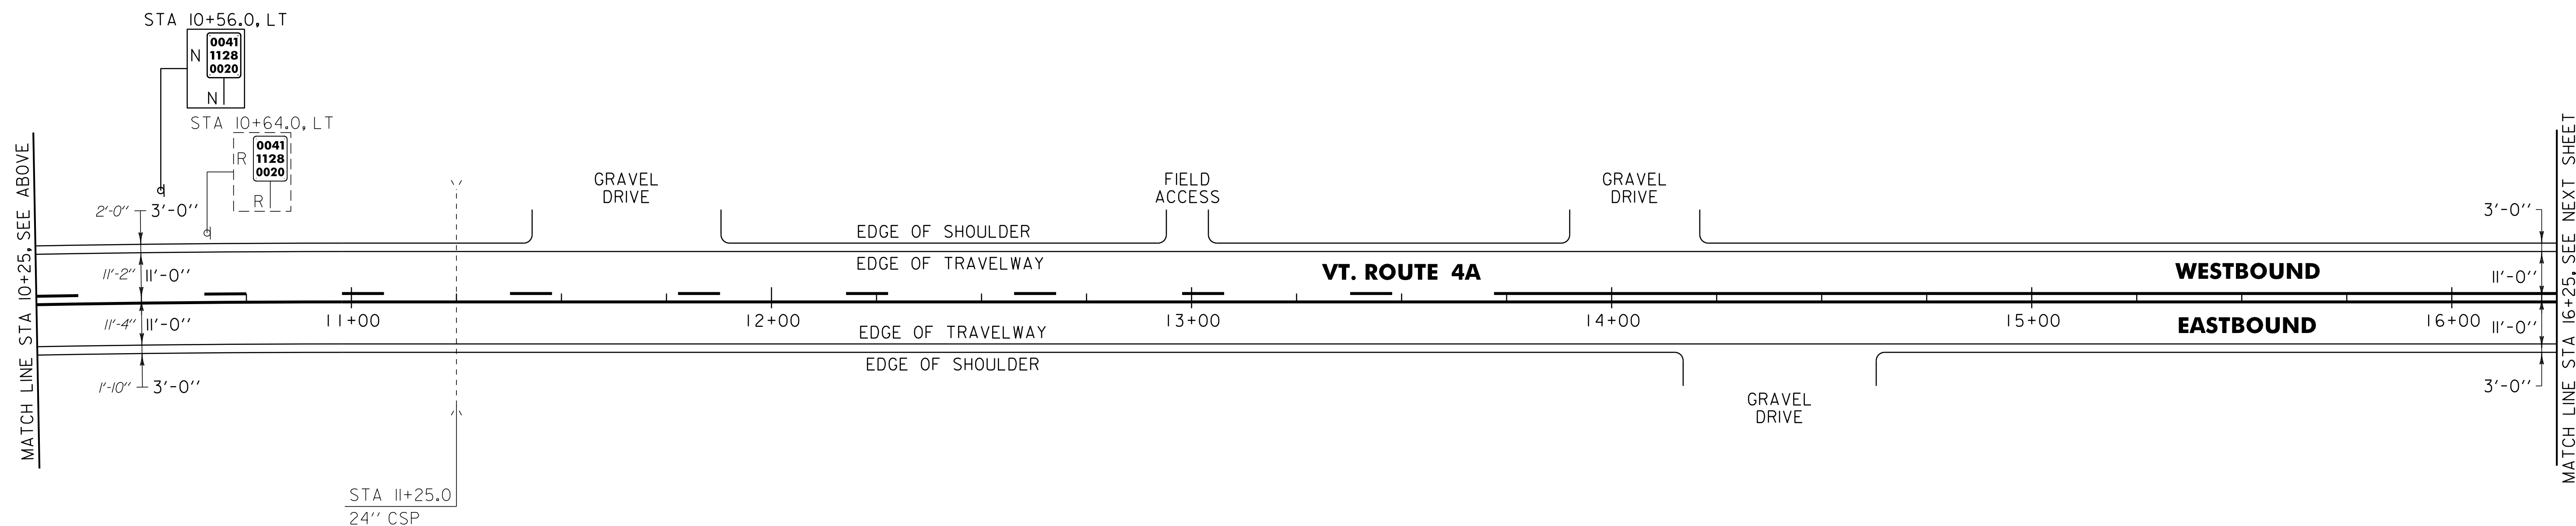

SIGN LEGEND
 R = REMOVE
 S = SALVAGE
 N = NEW
 RET = RETAIN
 B-B = BACK TO BACK
 EXISTING = - - - - -
 NEW = _____

NOT TO SCALE

PROJECT LAYOUT SHEET #23	PROJECT NAME: CASTLETON - WEST RUTLAND	PLOT DATE: 04-JUN-2013 09:2
	PROJECT NUMBER: STP 2705(i)	DRAWN BY: W.G.P.
	FILE NAME: p07cl68.dgn	CHECKED BY: D.E.G.
	DESIGNED BY: M.J.M.	SHEET 44 OF 152
	IPARM FILE: p07cl68i23.i	