

646.402 DURABLE 4 INCH WHITE LINE, THERMOPLASTIC OR
 646.403 DURABLE 4 INCH WHITE LINE, EPOXY PAINT OR
 646.404 DURABLE 4 INCH WHITE LINE, POLYUREA
 (ALL LINES WILL INCLUDE EDGE LINE BREAKS AND
 RADIUS FOR TOWN HIGHWAYS)
 WEST RUTLAND:
 STA 16+25.00 - STA 28+25.00 EDGE LINE LT & RT

646.412 DURABLE 4 INCH YELLOW LINE, THERMOPLASTIC OR
 646.413 DURABLE 4 INCH YELLOW LINE, EPOXY PAINT OR
 646.414 DURABLE 4 INCH YELLOW LINE, POLYUREA
 (ALL LINES WILL INCLUDE C/L BREAKS FOR
 TOWN HIGHWAYS) S=SOLID, D=DASHED
 WEST RUTLAND:
 STA 16+25.00 - STA 28+25.00

	LT	C	RT
	S	-	S


646.602 TEMPORARY 4 INCH WHITE LINE, PAINT
 (ALL LINES WILL INCLUDE EDGE LINE BREAKS AND
 RADIUS FOR TOWN HIGHWAYS)
 WEST RUTLAND:
 STA 16+25.00 - STA 28+25.00 EDGE LINE LT & RT

646.612 TEMPORARY 4 INCH YELLOW LINE, PAINT
 (ALL LINES WILL INCLUDE C/L BREAKS FOR
 TOWN HIGHWAYS) S=SOLID, D=DASHED
 WEST RUTLAND:
 STA 16+25.00 - STA 28+25.00

	LT	C	RT
	S	-	S


MATCH LINE STA 16+25, SEE PREVIOUS SHEET

MATCH LINE STA 22+25, SEE BELOW

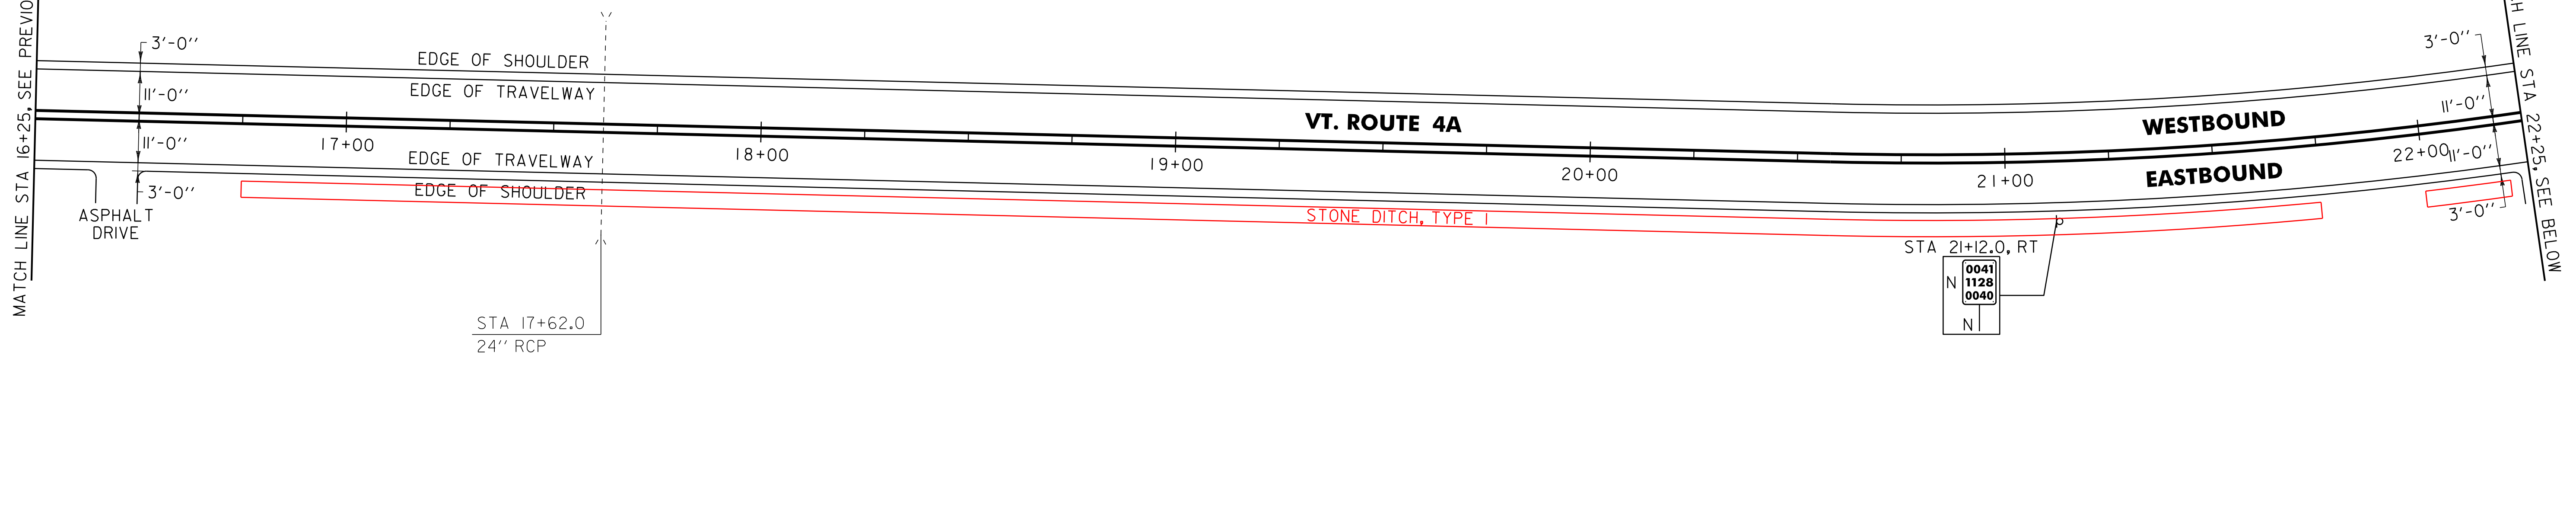

MATCH LINE STA 22+25, SEE ABOVE

MATCH LINE STA 28+25, SEE NEXT SHEET

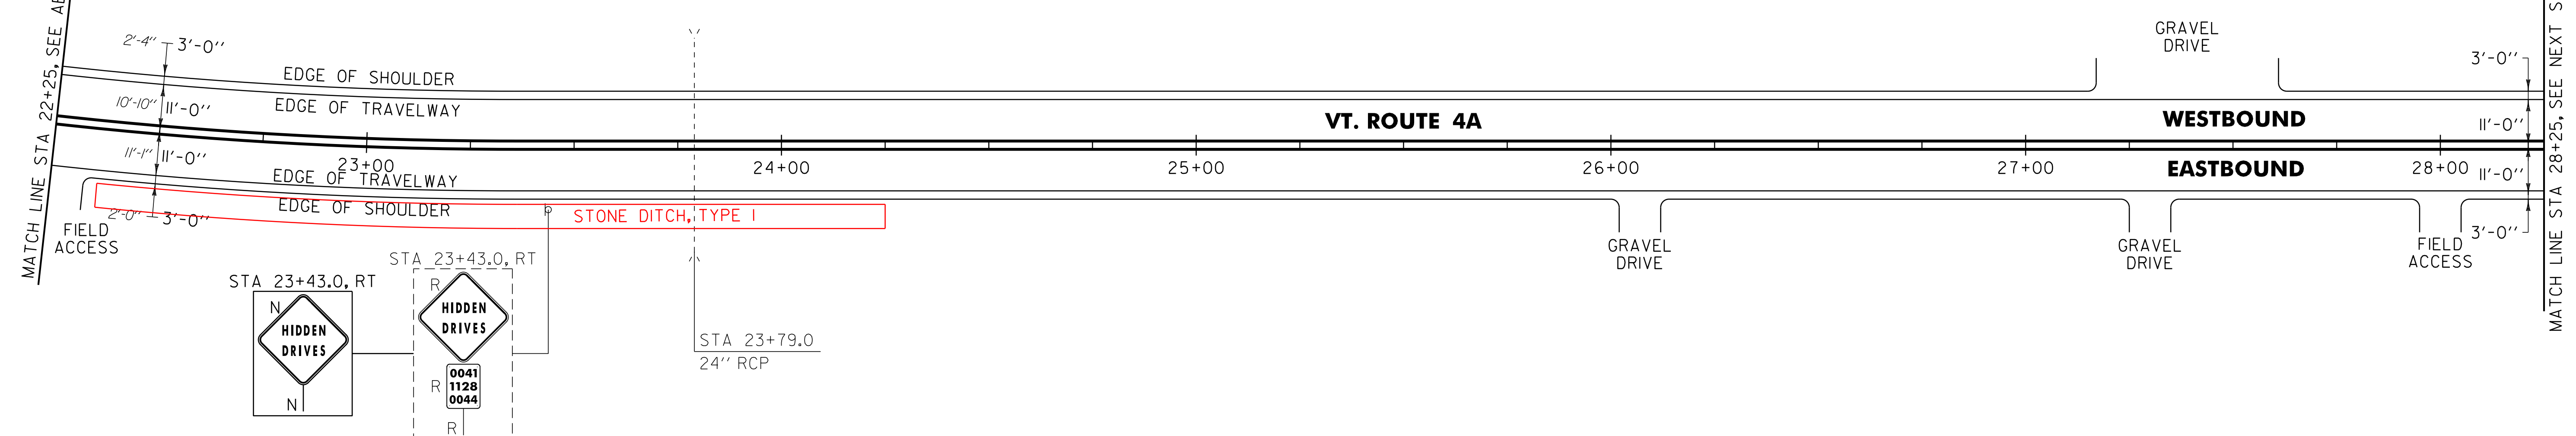

SIGN LEGEND
 R = REMOVE
 S = SALVAGE
 N = NEW
 RET = RETAIN
 B-B = BACK TO BACK
 EXISTING = - - - - -
 NEW = _____

PROJECT LAYOUT SHEET #24	NOT TO SCALE	
	PROJECT NAME: CASTLETON - WEST RUTLAND	PROJECT NUMBER: STP 2705(1)
	FILE NAME: p07cl68.dgn	PLOT DATE: 04-JUN-2013 09:2
	PROJECT LEADER: D.E.G. DESIGNED BY: M.J.M. IPARM FILE: p07cl68l24.i	DRAWN BY: W.G.P. CHECKED BY: D.E.G. SHEET 45 OF 152