
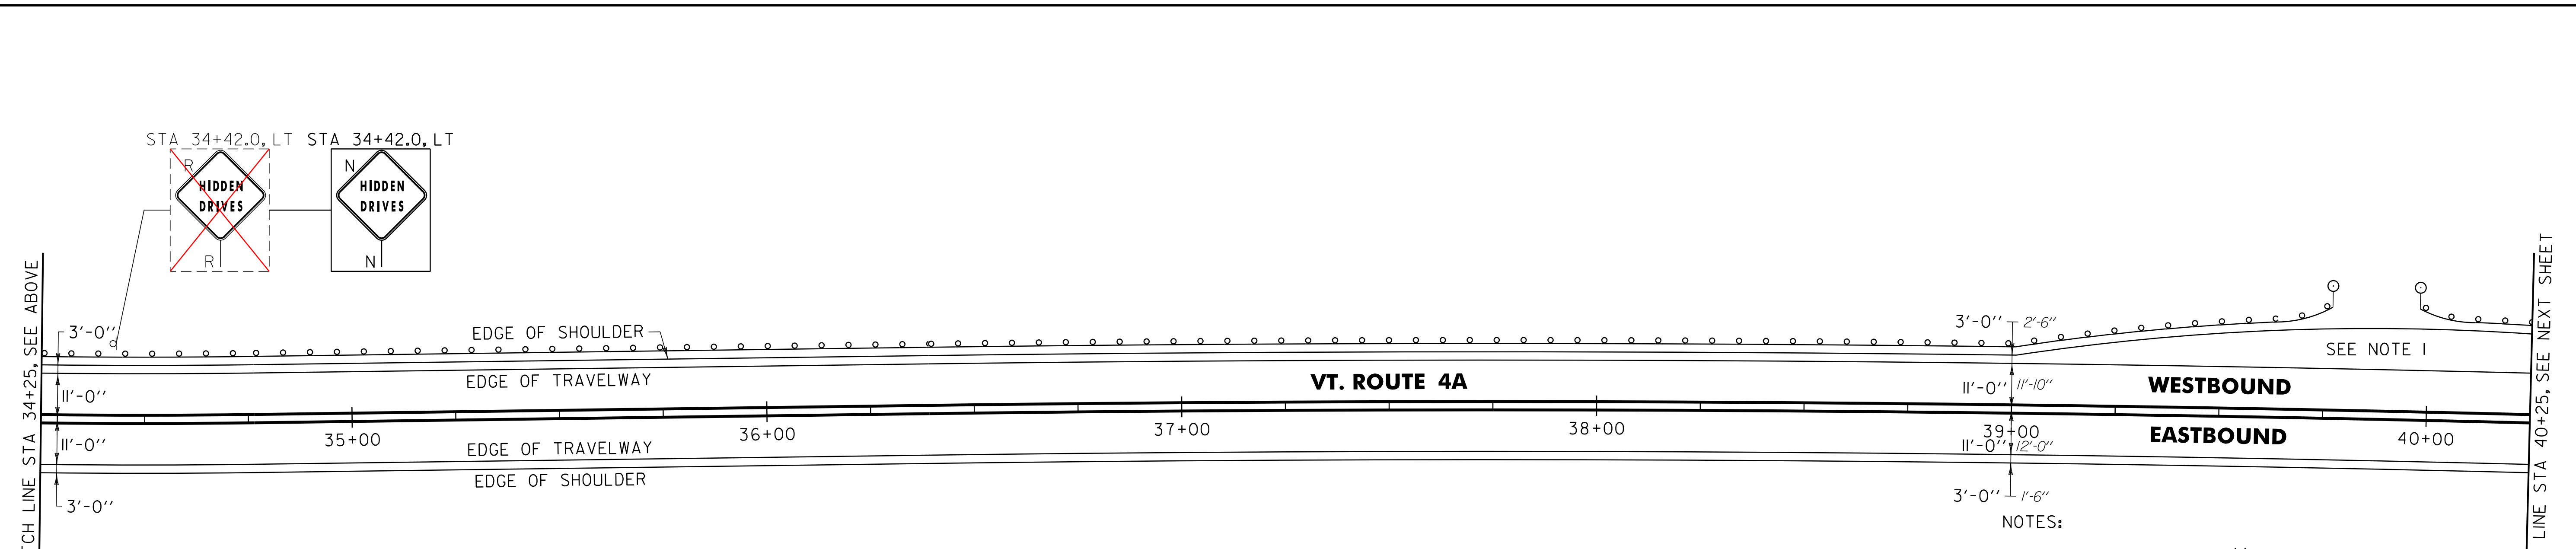


646.402 DURABLE 4 INCH WHITE LINE, THERMOPLASTIC OR
 646.403 DURABLE 4 INCH WHITE LINE, EPOXY PAINT OR
 646.404 DURABLE 4 INCH WHITE LINE, POLYUREA
 (ALL LINES WILL INCLUDE EDGE LINE BREAKS AND RADIUS FOR TOWN HIGHWAYS)
 WEST RUTLAND:
 STA 28+25.00 - STA 40+25.00 EDGE LINE LT & RT

646.412 DURABLE 4 INCH YELLOW LINE, THERMOPLASTIC OR
 646.413 DURABLE 4 INCH YELLOW LINE, EPOXY PAINT OR
 646.414 DURABLE 4 INCH YELLOW LINE, POLYUREA
 (ALL LINES WILL INCLUDE C/L BREAKS FOR TOWN HIGHWAYS) S=SOLID, D=DASHED
 WEST RUTLAND:
 STA 28+25.00 - STA 40+25.00

646.602 TEMPORARY 4 INCH WHITE LINE, PAINT
 (ALL LINES WILL INCLUDE EDGE LINE BREAKS AND RADIUS FOR TOWN HIGHWAYS)
 WEST RUTLAND:
 STA 28+25.00 - STA 40+25.00 EDGE LINE LT & RT

646.612 TEMPORARY 4 INCH YELLOW LINE, PAINT
 (ALL LINES WILL INCLUDE C/L BREAKS FOR TOWN HIGHWAYS) S=SOLID, D=DASHED
 WEST RUTLAND:
 STA 28+25.00 - STA 40+25.00

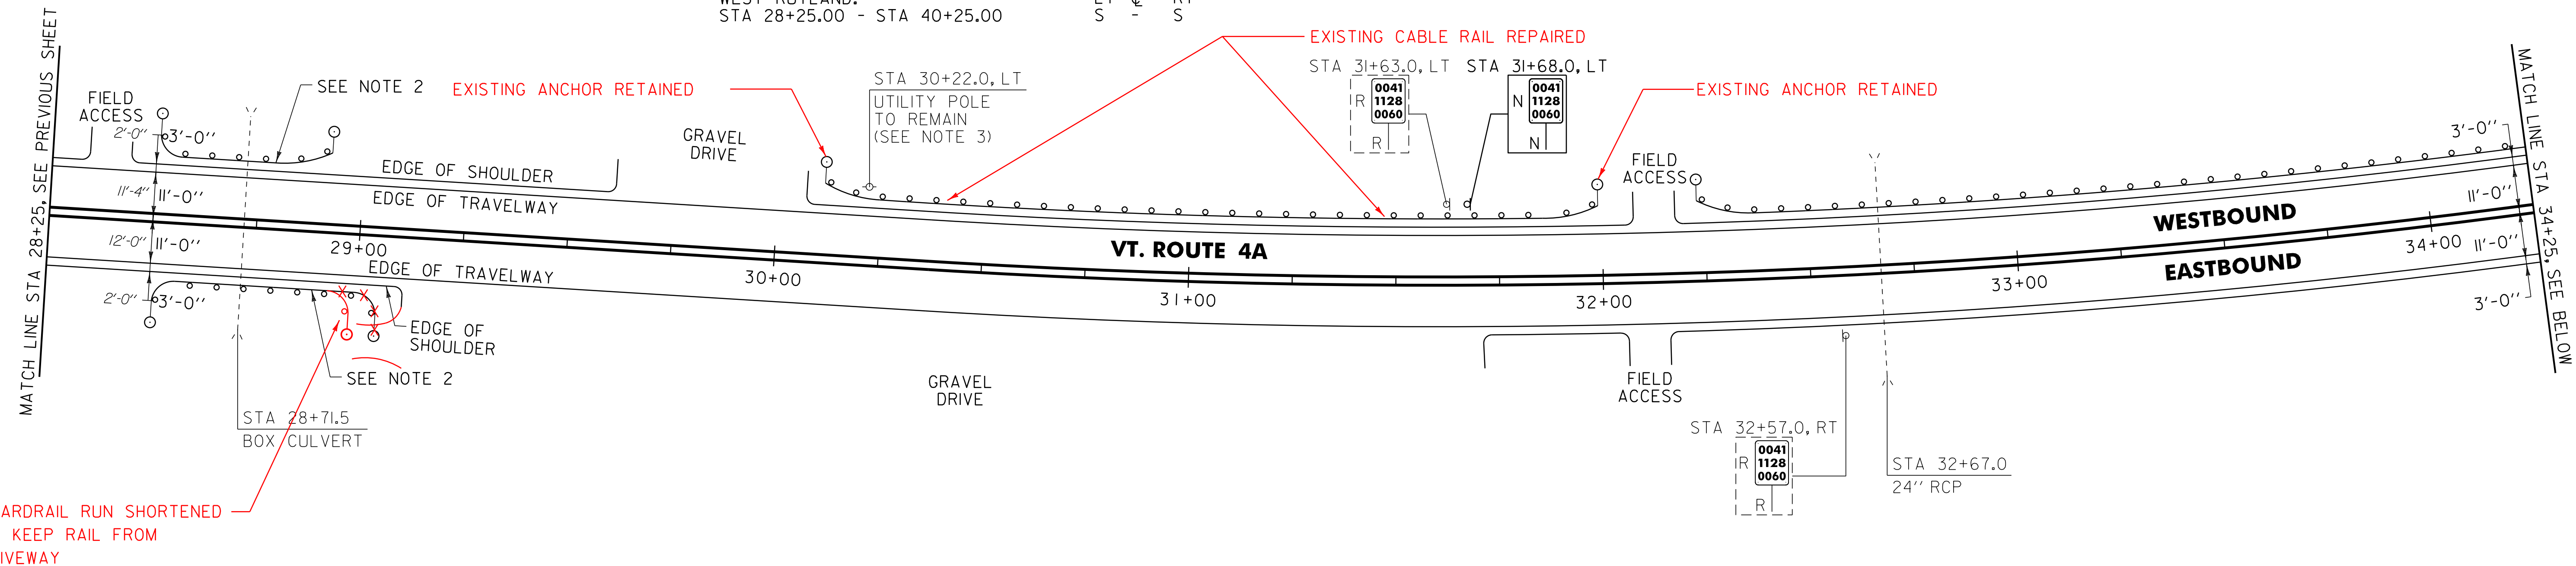

621.20 STEEL BEAM GUARDRAIL, GALVANIZED
 WEST RUTLAND:
 STA 28+47.7 - STA 28+89.2 LT (41.5 LF)
 STA 28+47.7 - STA 29+01.7 RT (54.0 LF)
 STA 30+07.5 - STA 31+99.0 LT (206.5 LF)

621.205 STEEL BEAM GUARDRAIL, GALVANIZED W/8 FEET POSTS
 WEST RUTLAND:
 STA 32+23.0 - STA 39+77.0 LT (754.0 LF)
 STA 39+98.0 - STA 40+25.0 LT (27.0 LF)

621.60 ANCHOR FOR STEEL BEAM RAIL
 WEST RUTLAND:
 STA 28+54.2 RT
 STA 28+54.2 LT
 STA 28+82.7 LT
 STA 28+95.2 RT
 STA 28+95.2 LT
 STA 30+14.0 LT - EXISTING ANCHORS
 STA 31+92.5 LT - RETAINED
 STA 32+38.0 LT

621.80 REMOVAL AND DISPOSAL OF GUARDRAIL
 WEST RUTLAND:
 STA 28+52.0 - STA 28+89.0 LT (37.0 LF)
 STA 28+58.0 - STA 28+96.0 RT (38.0 LF)
~~STA 30+36.0 - STA 31+99.0 LT (163.0 LF)~~ - EXISTING CABLE RAIL AND ANCHORS
 STA 32+25.0 - STA 39+73.0 LT (748.0 LF)
 STA 40+00.0 - STA 40+25.0 LT (25.0 LF)

676.10 DELINEATOR WITH STEEL POST
 WEST RUTLAND:
 STA 28+47.7 RT
 STA 28+53.9 LT
 STA 28+95.4 LT
 STA 29+01.7 RT
 STA 30+07.5 LT
 STA 31+99.0 LT
 STA 32+23.0 LT
 STA 39+77.0 LT
 STA 39+98.0 LT

SIGN LEGEND
 R = REMOVE
 S = SALVAGE
 N = NEW
 RET = RETAIN
 B-B = BACK TO BACK
 EXISTING = - - - - -
 NEW = _____

- NOTES:
- PROVIDE A 4 FT WIDE, 1/2" TYPE IVS APRON FOR THE EXISTING GRAVEL PULLOUT. ANY REQUIRED EXCAVATION SHALL BE PERFORMED AS DIRECTED BY THE RESIDENT ENGINEER AND PAID FOR UNDER ITEM 608.25 ALL PURPOSE EXCAVATOR RENTAL, TYPE 1.
 - CONTRACTOR SHALL SPACE GUARDRAIL POSTS IN A MANNER THAT AVOIDS THE EXISTING CULVERT BELOW, AS DIRECTED BY THE RESIDENT ENGINEER.
 - SEE SHEET 10 FOR REDUCED STEEL BEAM GUARDRAIL POST SPACING AT UTILITY POLE DETAIL.

PROJECT LAYOUT SHEET #25	NOT TO SCALE	
	PROJECT NAME: CASTLETON - WEST RUTLAND	PROJECT NUMBER: STP 2705(1)
	FILE NAME: p07cl68.dgn	PLOT DATE: 04-JUN-2013 09:2
	PROJECT LEADER: D.E.G.	DRAWN BY: W.G.P.
DESIGNED BY: M.J.M.	CHECKED BY: D.E.G.	
IPARM FILE: p07cl68l25.i	SHEET 46 OF 152	