

646.402 DURABLE 4 INCH WHITE LINE, THERMOPLASTIC OR  
 646.403 DURABLE 4 INCH WHITE LINE, EPOXY PAINT OR  
 646.404 DURABLE 4 INCH WHITE LINE, POLYUREA  
 (ALL LINES WILL INCLUDE EDGE LINE BREAKS AND  
 RADIUS FOR TOWN HIGHWAYS)  
 CASTLETON STATE HIGHWAY:  
 STA 13+50.00 - STA 19+50.00 EDGE LINE LT & RT

646.412 DURABLE 4 INCH YELLOW LINE, THERMOPLASTIC OR  
 646.413 DURABLE 4 INCH YELLOW LINE, EPOXY PAINT OR  
 646.414 DURABLE 4 INCH YELLOW LINE, POLYUREA  
 (ALL LINES WILL INCLUDE C/L BREAKS FOR  
 TOWN HIGHWAYS) S=SOLID, D=DASHED  
 CASTLETON STATE HIGHWAY:  
 STA 13+50.00 - STA 19+50.00

646.422 DURABLE 6 INCH WHITE LINE, THERMOPLASTIC OR  
 646.423 DURABLE 6 INCH WHITE LINE, EPOXY PAINT OR  
 646.424 DURABLE 6 INCH WHITE LINE, POLYUREA  
 (ALL LINES WILL INCLUDE EDGE LINE BREAKS AND  
 RADIUS FOR TOWN HIGHWAYS)  
 CASTLETON STATE HIGHWAY:  
 STA 18+42.79 RT, RAMP B EDGE LINE  
 STA 18+77.37 RT, RAMP C EDGE LINE

646.432 DURABLE 6 INCH YELLOW LINE, THERMOPLASTIC OR  
 646.433 DURABLE 6 INCH YELLOW LINE, EPOXY PAINT OR  
 646.434 DURABLE 6 INCH YELLOW LINE, POLYUREA  
 (ALL LINES WILL INCLUDE C/L BREAKS FOR  
 TOWN HIGHWAYS) S=SOLID, D=DASHED  
 CASTLETON STATE HIGHWAY:  
 STA 18+42.79 RAMP B, MEDIAN EDGE LINE RT  
 STA 18+77.37 RAMP C, MEDIAN EDGE LINE RT

646.492 DURABLE LETTER OR SYMBOL, THERMOPLASTIC OR  
 646.493 DURABLE LETTER OR SYMBOL, EPOXY PAINT  
 CASTLETON STATE HIGHWAY:  
 STA 18+77.77 RT RAMP C, "S,T,O,P" (4 EA)

646.602 TEMPORARY 4 INCH WHITE LINE, PAINT  
 (ALL LINES WILL INCLUDE EDGE LINE BREAKS AND  
 RADIUS FOR TOWN HIGHWAYS)  
 CASTLETON STATE HIGHWAY:  
 STA 13+50.00 - STA 19+50.00 EDGE LINE LT & RT

646.612 TEMPORARY 4 INCH YELLOW LINE, PAINT  
 (ALL LINES WILL INCLUDE C/L BREAKS FOR  
 TOWN HIGHWAYS) S=SOLID, D=DASHED  
 CASTLETON STATE HIGHWAY:  
 STA 13+50.00 - STA 19+50.00

646.682 TEMPORARY 24 INCH STOP BAR, PAINT  
 CASTLETON STATE HIGHWAY:  
 STA 18+69.12 RT RAMP C

646.492 TEMPORARY LETTER OR SYMBOL, PAINT  
 CASTLETON STATE HIGHWAY:  
 STA 18+77.77 RT RAMP C, "S,T,O,P" (8 EA)

646.81 PAINTED CURB  
 CASTLETON STATE HIGHWAY:  
 STA 18+42.79 RAMP B, RT (60.0 LF)  
 STA 18+77.37 RAMP C, RT (60.0 LF)


675.50 REMOVING SIGNS  
 AS SHOWN - 4

675.60 ERECTING SALVAGED SIGNS  
 AS SHOWN - 1

646.482 DURABLE 24 INCH STOP BAR, THERMOPLASTIC OR  
 646.483 DURABLE 24 INCH STOP BAR, EPOXY PAINT OR  
 646.484 DURABLE 24 INCH STOP BAR, POLYUREA  
 CASTLETON STATE HIGHWAY:  
 STA 18+69.12 RT RAMP C

646.622 TEMPORARY 6 INCH WHITE LINE, PAINT  
 (ALL LINES WILL INCLUDE EDGE LINE BREAKS AND  
 RADIUS FOR TOWN HIGHWAYS)  
 CASTLETON STATE HIGHWAY:  
 STA 18+42.79 RAMP B, EDGE LINE RT  
 STA 18+77.37 RAMP C, EDGE LINE RT

646.632 TEMPORARY 6 INCH YELLOW LINE, PAINT  
 (ALL LINES WILL INCLUDE C/L BREAKS FOR  
 TOWN HIGHWAYS) S=SOLID, D=DASHED  
 CASTLETON STATE HIGHWAY:  
 STA 18+42.79 RAMP B, MEDIAN EDGE LINE RT  
 STA 18+77.37 RAMP C, MEDIAN EDGE LINE RT

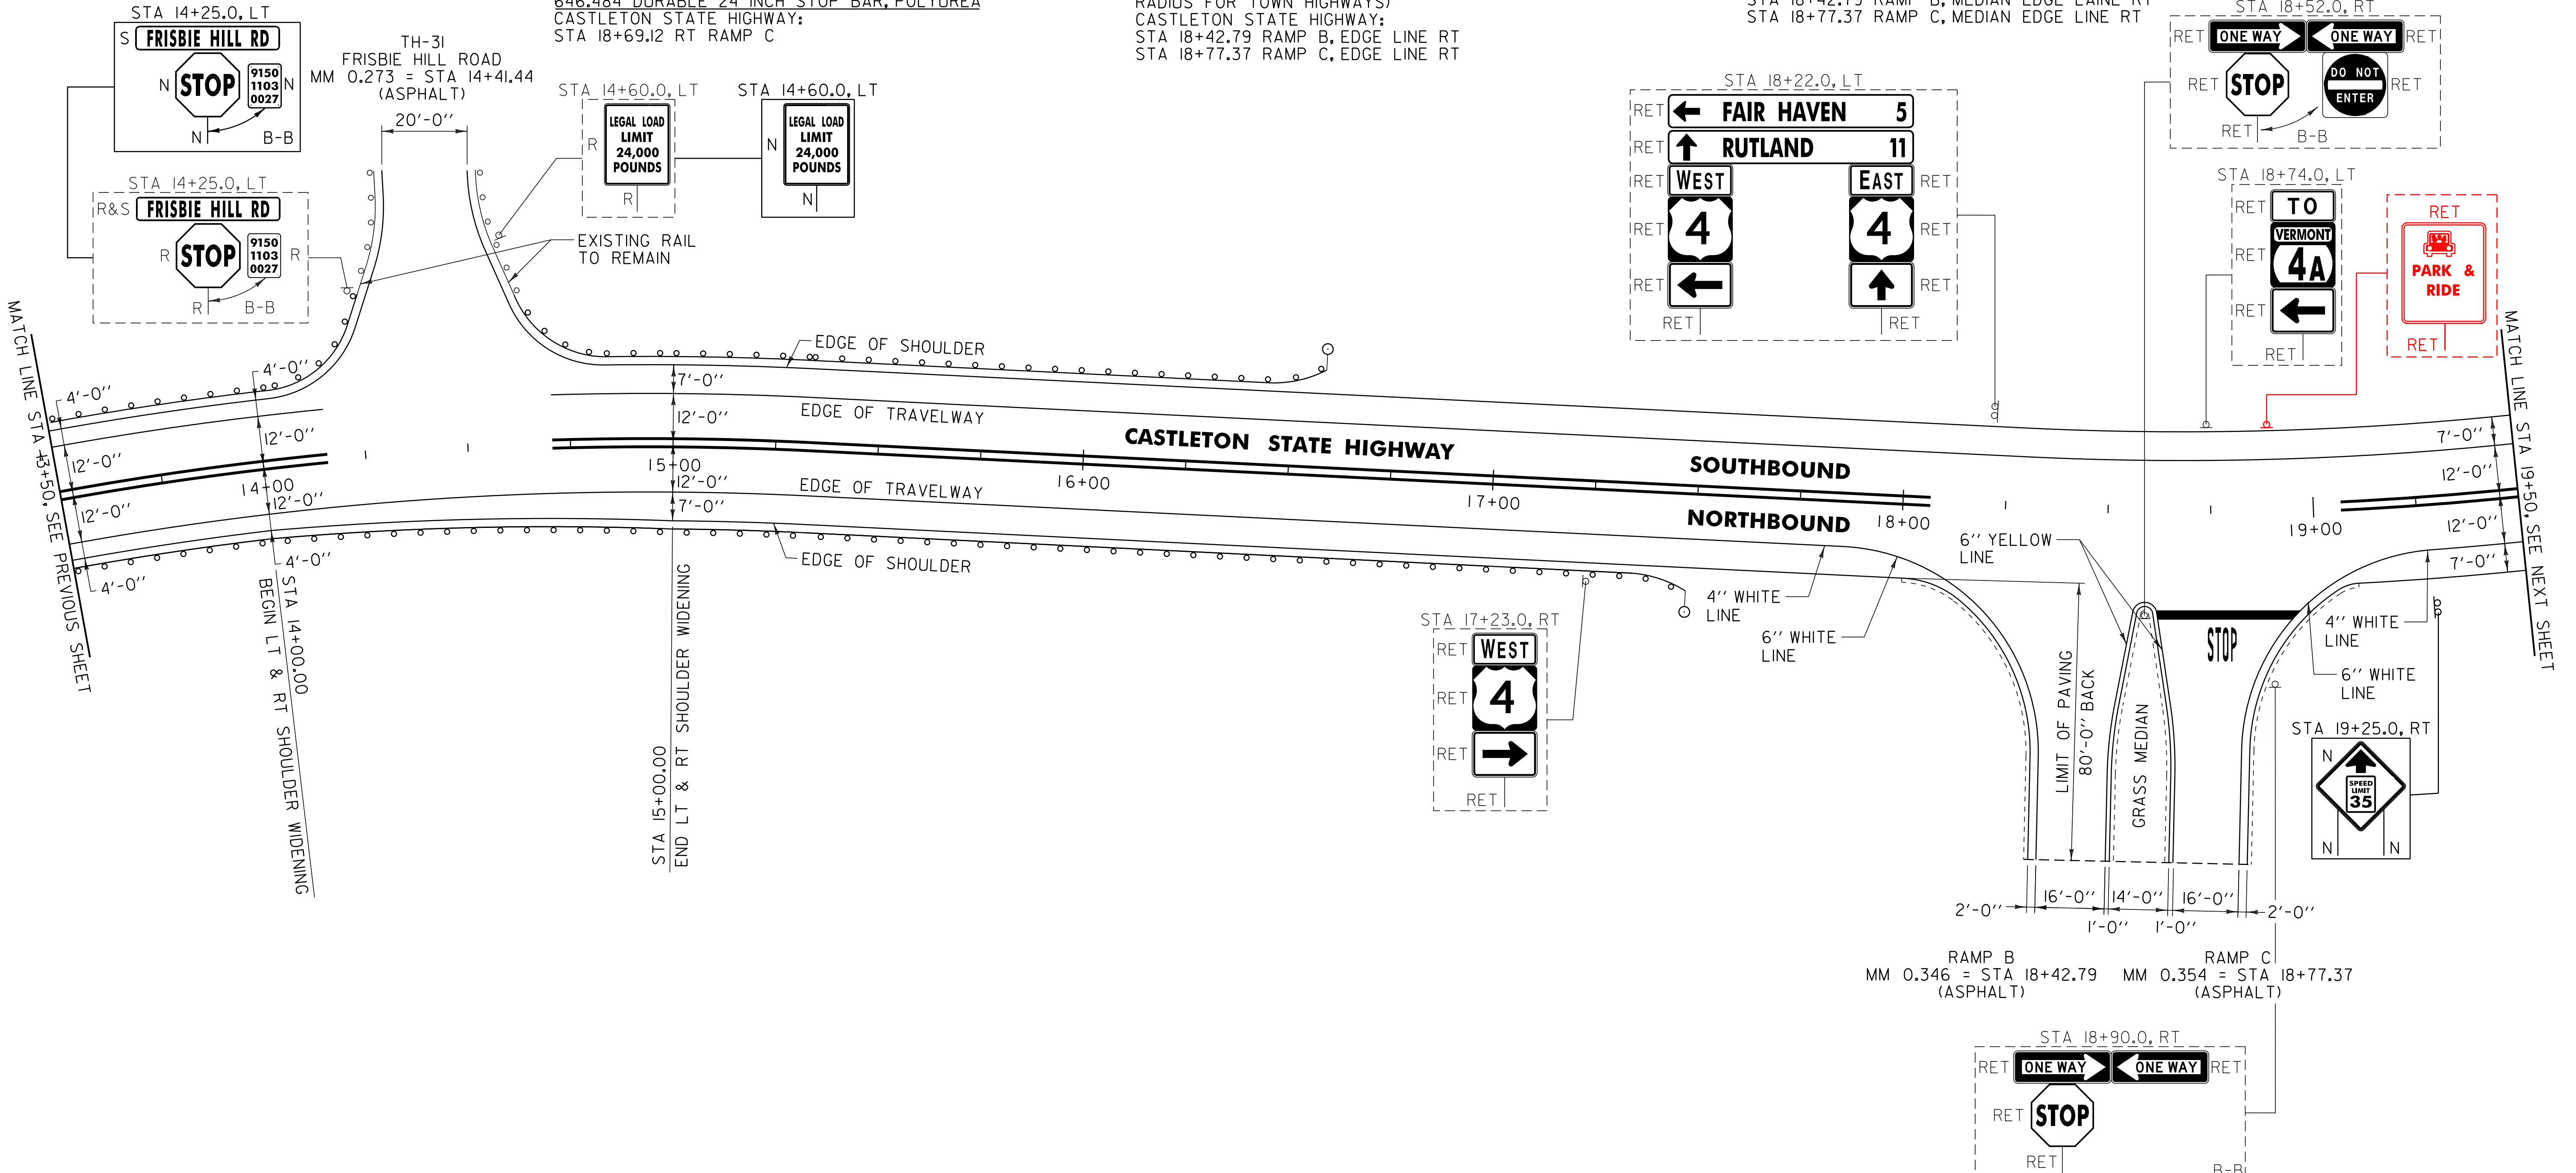

621.20 STEEL BEAM GUARDRAIL, GALVANIZED  
 CASTLETON STATE HIGHWAY:  
 STA 13+50.0 - STA 14+17.0 LT (104.5 LF)  
 STA 13+50.0 - STA 17+52.5 RT (402.5 LF)  
 STA 14+70.0 - STA 16+59.5 LT (227.0 LF)

621.80 REMOVAL AND DISPOSAL OF GUARDRAIL  
 CASTLETON STATE HIGHWAY:  
 STA 13+50.0 - STA 14+17.0 LT (104.5 LF)  
 STA 13+50.0 - STA 17+43.0 RT (393.0 LF)  
 STA 14+70.0 - STA 16+58.0 LT (225.5 LF)

621.60 ANCHOR FOR STEEL BEAM RAIL  
 CASTLETON STATE HIGHWAY:  
 STA 16+53.0 LT  
 STA 17+46.0 RT

676.10 DELINEATOR WITH STEEL POST  
 CASTLETON STATE HIGHWAY:  
 STA 16+59.5 LT  
 STA 17+52.5 RT

NOTE:  
 1. PAVING LIMIT ON ALL TOWN HIGHWAYS SHALL BE MEASURED  
 25 FT BACK FROM CASTLETON STATE HIGHWAY EDGE OF  
 SHOULDER UNLESS DENOTED OTHERWISE ON THE PLANS OR  
 AS DIRECTED BY THE RESIDENT ENGINEER.

SIGN LEGEND  
 R = REMOVE  
 S = SALVAGE  
 N = NEW  
 RET = RETAIN  
 B-B = BACK TO BACK  
 EXISTING = - - - - -  
 NEW = \_\_\_\_\_

**NOT TO SCALE**

<b>PROJECT LAYOUT SHEET #34</b>	PROJECT NAME: CASTLETON - WEST RUTLAND	FILE NAME: p07cl68.dgn	PLOT DATE: 04-JUN-2013 09:3
	PROJECT NUMBER: STP 2705(i)	PROJECT LEADER: D.E.G.	DRAWN BY: W.G.P.
		DESIGNED BY: M.J.M.	CHECKED BY: D.E.G.
		IPARM FILE: p07cl68134.i	SHEET 55 OF 152