


COLOR: WHITE BORDER & TEXT (REFLECTORIZED)  
GREEN BACKGROUND (REFLECTORIZED)

MATERIAL: PER VAOT STANDARD E-123


LOCATION: VT. ROUTE 4A  
CASTLETON:  
STA 208+75.0 LT

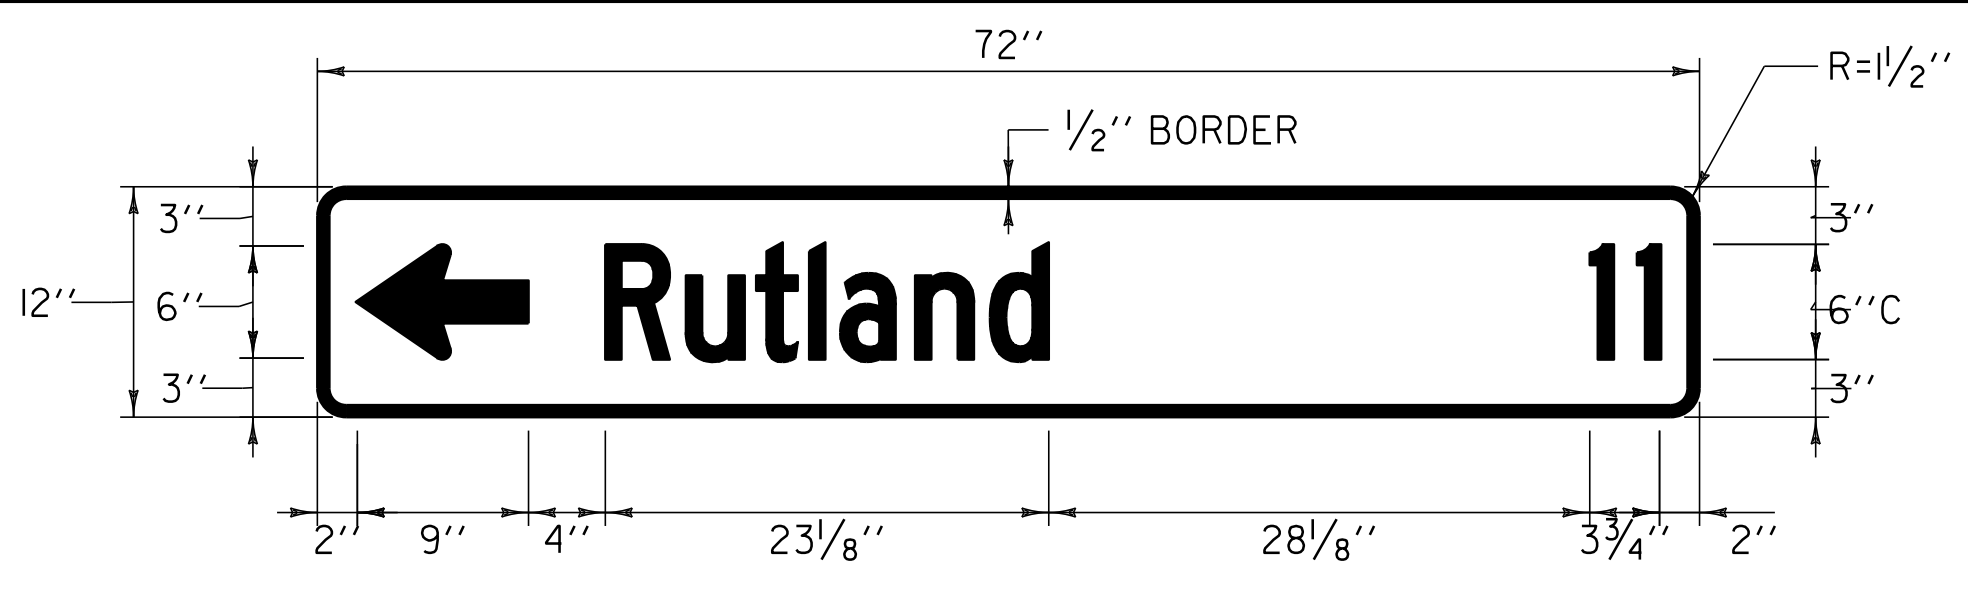

COLOR: WHITE BORDER & TEXT (REFLECTORIZED)  
GREEN BACKGROUND (REFLECTORIZED)

MATERIAL: PER VAOT STANDARD E-123


LOCATION: VT. ROUTE 4A  
CASTLETON:  
STA 209+00.0 RT

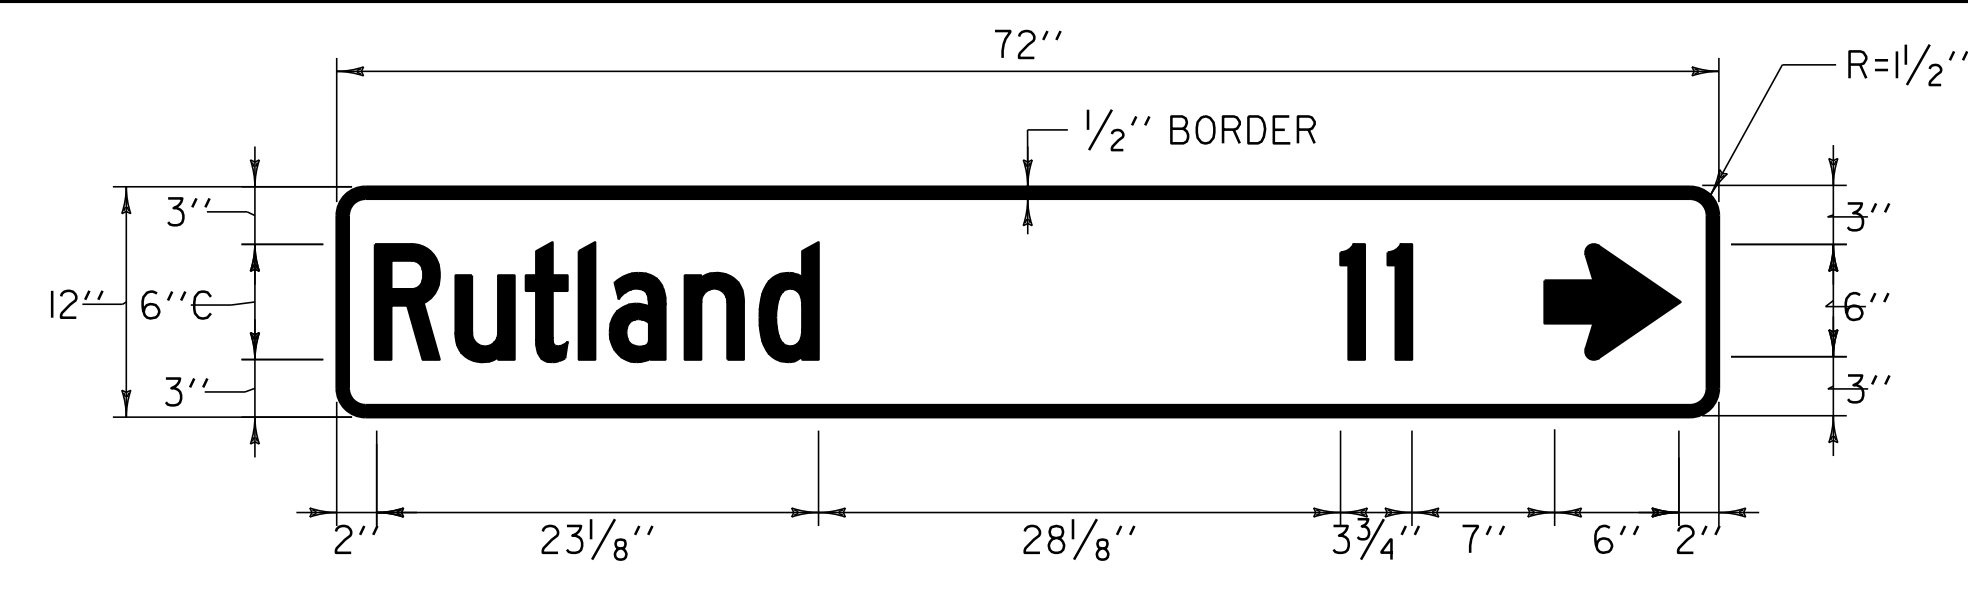

COLOR: WHITE BORDER & TEXT (REFLECTORIZED)  
GREEN BACKGROUND (REFLECTORIZED)

MATERIAL: PER VAOT STANDARD E-123


LOCATION: VT. ROUTE 4A  
CASTLETON:  
STA 214+50.0 LT

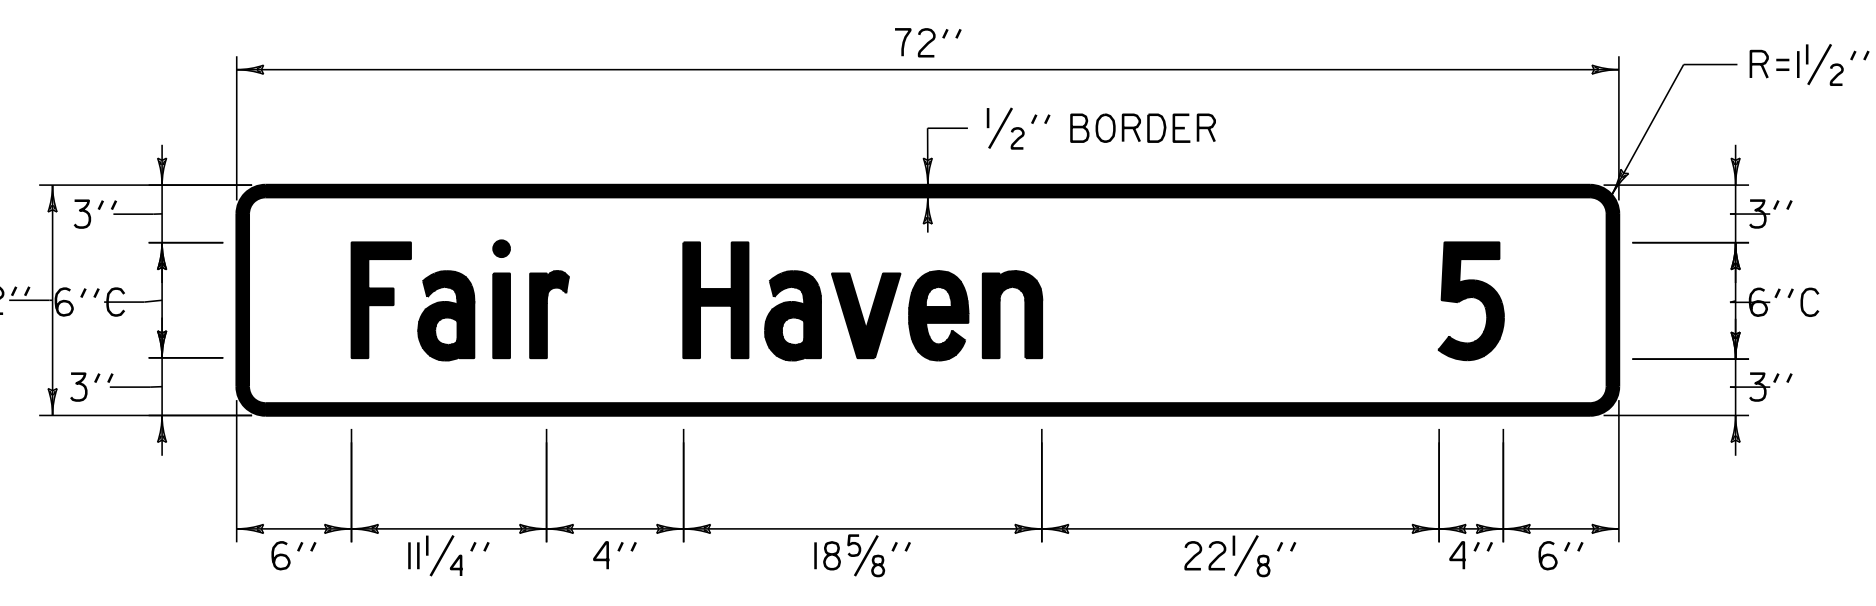

COLOR: WHITE BORDER & TEXT (REFLECTORIZED)  
GREEN BACKGROUND (REFLECTORIZED)

MATERIAL: PER VAOT STANDARD E-123


LOCATION: VT. ROUTE 4A  
CASTLETON:  
STA 208+75.0 LT

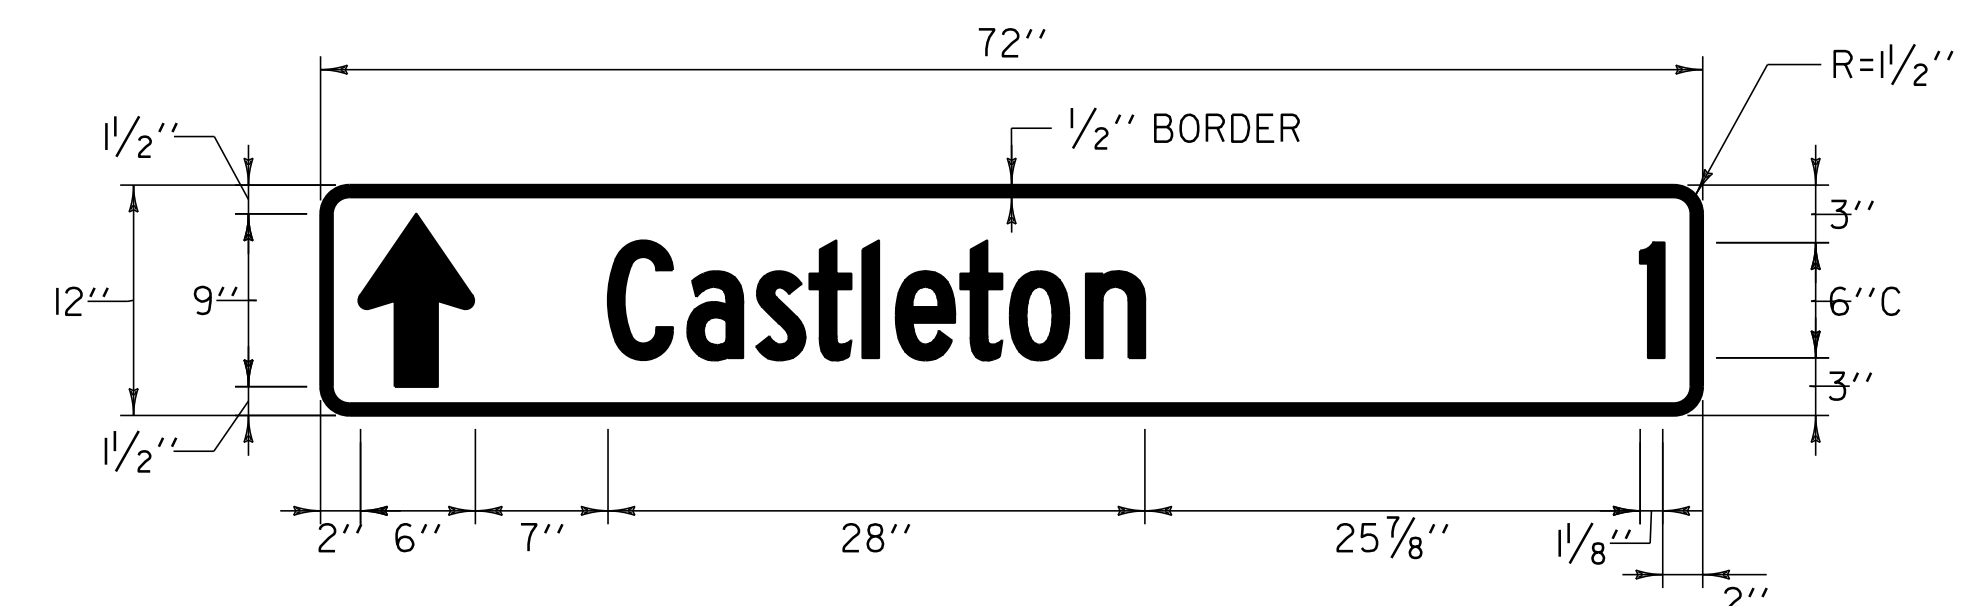

COLOR: WHITE BORDER & TEXT (REFLECTORIZED)  
GREEN BACKGROUND (REFLECTORIZED)

MATERIAL: PER VAOT STANDARD E-123


LOCATION: VT. ROUTE 4A  
CASTLETON:  
STA 214+50.0 LT

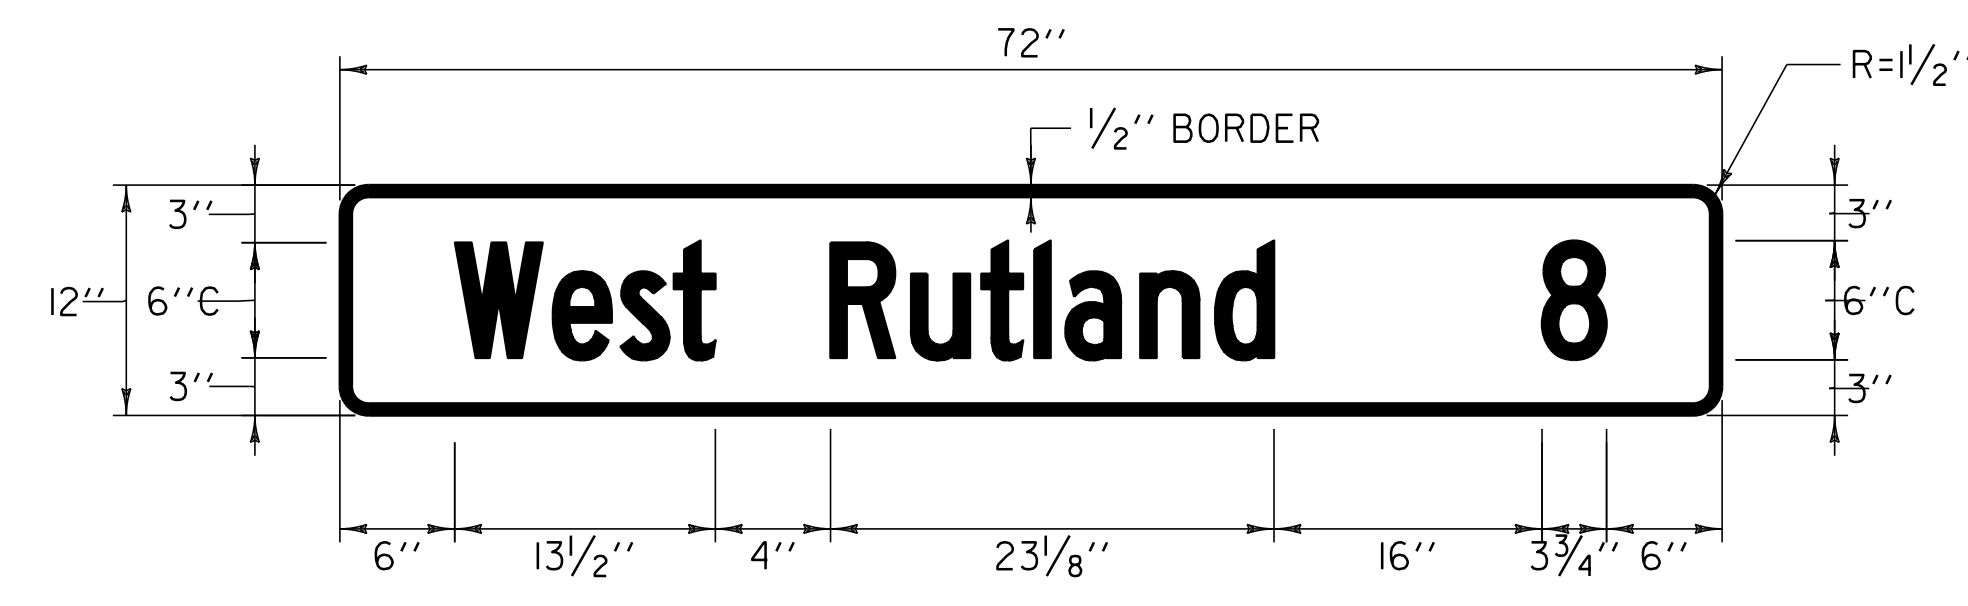

COLOR: WHITE BORDER & TEXT (REFLECTORIZED)  
GREEN BACKGROUND (REFLECTORIZED)

MATERIAL: PER VAOT STANDARD E-123


LOCATION: VT. ROUTE 4A  
CASTLETON:  
STA 215+50.0 RT

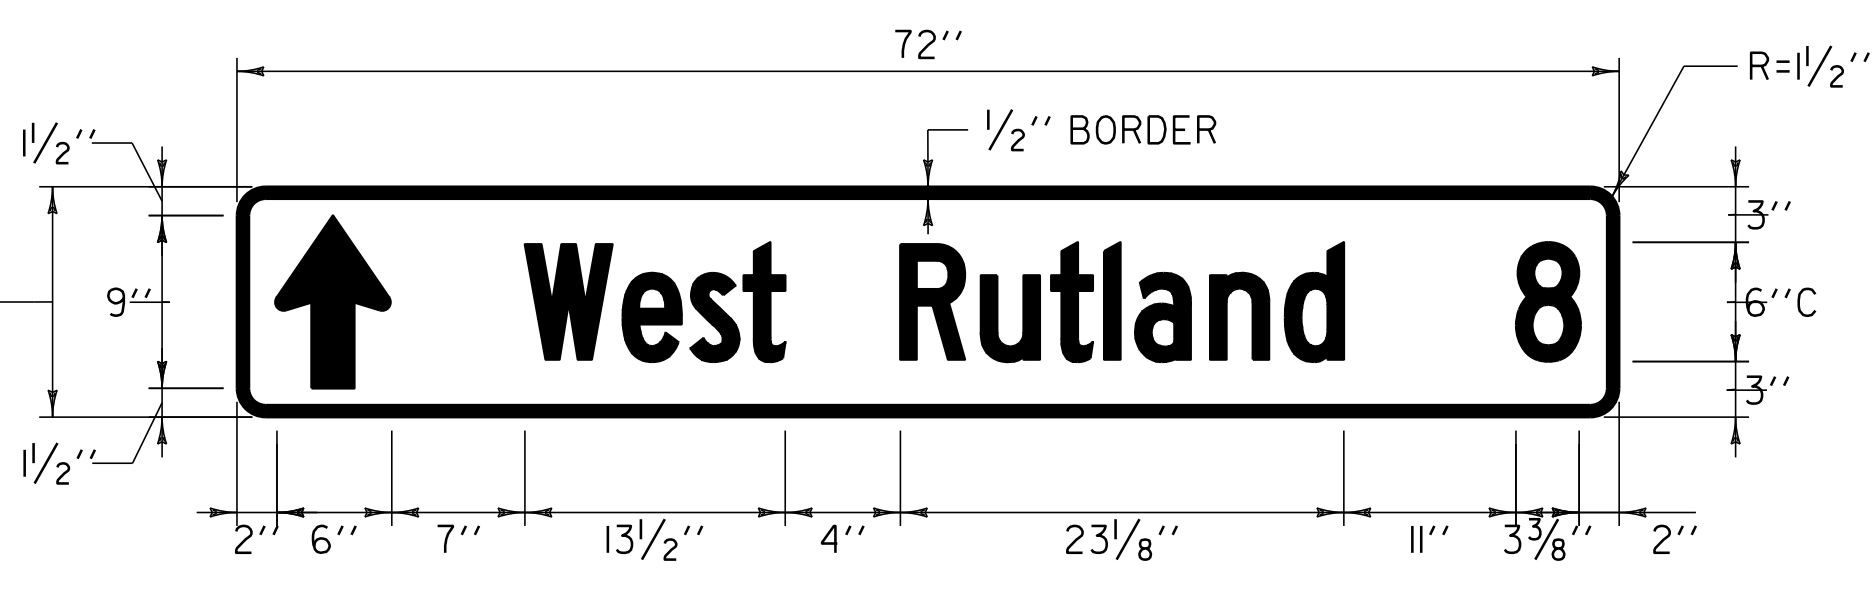

COLOR: WHITE BORDER & TEXT (REFLECTORIZED)  
GREEN BACKGROUND (REFLECTORIZED)

MATERIAL: PER VAOT STANDARD E-123


LOCATION: VT. ROUTE 4A  
CASTLETON:  
STA 209+00.0 RT

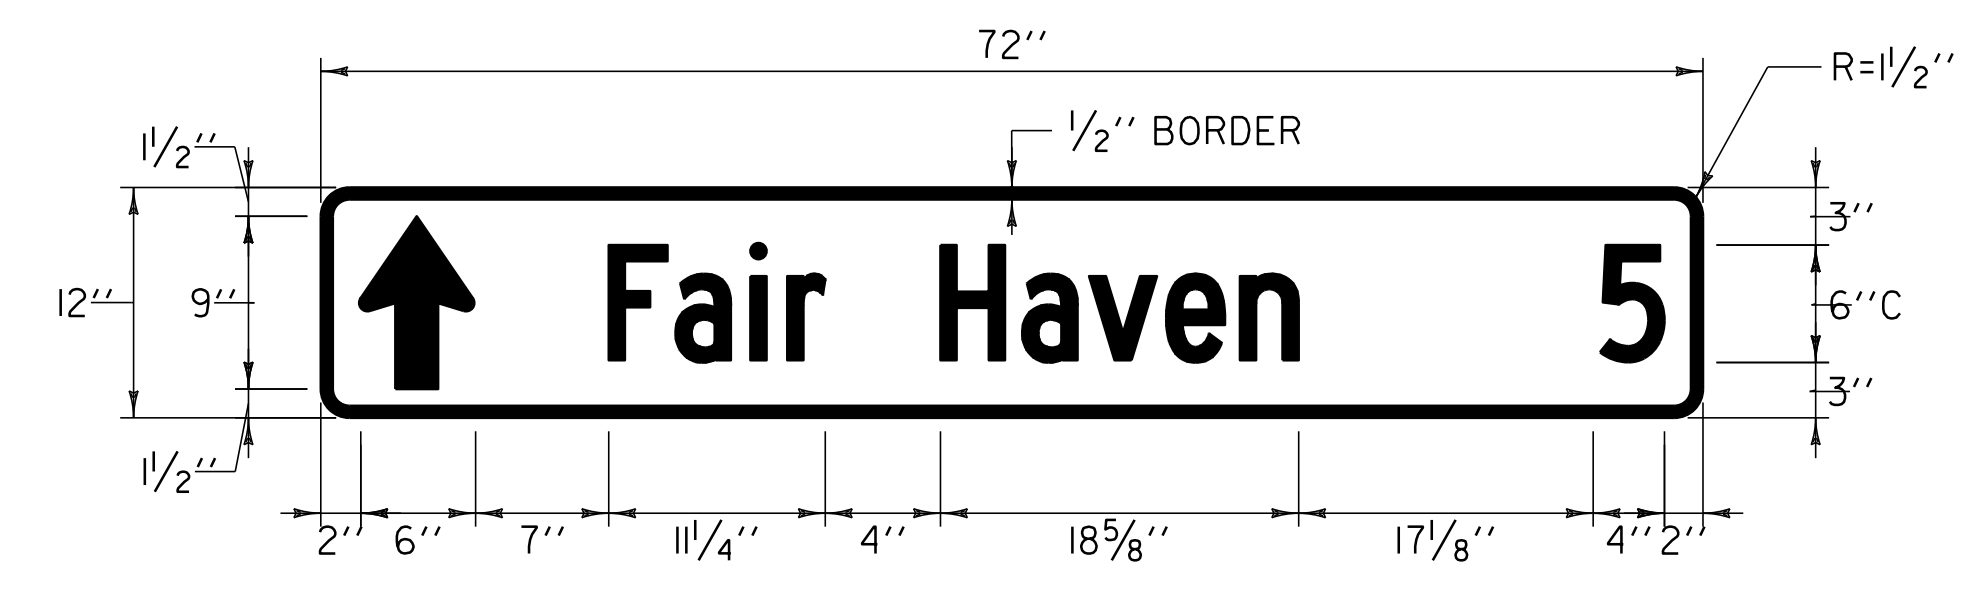

COLOR: WHITE BORDER & TEXT (REFLECTORIZED)  
GREEN BACKGROUND (REFLECTORIZED)

MATERIAL: PER VAOT STANDARD E-123


LOCATION: VT. ROUTE 4A  
CASTLETON:  
STA 214+50.0 LT

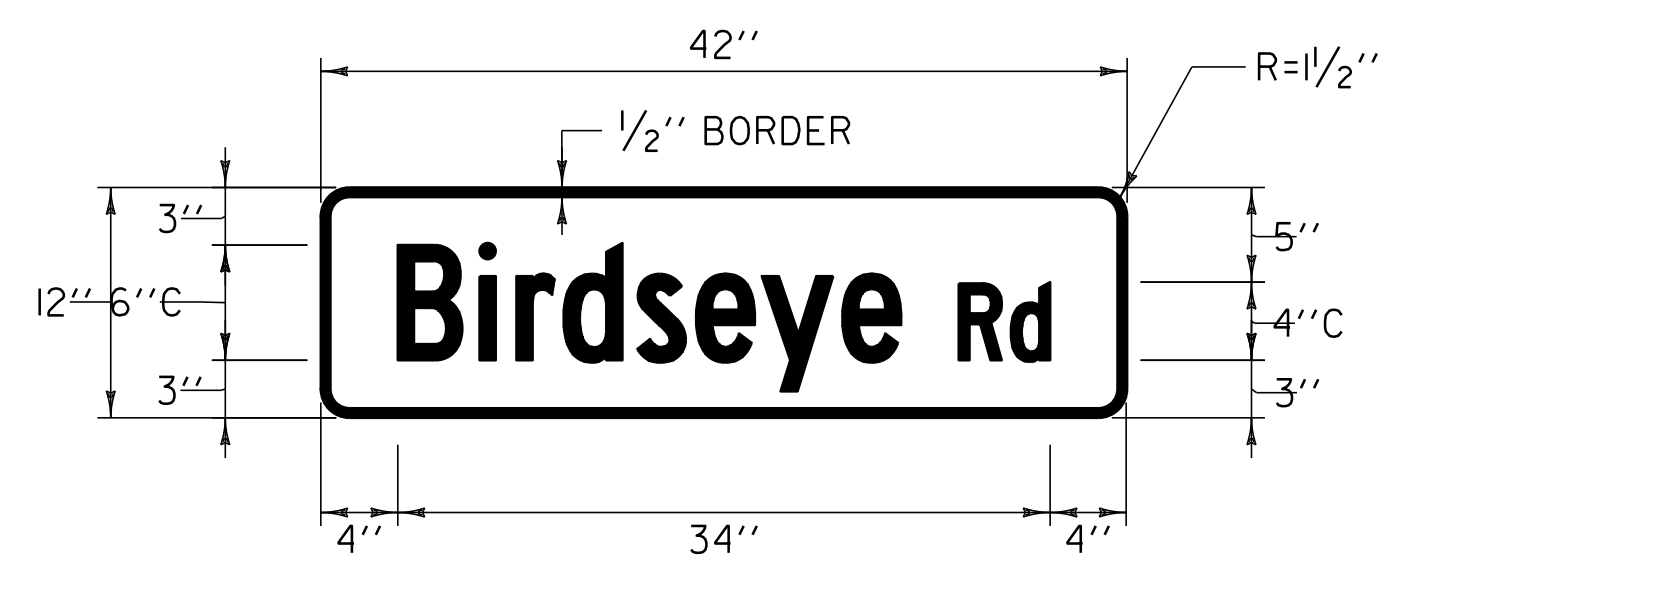

COLOR: WHITE BORDER & TEXT (REFLECTORIZED)  
GREEN BACKGROUND (REFLECTORIZED)

MATERIAL: PER VAOT STANDARD E-123


LOCATION: VT. ROUTE 4A  
IRA:  
STA 33+44.0 RT

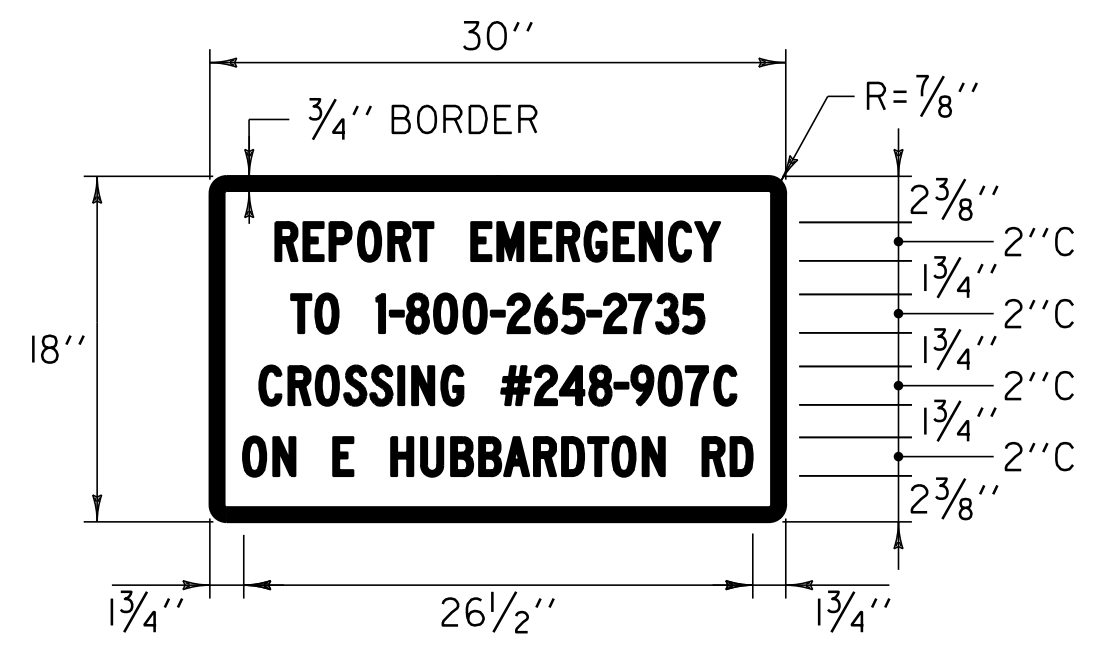

COLOR: WHITE BORDER & TEXT (REFLECTORIZED)  
BLUE BACKGROUND (REFLECTORIZED)

MATERIAL: PER VAOT STANDARD E-123


LOCATION: CASTLETON STATE HIGHWAY  
CASTLETON:  
STA 3+41.0 RT  
STA 3+66.0 LT  
STA 3+66.0 LT

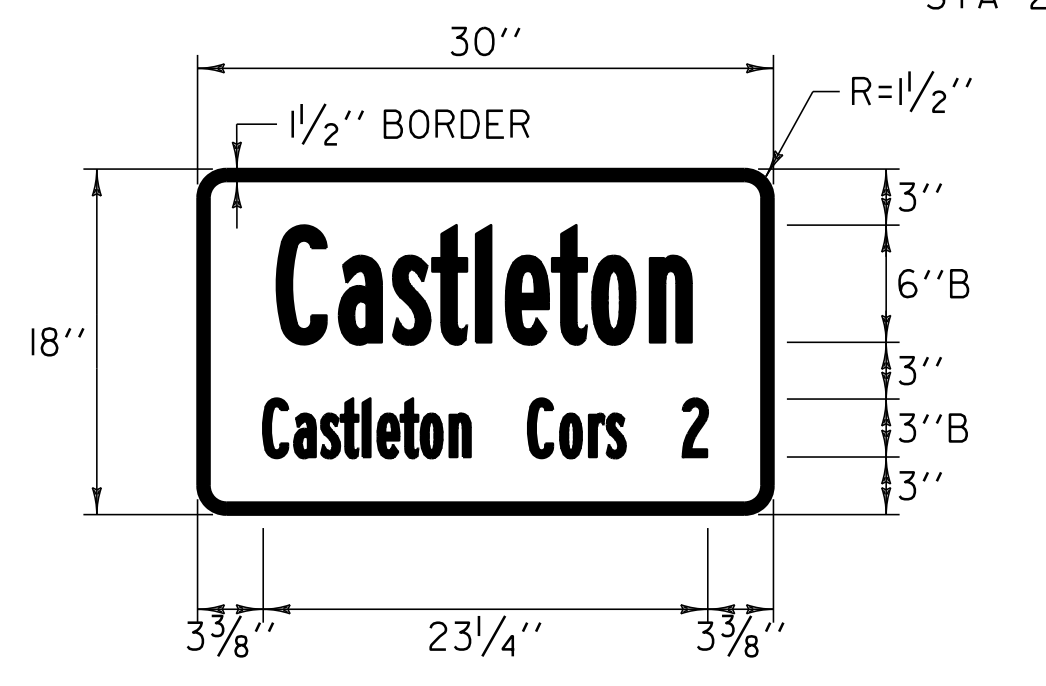

COLOR: WHITE BORDER & TEXT (REFLECTORIZED)  
GREEN BACKGROUND (REFLECTORIZED)

MATERIAL: PER VAOT STANDARD E-128A

LOCATION: CASTLETON:  
STA 205+58.0 LT

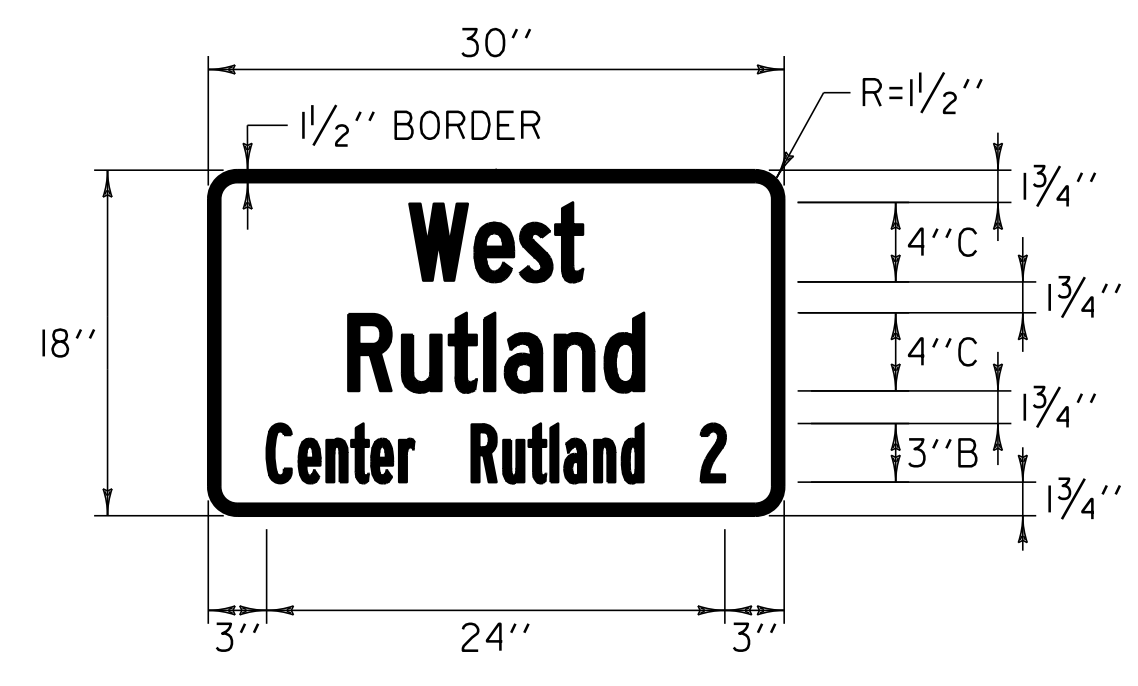

COLOR: WHITE BORDER & TEXT (REFLECTORIZED)  
GREEN BACKGROUND (REFLECTORIZED)

MATERIAL: PER VAOT STANDARD E-128A

LOCATION: WEST RUTLAND:  
STA 60+25.0 RT

NOT TO SCALE

<b>TRAFFIC SIGN DETAILS SHEET</b>	PROJECT NAME: CASTLETON - WEST RUTLAND	
	PROJECT NUMBER: STP 2705(i)	
	FILE NAME: p07cl68.dgn	PLOT DATE: 04-JUN-2013 09:3
	PROJECT LEADER: D.E.G.	DRAWN BY: W.G.P.
	DESIGNED BY: M.J.M.	CHECKED BY: D.E.G.
	IPARM FILE: p07cl68+sd.i	SHEET 74 OF 152