


646.402 DURABLE 4 INCH WHITE LINE, THERMOPLASTIC OR
646.403 DURABLE 4 INCH WHITE LINE, EPOXY PAINT OR
646.404 DURABLE 4 INCH WHITE LINE, POLYUREA
(ALL LINES WILL INCLUDE EDGE LINE BREAKS AND
RADIUS FOR TOWN HIGHWAYS)
CASTLETON:
STA 194+75.00 - STA 200+00.00 EDGE LINE LT & RT

646.602 TEMPORARY 4 INCH WHITE LINE, PAINT
(ALL LINES WILL INCLUDE EDGE LINE BREAKS AND
RADIUS FOR TOWN HIGHWAYS)
CASTLETON:
STA 194+75.00 - STA 200+00.00 EDGE LINE LT & RT

646.412 DURABLE 4 INCH YELLOW LINE, THERMOPLASTIC OR
646.413 DURABLE 4 INCH YELLOW LINE, EPOXY PAINT OR
646.414 DURABLE 4 INCH YELLOW LINE, POLYUREA
(ALL LINES WILL INCLUDE C/L BREAKS FOR
TOWN HIGHWAYS) S=SOLID, D=DASHED
CASTLETON:
STA 194+75.00 - STA 200+00.00 LT C RT
S - S

646.612 TEMPORARY 4 INCH YELLOW LINE, PAINT
(ALL LINES WILL INCLUDE C/L BREAKS FOR
TOWN HIGHWAYS) S=SOLID, D=DASHED
CASTLETON:
STA 194+75.00 - STA 200+00.00 LT C RT
S - S

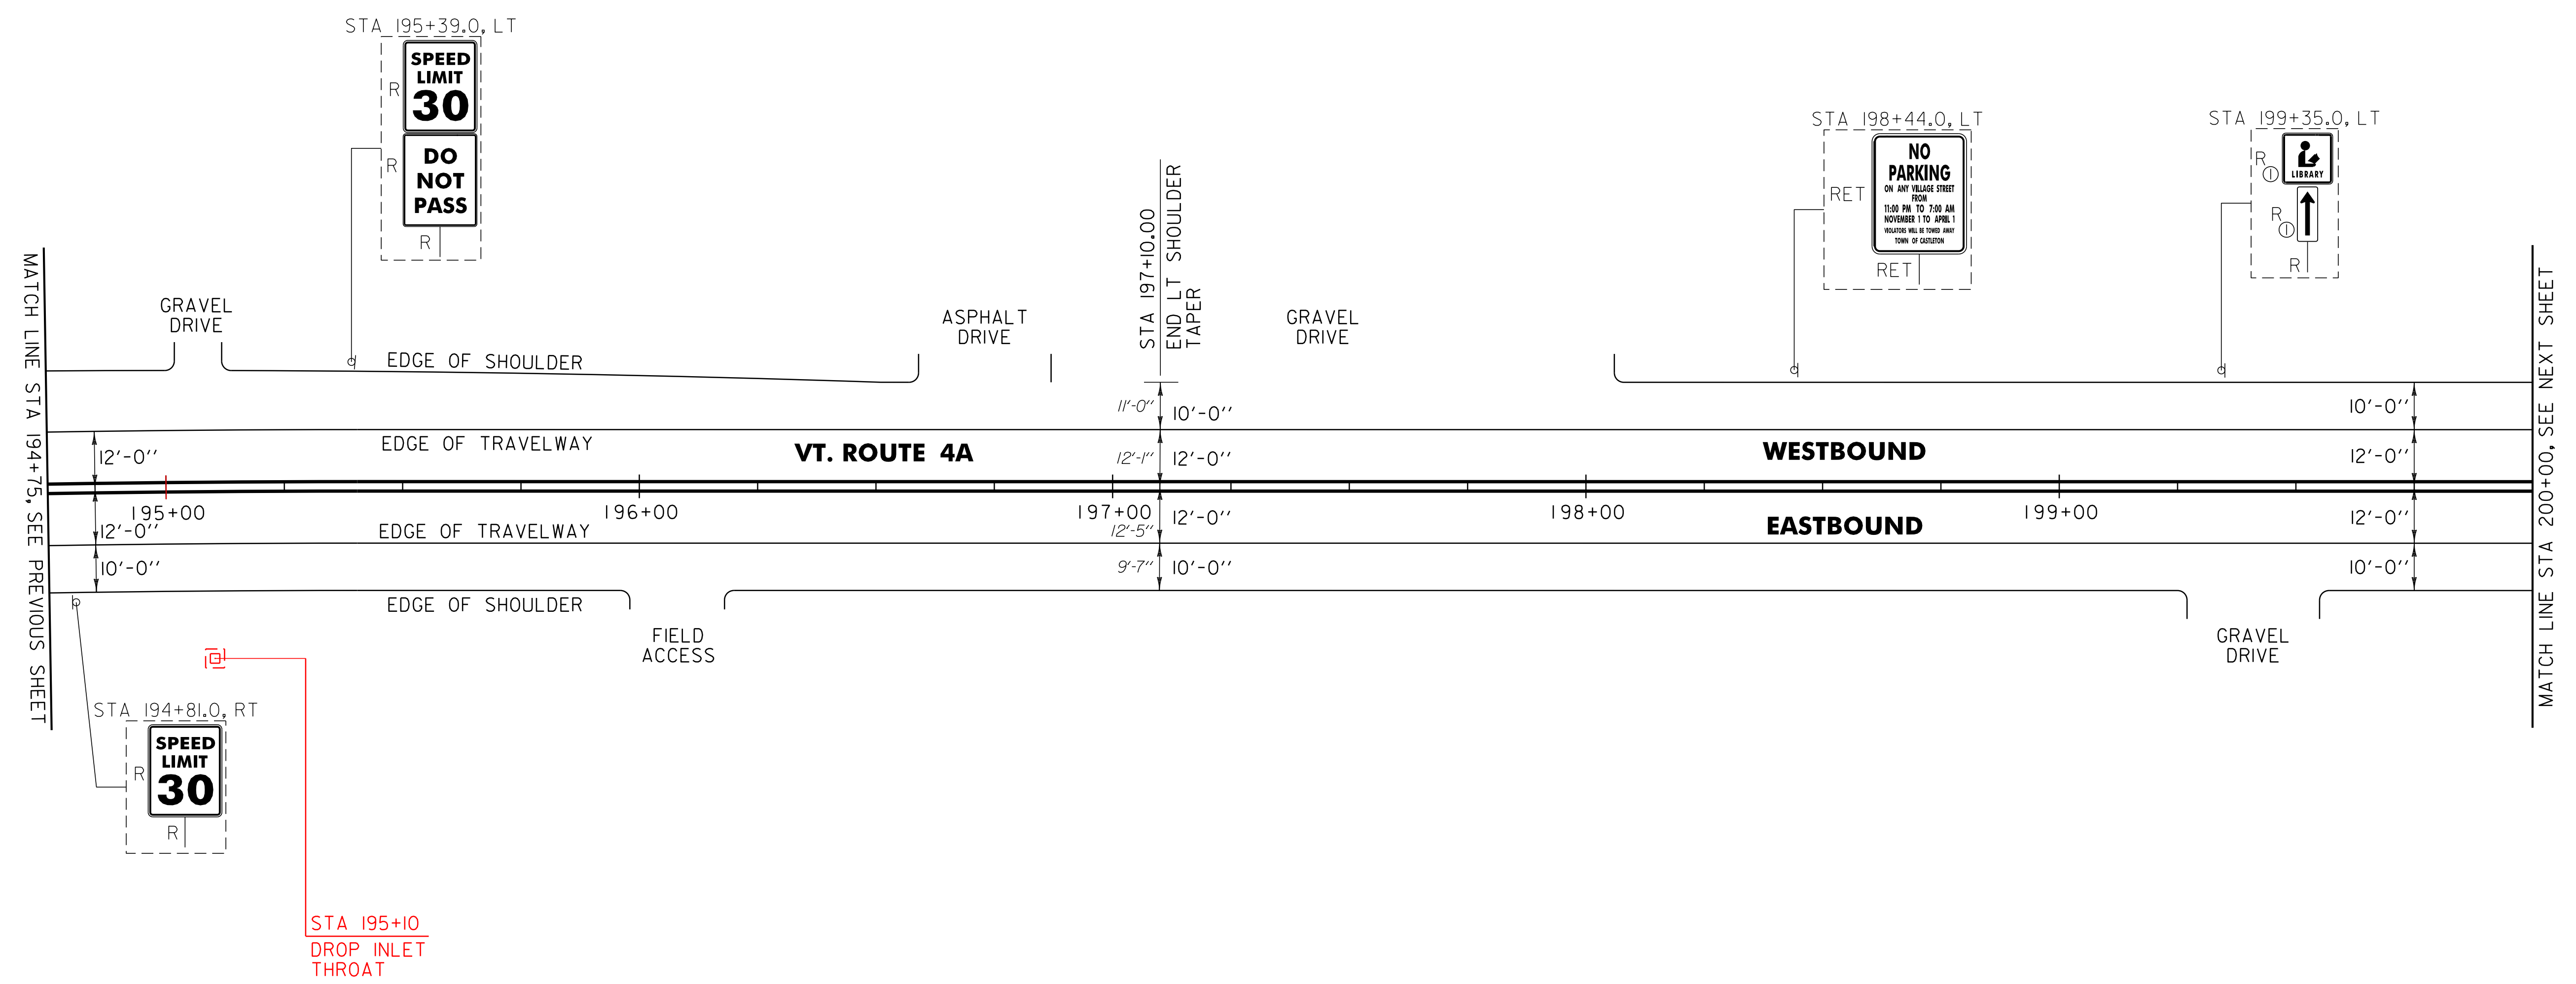

SIGN LEGEND
R = REMOVE
S = SALVAGE
N = NEW
RET = RETAIN
B-B = BACK TO BACK
EXISTING = -----
NEW = _____
R = RETURN TO TOWN
OF CASTLETON

PROJECT LAYOUT SHEET #9	NOT TO SCALE	
	PROJECT NAME: CASTLETON	PROJECT NUMBER: STP 2908(1)
	FILE NAME: p10c210.dgn	PLOT DATE: 04-JUN-2013 09:3
	PROJECT LEADER: D.E.G. DESIGNED BY: M.J.M. IPARM FILE: p10c210i09.i	DRAWN BY: W.G.P. CHECKED BY: D.E.G. SHEET 106 OF 152