





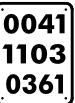


TRAFFIC SIGN SUMMARY SHEET 7

MILEMARKER, STATION, OR SIGN NUMBER	SIGN LEGEND	SIGN DIMENSIONS		NEW & SALVAGED SIGNS							EXIST POST SALVAGED RETAIN	NO. OF POSTS	NEW SIGN POSTS													REMARKS	SIGN DETAIL		
				"A"	"B"	SALV SIGN	SALV TIS	FLANGED CHANNEL					SQUARE STEEL (in)			TUBULAR ALUMINUM (in)			TUBULAR STEEL (in)				W-SHAPE STEEL				DETAIL IN SHS	DETAIL ON DWG. NUMBER	STD. SHEET NUMBER
		1.2	2.0					3.0	1.75	2.0			2.5	3.0	4.0	4.0 MOD	FOUNDATION	3.0	3.5	4.0	5.0	24"	30"	WEIGHT	POST SIZE				
		EA	WIDTH (in)	HEIGHT (in)	lb/ft		lb/ft																						

CASTLETON: 184+80.0, RT		I	24	30	5.00							I				* 13' 3"	X											SIGN ID CODE R2-1	X		
186+17.0, LT																* 15' 0"	X										SALVAGED SIGN TO BE MOUNTED ON NEW POST. SIGN WAS NOT AT THIS LOCATION.	-	-	-	
187+25.0, LT		I	30	30	6.25							I				* 15' 0"	X									SIGN ID CODE WII-2 SIGN SHALL BE FLUORESCENT YELLOW GREEN	X				
		I	24	12	2.00																					SIGN ID CODE W16-9P SIGN SHALL BE FLUORESCENT YELLOW GREEN	X				
190+54.0, LT		I I	30 30	12 12	2.50 2.50							I				* 11' 0"	X									TOP MOUNTING BRACKET REQUIRED TO INSTALL SIGNS ON POST. COSTS ASSOCIATED WITH THIS BRACKET ARE INCIDENTAL TO THE SIGN POST.			I16 I16		
190+59.0, LT	 	I I	30 6	30 10	6.25 0.42							I				* 13' 0"	X									BACK-TO-BACK SIGN ID CODE RI-1 SIGN ID CODE VD-700	X		E-138		

FINAL POST LENGTHS ARE TO BE DETERMINED IN THE FIELD. POST SIZES ARE COMPUTED BASED ON INFORMATION FURNISHED ON THE STANDARD SHEETS AND THE VTRANS "SIGN POST DESIGN GUIDELINE."

LF LF LF LF LF LF EA. LB LB LB LB LB LB LB LB

~~70~~
52.25

EA. LB EA. EA. LB

TRAFFIC SIGN SUMMARY SHEET #7

PROJECT NAME: CASTLETON
PROJECT NUMBER: STP 2908(I)

FILE NAME: p10c210.dgn
PROJECT LEADER: D.E.G.
DESIGNED BY: M.J.M.
IPARM FILE: p10c210+ssl.i

PLOT DATE: 04-JUN-2013 09:3
DRAWN BY: W.G.P.
CHECKED BY: D.E.G.
SHEET 114 OF 152

TOTALS	SF	SF	EA.	SF		LF	LF	EA.	LB	EA.	EA.	LB
	24.92		+				70 52.25					