

646.402 DURABLE 4 INCH WHITE LINE, THERMOPLASTIC OR  
 646.403 DURABLE 4 INCH WHITE LINE, EXPOXY PAINT OR  
 646.404 DURABLE 4 INCH WHITE LINE, POLYUREA  
 (ALL LINES WILL INCLUDE EDGE LINE BREAKS AND  
 RADIUS FOR TOWN HIGHWAYS)  
 CASTLETON:  
 STA 107+50.00 - STA 112+50.00 EDGE LINE LT & RT  
 STA 107+50.00 - STA 109+25.00 SOLID LANE LINE LT  
 STA 109+25.00 - STA 111+35.00 DOTTED LANE LINE LT  
 STA 109+25.00 - STA 111+35.00 DOTTED LANE LINE RT  
 STA 111+35.00 - STA 112+50.00 SOLID LANE LINE RT

646.412 DURABLE 4 INCH YELLOW LINE, THERMOPLASTIC OR  
 646.413 DURABLE 4 INCH YELLOW LINE, EXPOXY PAINT OR  
 646.414 DURABLE 4 INCH YELLOW LINE, POLYUREA  
 (ALL LINES WILL INCLUDE C/L BREAKS FOR  
 TOWN HIGHWAYS) S=SOLID, D=DASHED  
 CASTLETON:  
 STA 107+50.00 - STA 112+50.00 MEDIAN EDGE LINE LT & RT

646.602 TEMPORARY 4 INCH WHITE LINE, PAINT  
 (ALL LINES WILL INCLUDE EDGE LINE BREAKS AND  
 RADIUS FOR TOWN HIGHWAYS)  
 CASTLETON:  
 STA 107+50.00 - STA 112+50.00 EDGE LINE LT & RT  
 STA 107+50.00 - STA 109+25.00 SOLID LANE LINE LT  
 STA 109+25.00 - STA 111+35.00 DOTTED LANE LINE LT  
 STA 109+25.00 - STA 111+35.00 DOTTED LANE LINE RT  
 STA 111+35.00 - STA 112+50.00 SOLID LANE LINE RT

646.612 TEMPORARY 4 INCH YELLOW LINE, PAINT  
 (ALL LINES WILL INCLUDE C/L BREAKS FOR  
 TOWN HIGHWAYS) S=SOLID, D=DASHED  
 CASTLETON:  
 STA 107+50.00 - STA 112+50.00 MEDIAN EDGE LINE LT & RT


646.492 DURABLE LETTER OR SYMBOL, THERMOPLASTIC OR  
 646.493 DURABLE LETTER OR SYMBOL, EPOXY PAINT  
 CASTLETON:  
 STA 107+72.55 LT ARROW (1 EA)  
 STA 108+46.70 LT "O,N,L,Y" (4 EA)  
 STA 109+20.84 LT ARROW (1 EA)  
 STA 111+39.25 RT ARROW (1 EA)  
 STA 112+14.63 RT "O,N,L,Y" (4 EA)

646.81 PAINTED CURB  
 CASTLETON:  
 STA 108+95.0 - STA 109+55.0 RT (120.0 LF)  
 STA 111+05.0 - STA 111+65.0 LT (120.0 LF)

646.692 TEMPORARY LETTER OR SYMBOL, PAINT  
 CASTLETON:  
 STA 107+72.55 LT ARROW (2 EA)  
 STA 109+20.84 LT ARROW (2 EA)  
 STA 111+39.25 RT ARROW (2 EA)

675.50 REMOVING SIGNS  
 AS SHOWN - 2

675.60 ERECTING SALVAGED SIGNS  
 AS SHOWN - 1

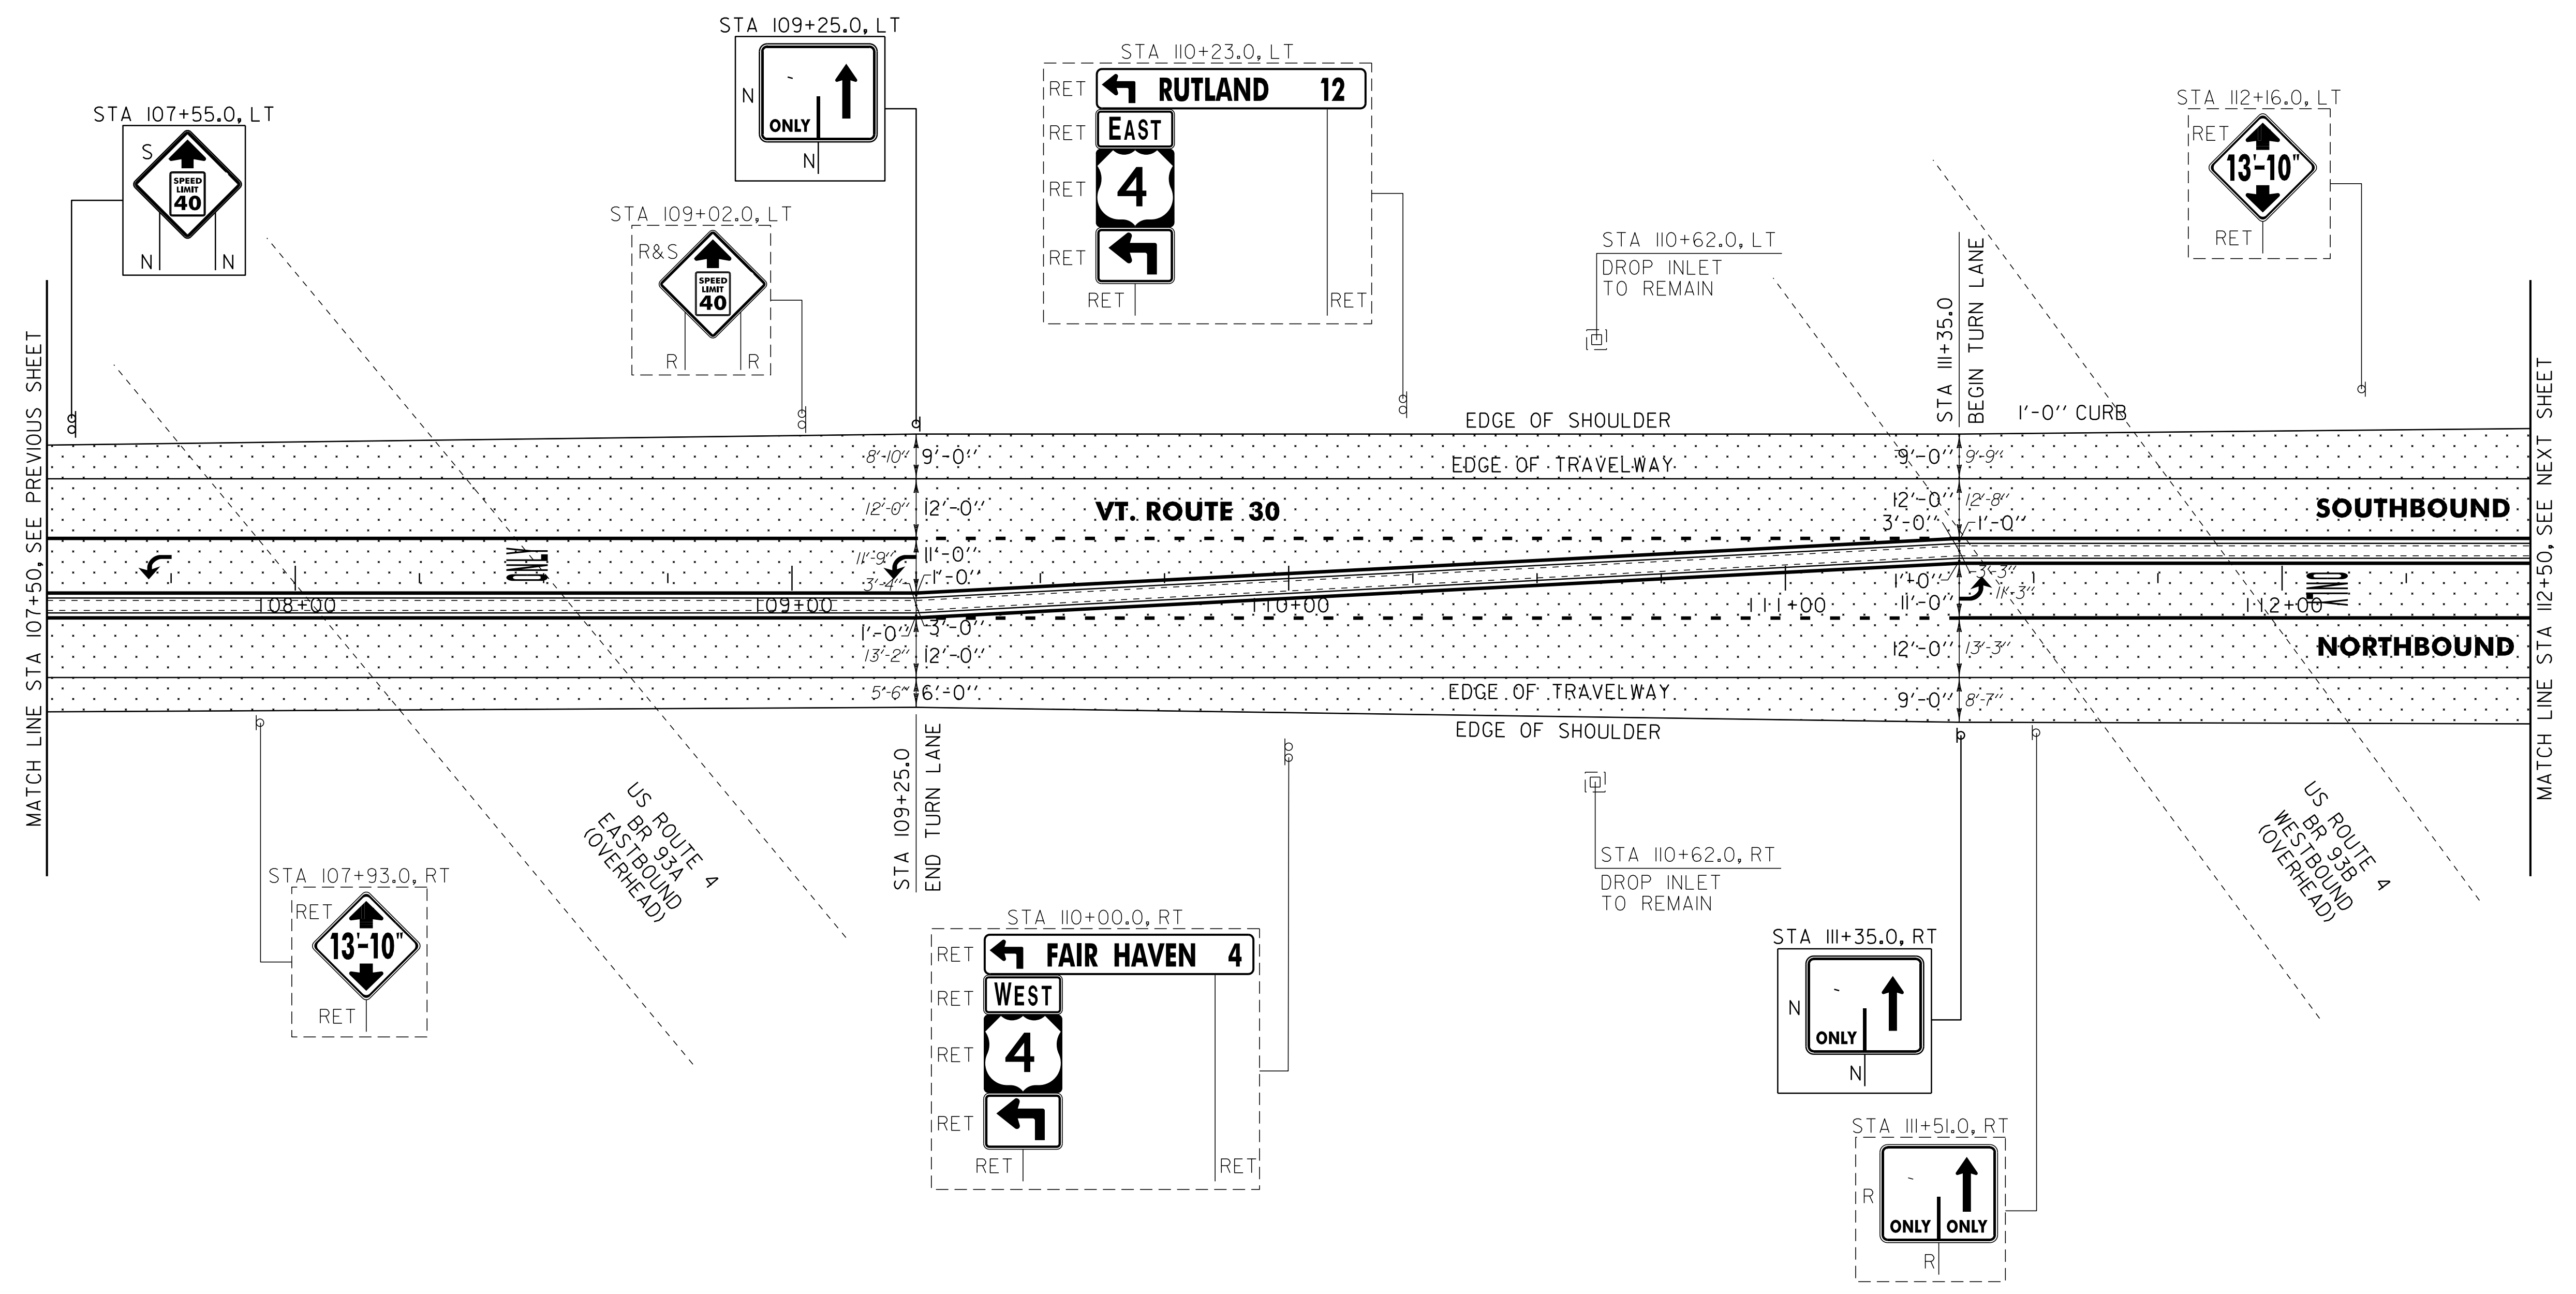

NOTE:  
 1. VERTICAL CLEARANCE TO US ROUTE 4 OVERPASSES SHALL NOT BE REDUCED

NOT TO SCALE

**SIGN LEGEND**  
 R = REMOVE  
 S = SALVAGE  
 N = NEW  
 RET = RETAIN  
 B-B = BACK TO BACK  
 EXISTING = - - - - -  
 NEW = \_\_\_\_\_

AREA TO BE COLD PLANNED

<b>PROJECT LAYOUT SHEET #6</b>	PROJECT NAME: CASTLETON	PLOT DATE: 04-JUN-2013 09:3
	PROJECT NUMBER: STP 2909(1)	DRAWN BY: W.G.P.
	FILE NAME: p10c212.dgn	CHECKED BY: D.E.G.
	PROJECT LEADER: D.E.G.	SHEET 134 OF 152
	DESIGNED BY: M.J.M.	
	IPARM FILE: p10c212106.i	