
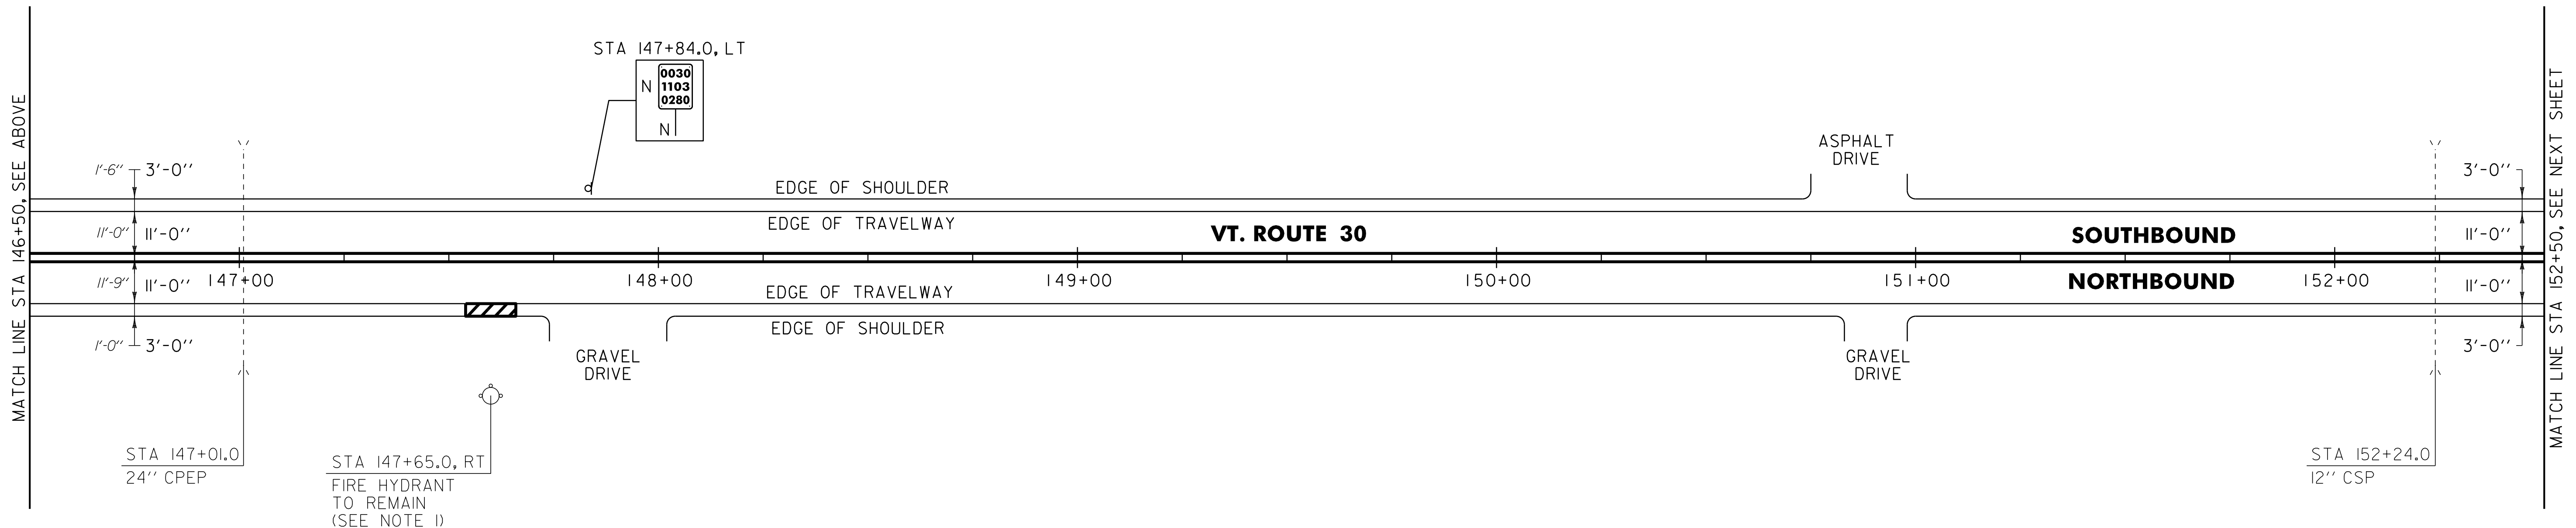


646.402 DURABLE 4 INCH WHITE LINE, THERMOPLASTIC OR
 646.403 DURABLE 4 INCH WHITE LINE, EPOXY PAINT OR
 646.404 DURABLE 4 INCH WHITE LINE, POLYUREA
 (ALL LINES WILL INCLUDE EDGE LINE BREAKS AND
 RADIUS FOR TOWN HIGHWAYS)
 CASTLETON:
 STA 140+50.00 - STA 152+50.00 EDGE LINE LT & RT

646.412 DURABLE 4 INCH YELLOW LINE, THERMOPLASTIC OR
 646.413 DURABLE 4 INCH YELLOW LINE, EPOXY PAINT OR
 646.414 DURABLE 4 INCH YELLOW LINE, POLYUREA
 (ALL LINES WILL INCLUDE C/L BREAKS FOR
 TOWN HIGHWAYS) S=SOLID, D=DASHED
 CASTLETON:
 STA 140+50.00 - STA 152+50.00 LT CL RT
 S - S

646.602 TEMPORARY 4 INCH WHITE LINE, PAINT
 (ALL LINES WILL INCLUDE EDGE LINE BREAKS AND
 RADIUS FOR TOWN HIGHWAYS)
 CASTLETON:
 STA 140+50.00 - STA 152+50.00 LT CL RT
 S - S

646.442 DURABLE 8 INCH WHITE LINE, THERMOPLASTIC OR
 646.443 DURABLE 8 INCH WHITE LINE, EPOXY PAINT OR
 646.444 DURABLE 8 INCH WHITE LINE, POLYUREA
 CASTLETON:
 STA 144+19.0 - STA 144+31.0 FIRE HYDRANT NO PARKING ZONE RT
~~STA 147+59.0 - STA 147+71.0 FIRE HYDRANT NO PARKING ZONE RT~~

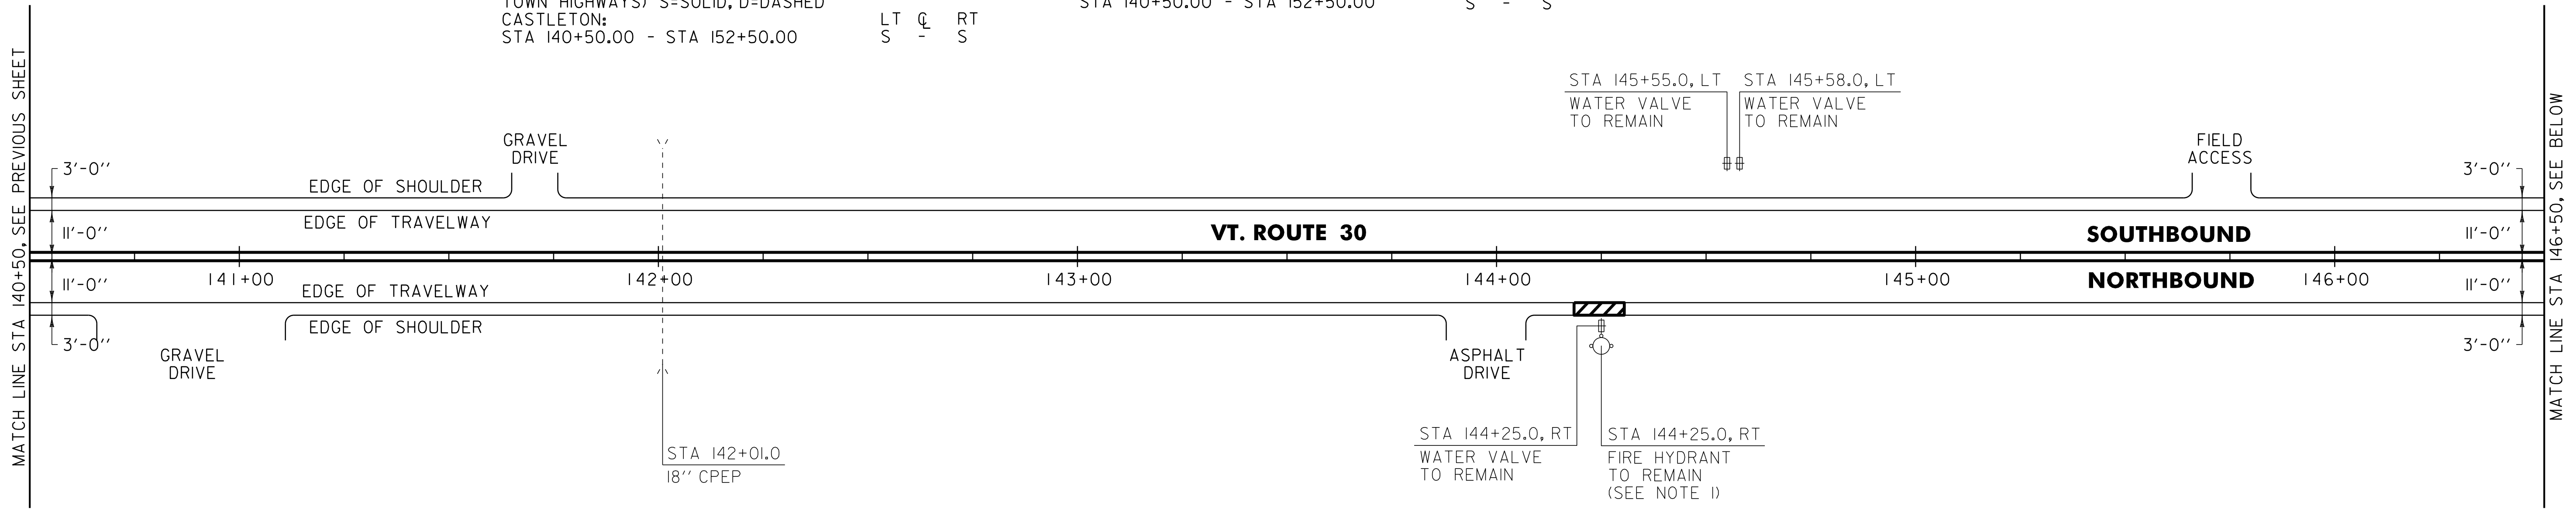

NOTE:
 1. SEE SHEET 8 FOR FIRE HYDRANT PAVEMENT MARKING DETAIL.

SIGN LEGEND
 R = REMOVE
 S = SALVAGE
 N = NEW
 RET = RETAIN
 B-B = BACK TO BACK
 EXISTING = - - - - -
 NEW = _____

NOT TO SCALE

PROJECT LAYOUT SHEET #11	PROJECT NAME: CASTLETON	PLOT DATE: 04-JUN-2013 09:3
	PROJECT NUMBER: STP 2909(1)	DRAWN BY: W.G.P.
	FILE NAME: p10c212.dgn	CHECKED BY: D.E.G.
	DESIGNED BY: M.J.M.	SHEET 139 OF 152
	IPARM FILE: p10c212111.i	