

DURABLE 4 INCH WHITE LINE (SEE OPTION ITEMS)
 STA. 111+75 - STA. 117+25 (SOLID LT & RT)

TEMPORARY 4 INCH WHITE LINE, PAINT
 STA. 111+75 - STA. 117+25 (SOLID LT & RT)





REMOVING SIGNS
 AS SHOWN - 2

DURABLE 4 INCH YELLOW LINE (SEE OPTION ITEMS)
 STA. 111+75 - STA. 117+25 (DASHED)

TEMPORARY 4 INCH YELLOW LINE, PAINT
 STA. 111+75 - STA. 117+25 (DASHED)

THINNING AND TRIMMING FOR SIGNS
 STA. 116+84 RT

CURVE #7
 DELTA = 0°23'26"
 D = 0°41'55"
 R = 8200.00'
 T = 27.96'
 L = 55.91'
 E = 0.05'
 BANKING NORMAL CROWN
 DESIGN SPEED 40 MPH
 SEE SUPERELEVATION DIAGRAMS
 FOR MORE INFORMATION

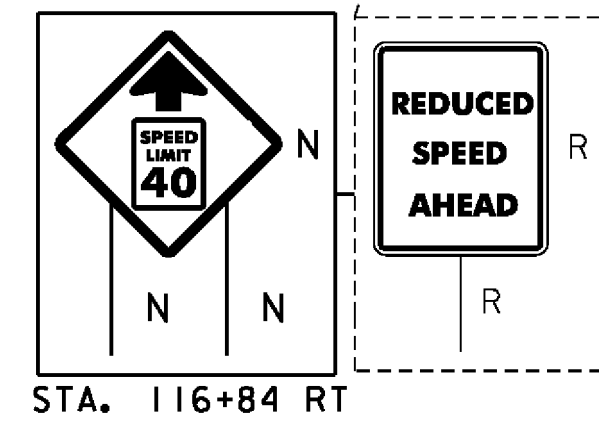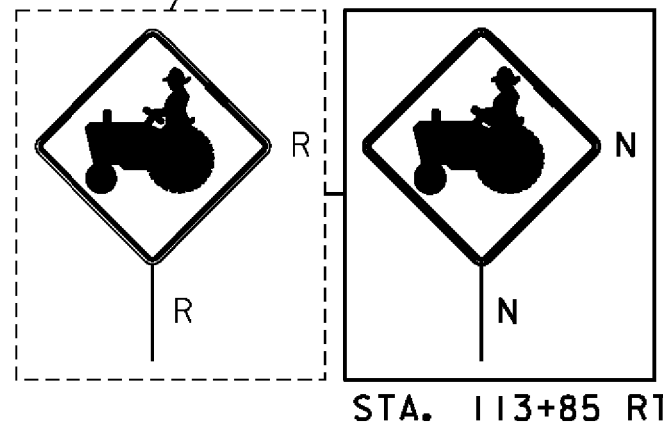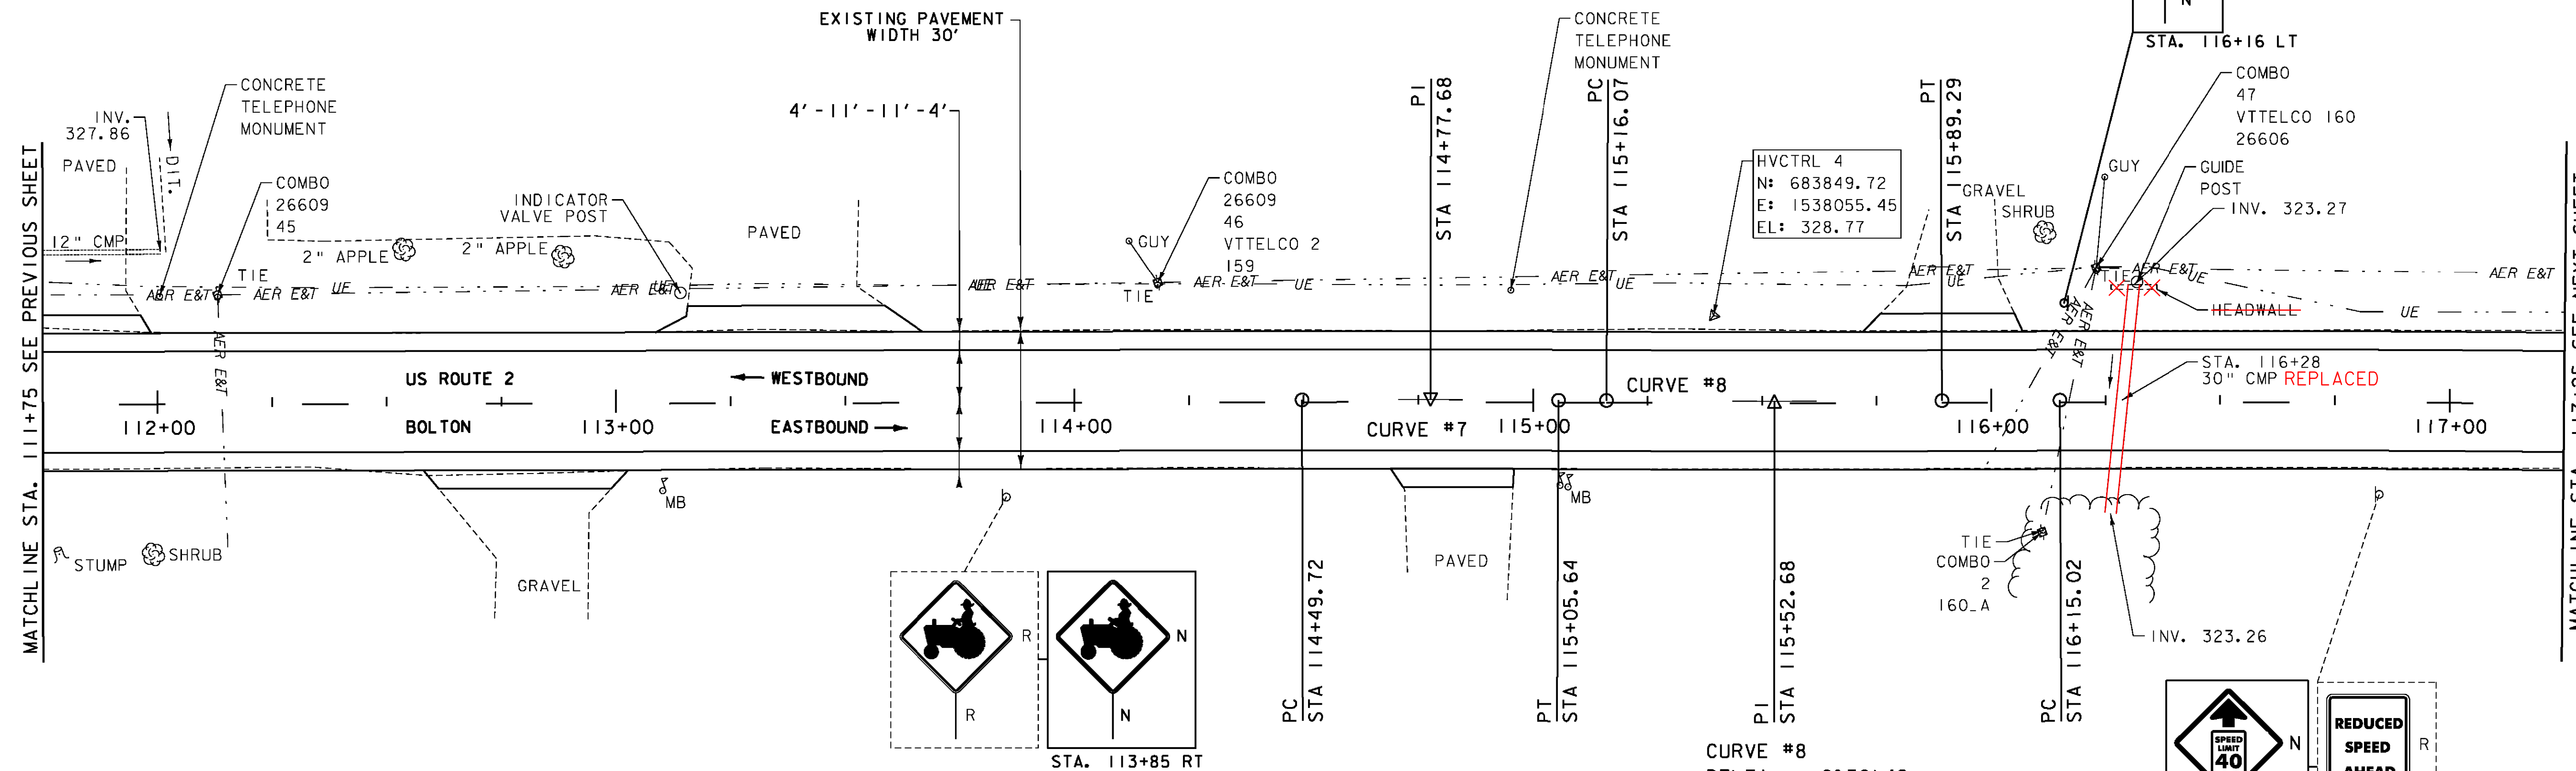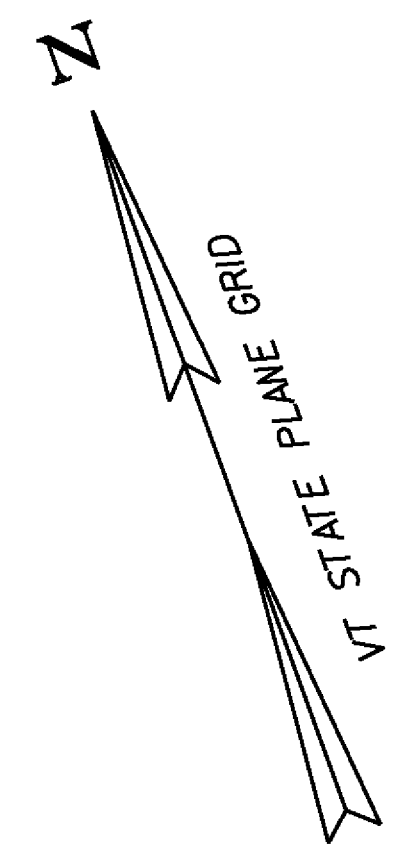


CURVE #8
 DELTA = 0°30'42"
 D = 0°41'55"
 R = 8200.00'
 T = 36.61'
 L = 73.21'
 E = 0.08'
 BANKING NORMAL CROWN
 DESIGN SPEED 40 MPH
 SEE SUPERELEVATION DIAGRAMS
 FOR MORE INFORMATION

- LEGEND**
- MAILBOX
 - ⊙ BORING
 - ⊕ SIGN
 - ⊗ HYDRANT
 - MANHOLE
 - ⊙ WATER SHUT OFF (WSO)
 - ⊙ GAS PIPELINE MARKER
 - ⊙ CATCH BASIN / DROP INLET
 - ⊙ CURB INLET
 - ⊗ TRAFFIC CONTROL BOX
 - ⊕ PARKING METER
 - ⊙ UTILITY POLE

- SIGN LEGEND**
- R = REMOVE
 - R&S = REMOVE AND SALVAGE
 - RET = RETAIN
 - S = SALVAGE
 - N = NEW
 - B-B = BACK TO BACK
 - = EXISTING
 - = NEW

DATUM
 VERTICAL NAVD 88
 HORIZONTAL NAD 83

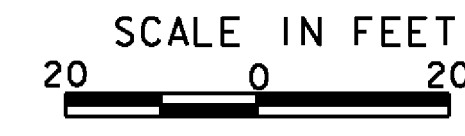

PROJECT LAYOUT SHEET 4	PROJECT NAME: BOLTON - WATERBURY
	PROJECT NUMBER: STP 2709 (1)
	FILE NAME: p07C172.dgn
	PLOT DATE: 4/16/2013
PROJECT LEADER: CDL	DRAWN BY: JBG/BMB
DESIGNED BY: BMB	CHECKED BY: CDL
PLOT FILE: p07C172.28.i	SHEET 28 OF 217