

DURABLE 4 INCH WHITE LINE (SEE OPTION ITEMS)
STA. 129+25 - STA. 134+75 (SOLID LT & RT)



TEMPORARY 4 INCH WHITE LINE, PAINT
STA. 129+25 - STA. 134+75 (SOLID LT & RT)

REMOVING SIGNS
AS SHOWN - 2

DURABLE 4 INCH YELLOW LINE (SEE OPTION ITEMS)
STA. 129+25 - STA. 134+75 (SOLID LT & RT)

TEMPORARY 4 INCH YELLOW LINE, PAINT
STA. 129+25 - STA. 134+75 (SOLID LT & RT)

6 INCH UNDERDRAIN PIPE
STA. 130+75 - STA. 134+00 RT

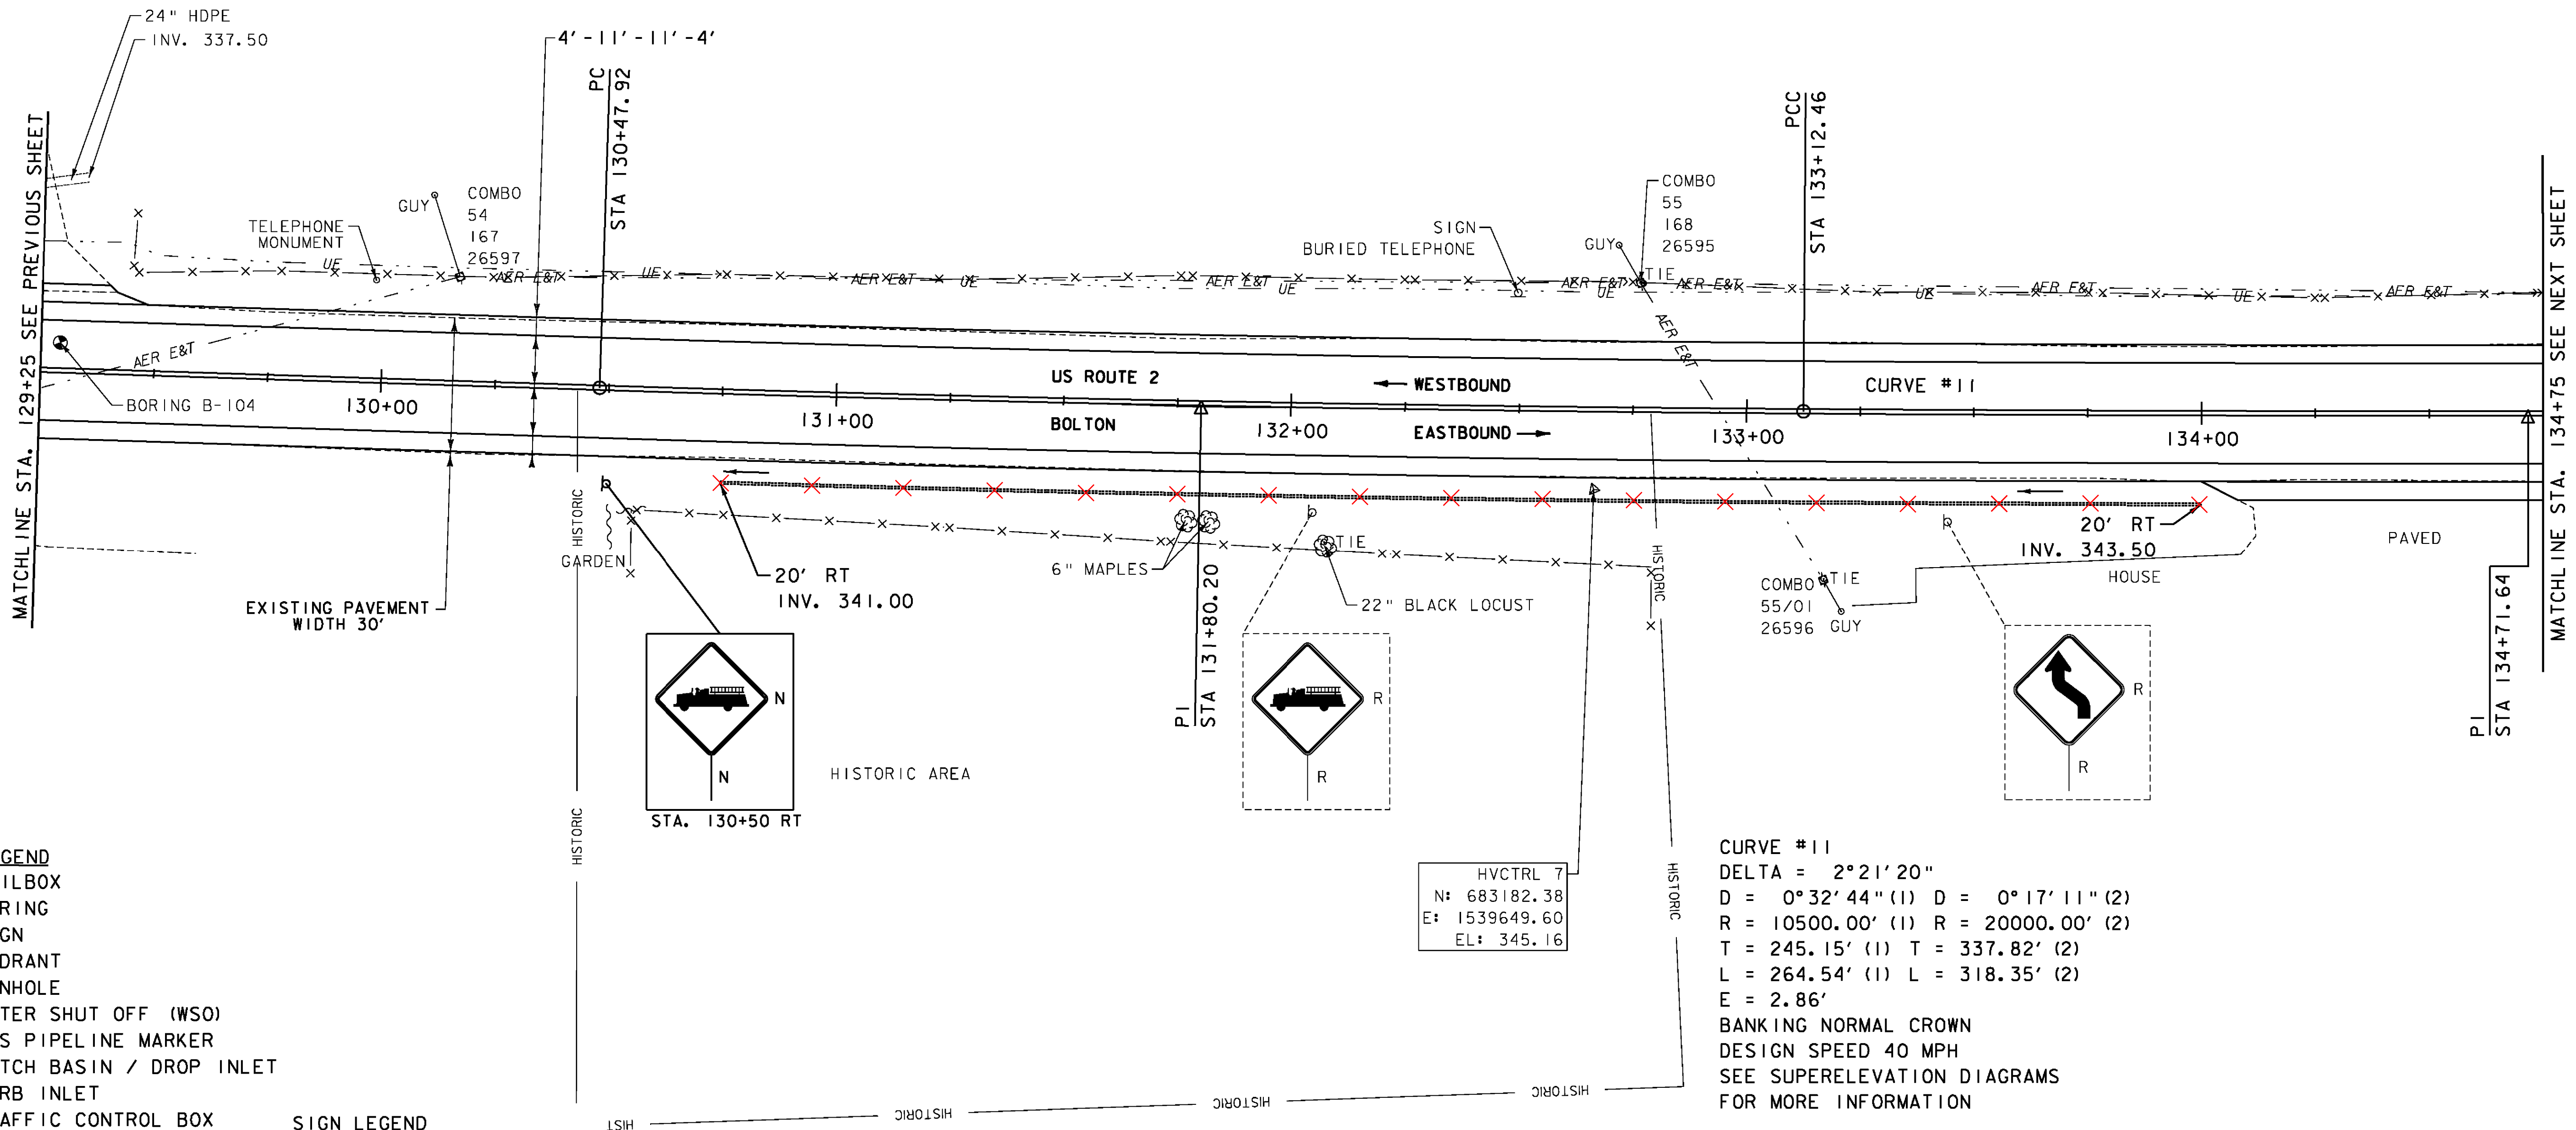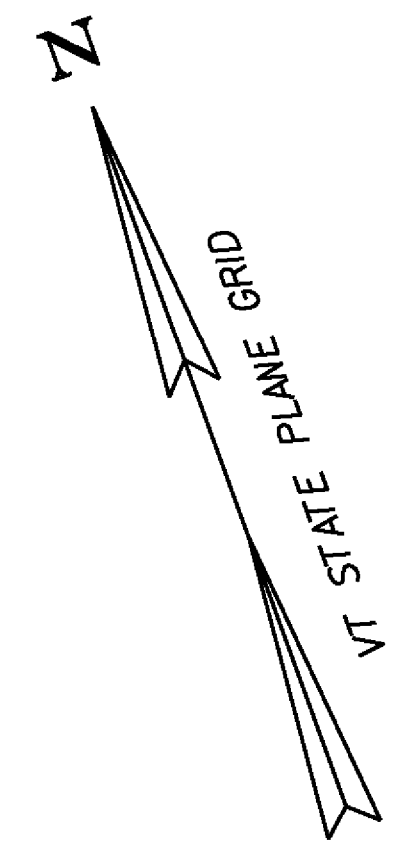

LEGEND

- MAILBOX
- BORING
- SIGN
- HYDRANT
- MANHOLE
- WATER SHUT OFF (WSO)
- GAS PIPELINE MARKER
- CATCH BASIN / DROP INLET
- CURB INLET
- TRAFFIC CONTROL BOX
- PARKING METER
- UTILITY POLE

SIGN LEGEND

- R = REMOVE
- R&S = REMOVE AND SALVAGE
- RET = RETAIN
- S = SALVAGE
- N = NEW
- B-B = BACK TO BACK
- = EXISTING
- = NEW

DATUM
VERTICAL NAVD 88
HORIZONTAL NAD 83

SCALE IN FEET
20 0 20

CURVE #11
DELTA = 2°21'20"
D = 0°32'44" (1) D = 0°17'11" (2)
R = 10500.00' (1) R = 20000.00' (2)
T = 245.15' (1) T = 337.82' (2)
L = 264.54' (1) L = 318.35' (2)
E = 2.86'
BANKING NORMAL CROWN
DESIGN SPEED 40 MPH
SEE SUPERELEVATION DIAGRAMS
FOR MORE INFORMATION

PROJECT LAYOUT SHEET 7

PROJECT NAME: BOLTON - WATERBURY
PROJECT NUMBER: STP 2709 (1)

FILE NAME: p07C172.dgn PLOT DATE: 4/16/2013
PROJECT LEADER: CDL DRAWN BY: JBG/BMB
DESIGNED BY: BMB CHECKED BY: CDL
PLOT FILE: p07C172_31.i SHEET 31 OF 217