



DURABLE 4 INCH WHITE LINE (SEE OPTION ITEMS)
 STA. 134+75 - STA. 140+75 (SOLID LT & RT)

TEMPORARY 4 INCH WHITE LINE, PAINT
 STA. 134+75 - STA. 140+75 (SOLID LT & RT)

REMOVING SIGNS
 AS SHOWN - 5

DURABLE 4 INCH YELLOW LINE (SEE OPTION ITEMS)
 STA. 134+75 - STA. 140+75 (SOLID LT & RT)

TEMPORARY 4 INCH YELLOW LINE, PAINT
 STA. 134+75 - STA. 140+75 (SOLID LT & RT)

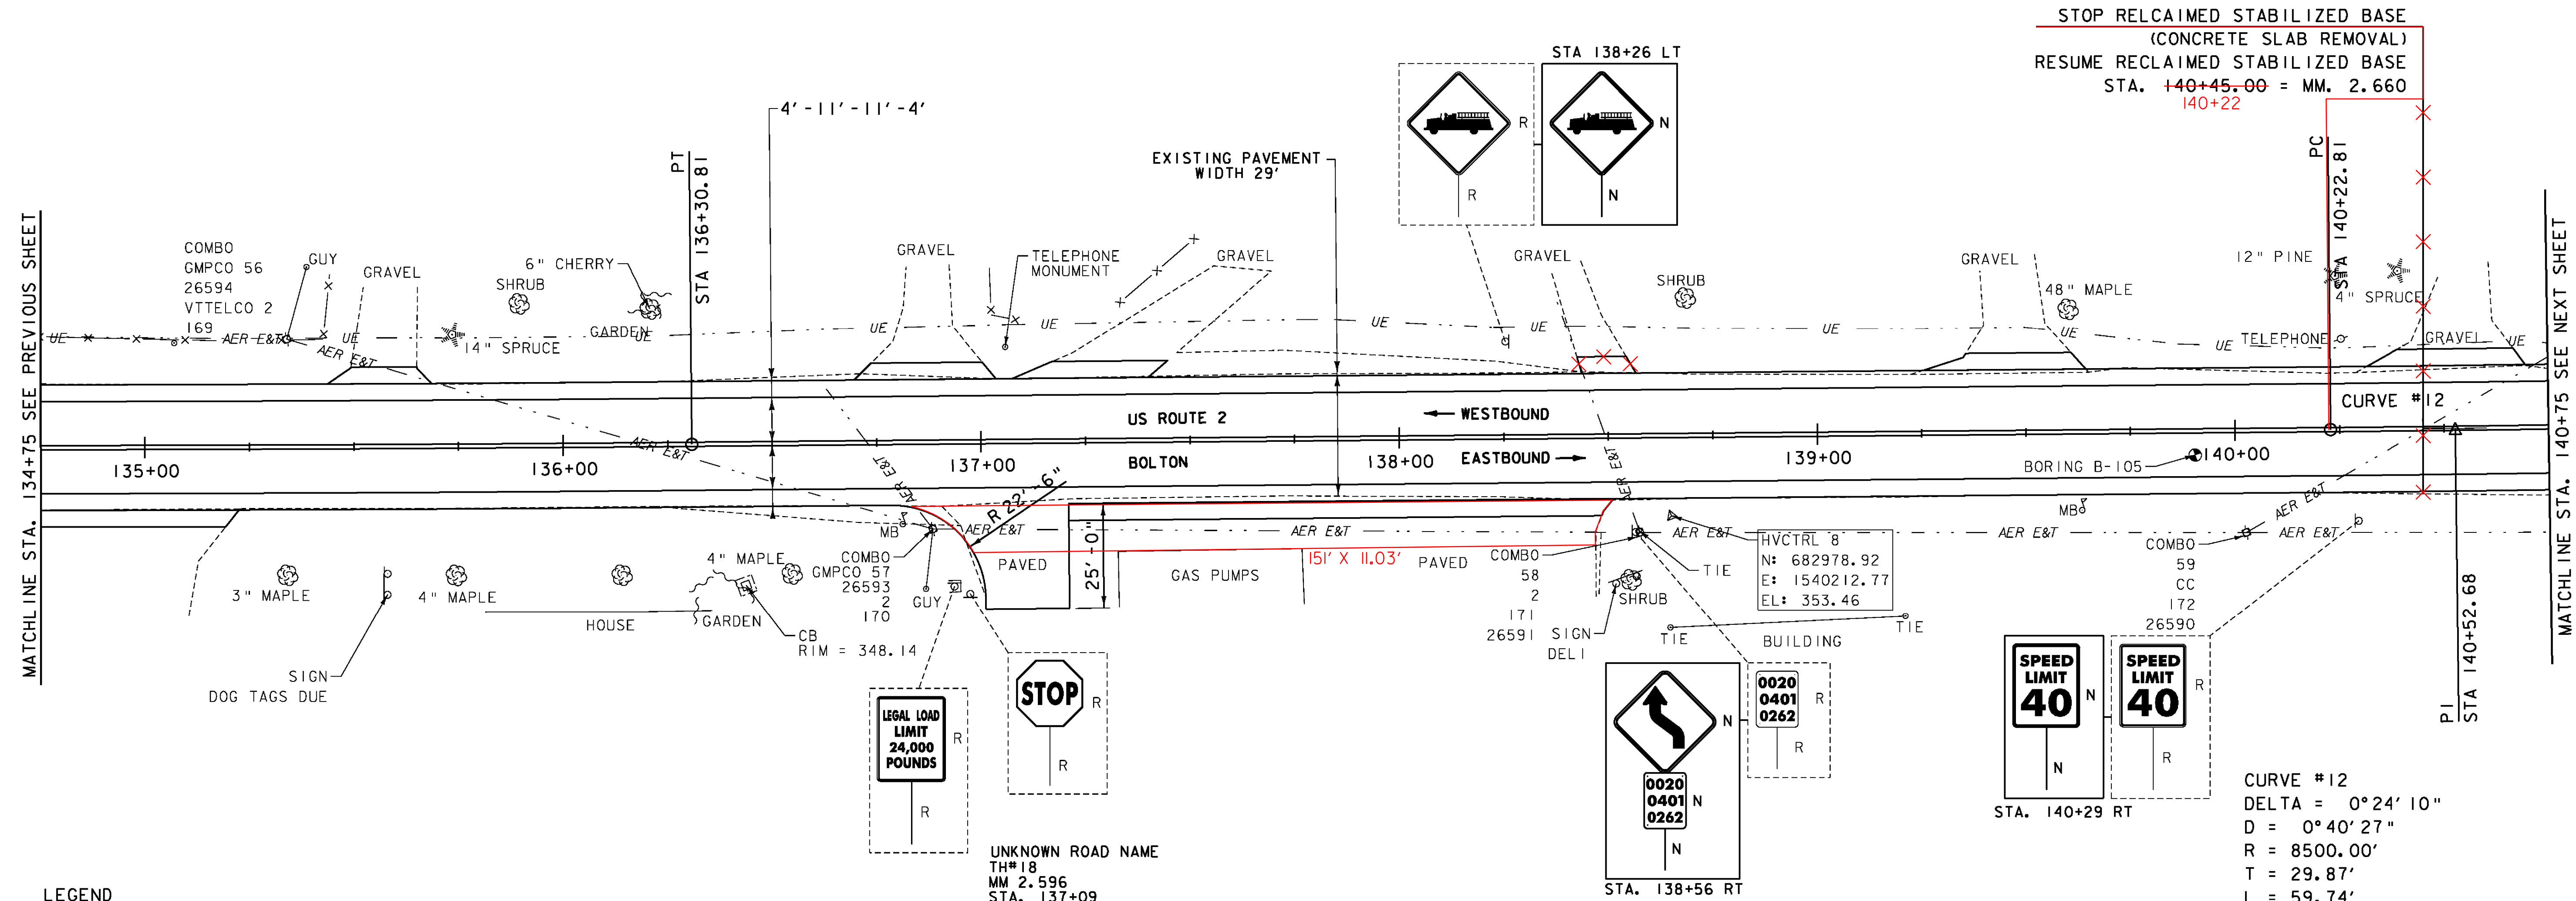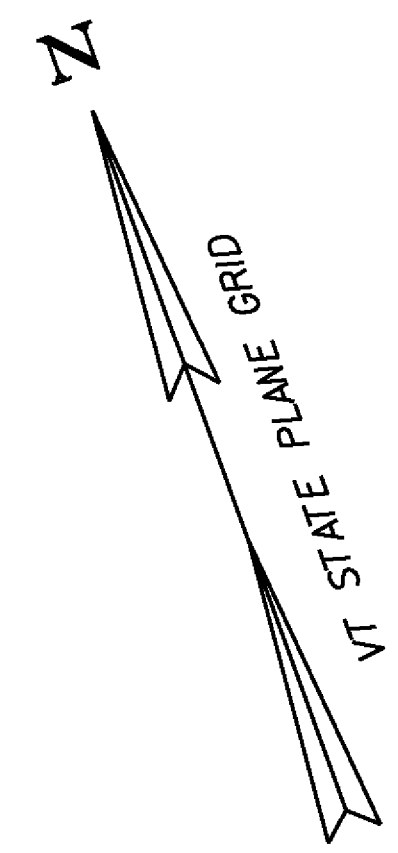


LEGEND

- MAILBOX
- BORING
- SIGN
- HYDRANT
- MANHOLE
- WATER SHUT OFF (WSO)
- GAS PIPELINE MARKER
- CATCH BASIN / DROP INLET
- CURB INLET
- TRAFFIC CONTROL BOX
- PARKING METER
- UTILITY POLE

SIGN LEGEND

- R = REMOVE
- R&S = REMOVE AND SALVAGE
- RET = RETAIN
- S = SALVAGE
- N = NEW
- B-B = BACK TO BACK
- = EXISTING
- = NEW

DATUM
 VERTICAL NAVD 88
 HORIZONTAL NAD 83

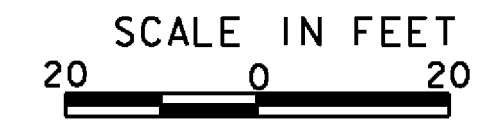

PROJECT LAYOUT SHEET 8	PROJECT NAME: BOLTON - WATERBURY
	PROJECT NUMBER: STP 2709 (1)
	FILE NAME: p07C172.dgn
	PLOT DATE: 4/16/2013
PROJECT LEADER: CDL	DRAWN BY: JBG/BMB
DESIGNED BY: BMB	CHECKED BY: CDL
PLOT FILE: p07C172.32.i	SHEET 32 OF 217

CURVE #12
 DELTA = 0°24'10"
 D = 0°40'27"
 R = 8500.00'
 T = 29.87'
 L = 59.74'
 E = 0.05'
 BANKING NORMAL CROWN
 DESIGN SPEED 40 MPH
 SEE SUPERELEVATION DIAGRAMS
 FOR MORE INFORMATION