

DURABLE 4 INCH WHITE LINE (SEE OPTION ITEMS)  
 STA. 169+75 - STA. 175+75 (SOLID LT & RT)

TEMPORARY 4 INCH WHITE LINE, PAINT  
 STA. 169+75 - STA. 175+75 (SOLID LT & RT)

REMOVAL OF EXISTING FENCE  
 STA. 169+75 - STA. 169+90 RT

DURABLE 4 INCH YELLOW LINE (SEE OPTION ITEMS)  
 STA. 169+75 - STA. 175+25 (SOLID LT, DASHED RT)  
 STA. 175+25 - STA. 175+75 (DASHED)

TEMPORARY 4 INCH YELLOW LINE, PAINT  
 STA. 169+75 - STA. 175+25 (SOLID LT, DASHED RT)  
 STA. 175+25 - STA. 175+75 (DASHED)

SPECIAL PROVISION (REHABILITATE EXISTING FENCE)  
 STA. 170+26 - STA. 175+75 RT

REMOVING SIGNS  
 AS SHOWN - 3

CHAIN-LINK FENCE, 6 FEET  
 STA. 169+75 - STA. 169+90 RT






6 INCH UNDERDRAIN PIPE  
 STA. 171+02 RT - STA. 171+25 - STA. 174+02 RT  
 STA. 174+02 - STA. 175+75 RT - STA. 176+00 RT

CURVE #20  
 DELTA = 0°16'56"  
 D = 0°22'55"  
 R = 15000.00'  
 T = 36.96'  
 L = 73.92'  
 E = 0.05'  
 BANKING NORMAL CROWN  
 DESIGN SPEED 50 MPH  
 SEE SUPERELEVATION DIAGRAMS  
 FOR MORE INFORMATION

BRACING ASSEMBLY FOR CHAIN-LINK FENCE, 6 FEET  
 STA. 169+90 RT

CURVE #21  
 DELTA = 0°08'15"  
 D = 0°13'45"  
 R = 25000.00'  
 T = 30.00'  
 L = 59.99'  
 E = 0.02'  
 BANKING NORMAL CROWN  
 DESIGN SPEED 50 MPH  
 SEE SUPERELEVATION DIAGRAMS  
 FOR MORE INFORMATION

SPECIAL PROVISION (CORING CONCRETE)  
 STA. 174+02 RT  
 STA. 174+02 RT

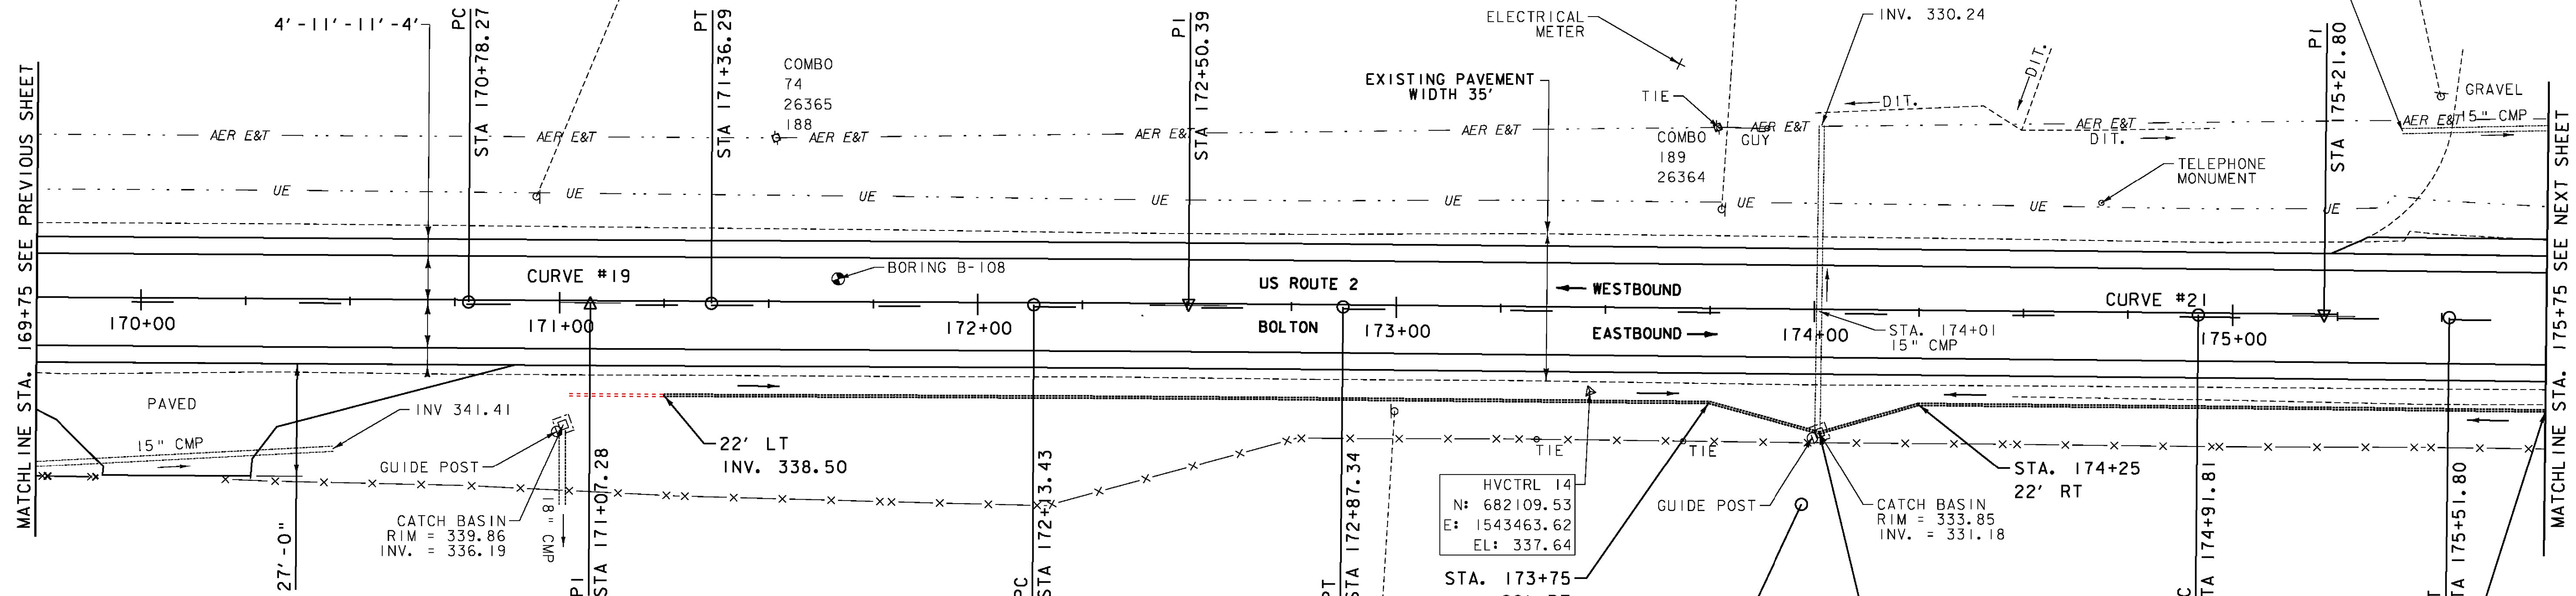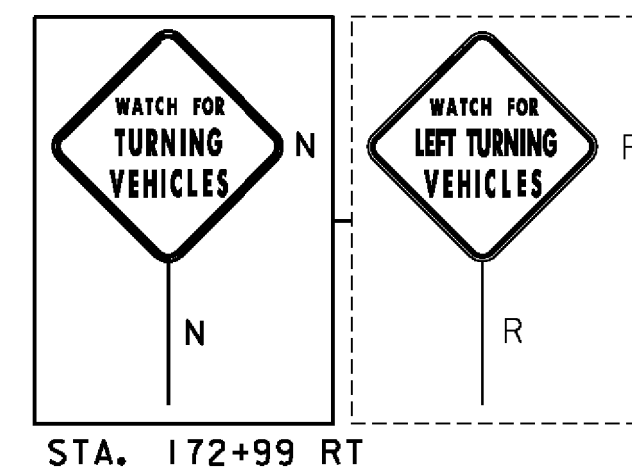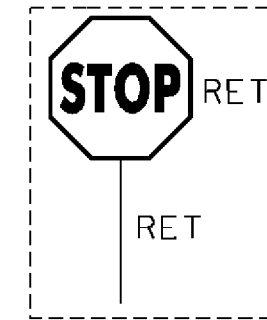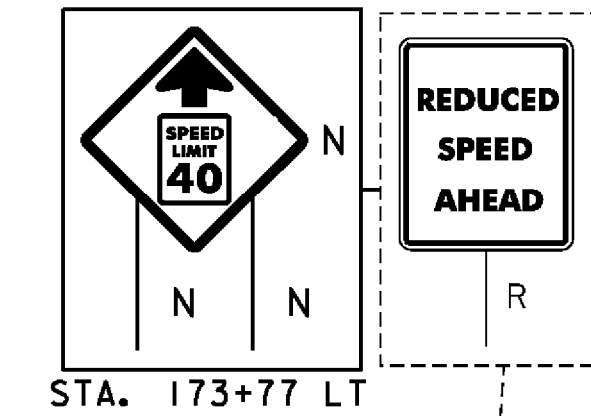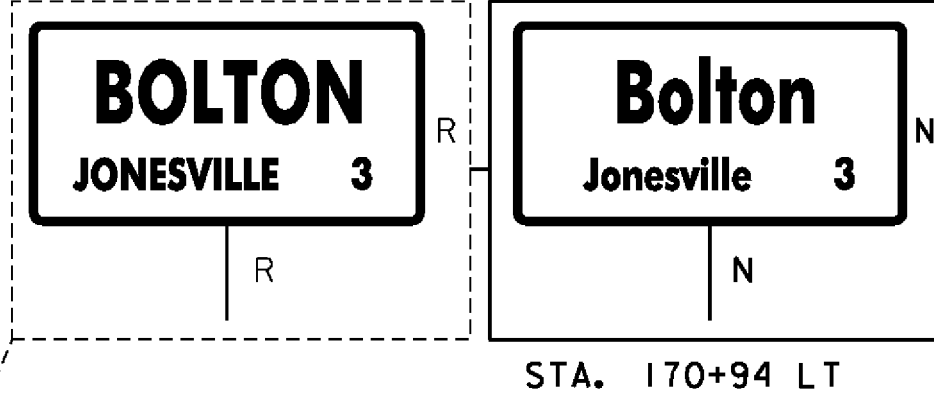

CURVE #19  
 DELTA = 0°06'39"  
 D = 0°11'28"  
 R = 30000.00'  
 T = 29.01'  
 L = 58.02'  
 E = 0.01'  
 BANKING NORMAL CROWN  
 DESIGN SPEED 50 MPH  
 SEE SUPERELEVATION DIAGRAMS  
 FOR MORE INFORMATION

CONTRACTOR TO REMOVE ALL TREES, BRUSH, AND SHRUBBERY BETWEEN  
 FENCE LINE AND I-89 (24 FT AVERAGE WIDTH) AS DIRECTED BY THE  
 RESIDENT ENGINEER. PAY ITEM 900.645 "SPECIAL PROVISION (CLEARING)".  
 STA. 170+26 - STA. 175+75

LEGEND

- MAILBOX
- BORING
- SIGN
- HYDRANT
- MANHOLE
- WATER SHUT OFF (WSO)
- GAS PIPELINE MARKER
- CATCH BASIN / DROP INLET
- CURB INLET
- TRAFFIC CONTROL BOX
- PARKING METER
- UTILITY POLE

SIGN LEGEND

- R = REMOVE
- R&S = REMOVE AND SALVAGE
- RET = RETAIN
- S = SALVAGE
- N = NEW
- B-B = BACK TO BACK
- = EXISTING
- = NEW

DATUM  
 VERTICAL NAVD 88  
 HORIZONTAL NAD 83

SCALE IN FEET  
 20 0 20

PROJECT  
 LAYOUT  
 SHEET 14

PROJECT NAME: BOLTON - WATERBURY  
 PROJECT NUMBER: STP 2709 (1)

FILE NAME: p07C172.dgn PLOT DATE: 4/16/2013  
 PROJECT LEADER: CDL DRAWN BY: JBG/BMB  
 DESIGNED BY: BMB CHECKED BY: CDL  
 PLOT FILE: p07C172.38.i SHEET 38 OF 217