

DURABLE 4 INCH WHITE LINE (SEE OPTION ITEMS)
 STA. 193+25 - STA. 199+25 (SOLID LT & RT)

TEMPORARY 4 INCH WHITE LINE, PAINT
 STA. 193+25 - STA. 199+25 (SOLID LT & RT)

REMOVING SIGNS
 AS SHOWN - 1

REMOVAL OF EXISTING FENCE
 STA. 193+25 - STA. 199+25 RT


DURABLE 4 INCH YELLOW LINE (SEE OPTION ITEMS)
 STA. 193+25 - STA. 198+00 (DASHED)
 STA. 198+00 - STA. 199+25 (DASHED LT, SOLID RT)

TEMPORARY 4 INCH YELLOW LINE, PAINT
 STA. 193+25 - STA. 198+00 (DASHED)
 STA. 198+00 - STA. 199+25 (DASHED LT, SOLID RT)


6 INCH UNDERDRAIN PIPE
 STA. 193+25 - STA. ~~195+75~~ RT 195+86 RT
 STA. 196+00 - STA. ~~199+25~~ RT 199+46 RT

CHAIN-LINK FENCE, 6 FEET
 STA. 193+25 - STA. 199+25 RT

SPECIAL PROVISION (CORING CONCRETE)
 STA. 196+00 RT

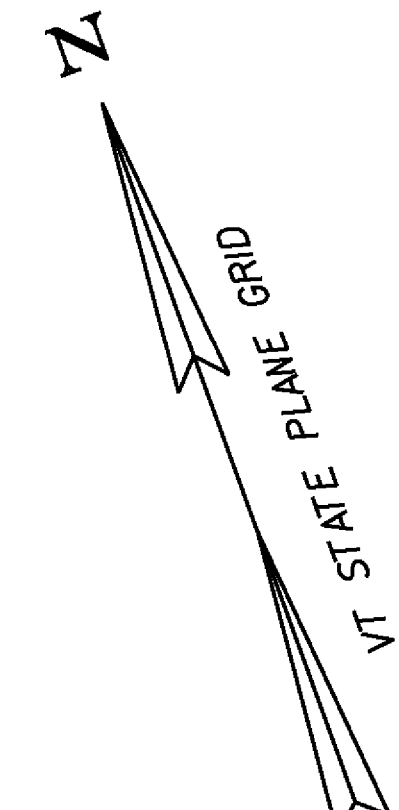

CURVE #27
 DELTA = 0°11'02"
 D = 0°17'11"
 R = 20000.00'
 T = 32.07'
 L = 64.14'
 E = 0.03'
 BANKING NORMAL CROWN
 DESIGN SPEED 50 MPH
 SEE SUPERELEVATION DIAGRAMS
 FOR MORE INFORMATION

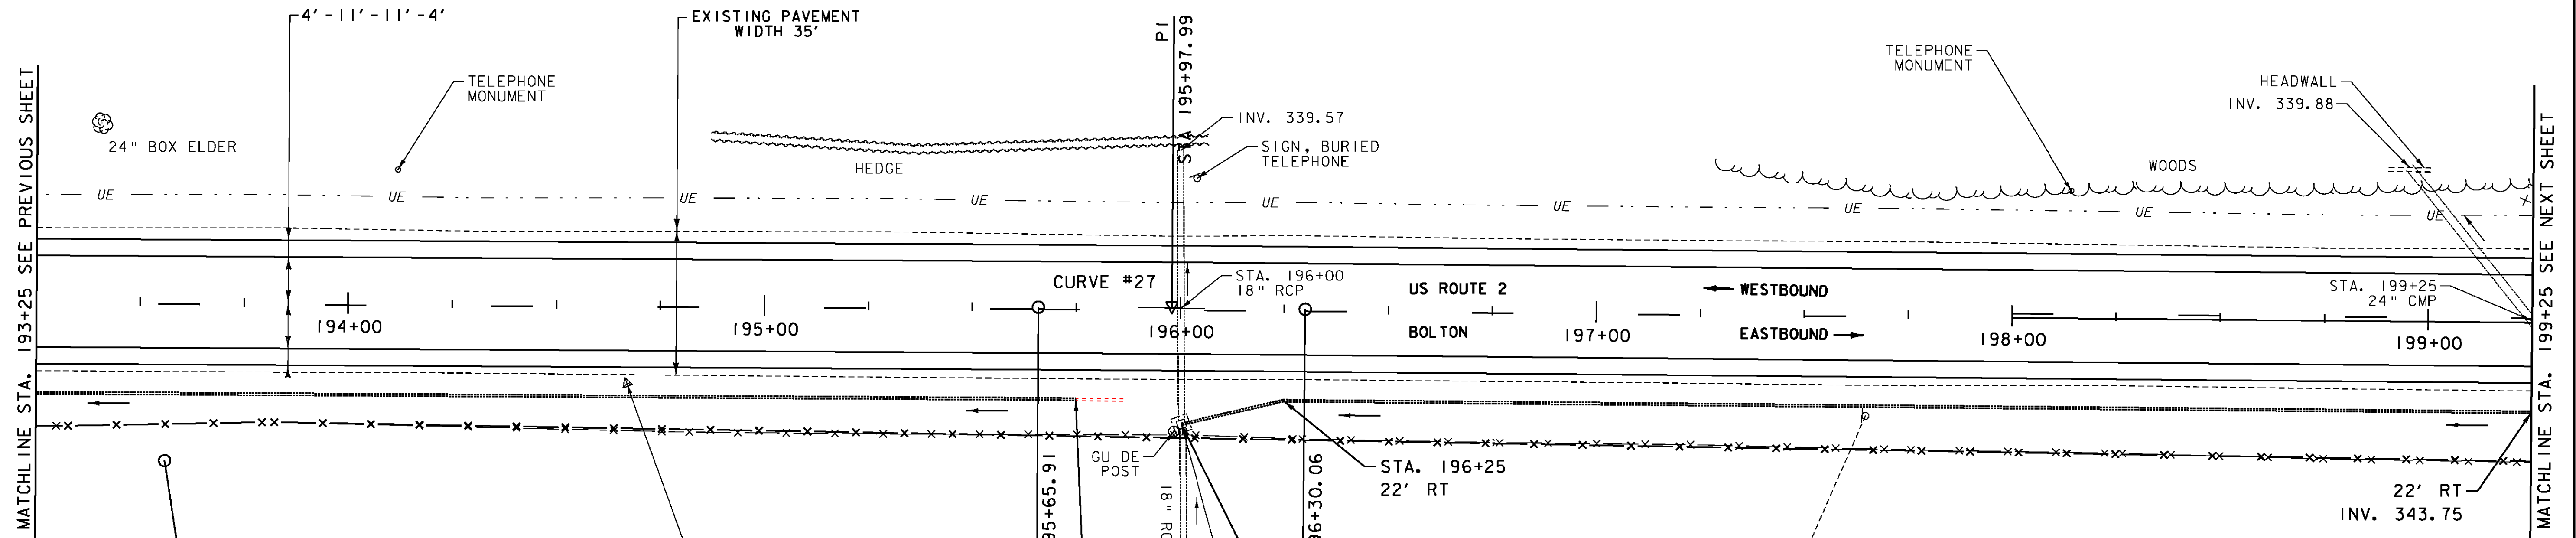


CONTRACTOR TO REMOVE ALL TREES, BRUSH, AND SHRUBBERY BETWEEN FENCE LINE AND 1-89 (24 FT AVERAGE WIDTH) AS DIRECTED BY THE RESIDENT ENGINEER.
 PAY ITEM 900.645 "SPECIAL PROVISION (CLEARING)".
 STA. 193+25 - STA. 199+25

HVCTRL 18
 N: 681372.49
 E: 1545451.97
 EL: 345.01

PC STA 195+65.91
 22' RT
 INV. 341.50


PT STA 196+30.06
 INV. 340.50
 CONNECT PROPOSED UNDERDRAIN TO CATCH BASIN (PAY ITEM 900.620 "SPECIAL PROVISION (CORING CONCRETE)")
 CATCH BASIN
 RIM = 342.58
 INV. = 340.01
 INV. = 340.51

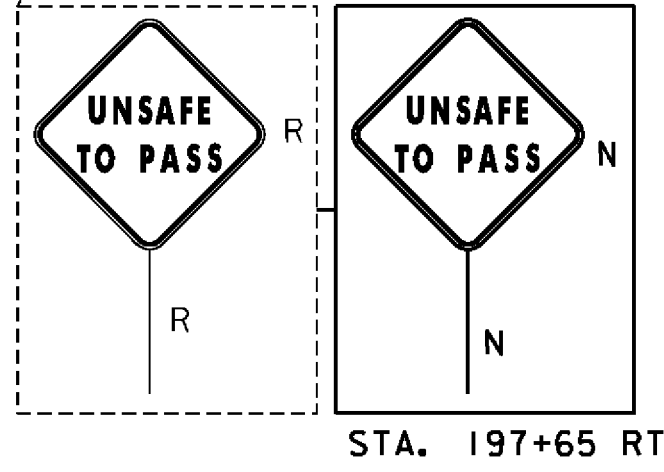

- LEGEND**
- MAILBOX
 - BORING
 - SIGN
 - HYDRANT
 - MANHOLE
 - WATER SHUT OFF (WSO)
 - GAS PIPELINE MARKER
 - CATCH BASIN / DROP INLET
 - CURB INLET
 - TRAFFIC CONTROL BOX
 - PARKING METER
 - UTILITY POLE

- SIGN LEGEND**
- R = REMOVE
 - R&S = REMOVE AND SALVAGE
 - RET = RETAIN
 - S = SALVAGE
 - N = NEW
 - B-B = BACK TO BACK
 - = EXISTING
 - = NEW

DATUM
 VERTICAL NAVD 88
 HORIZONTAL NAD 83

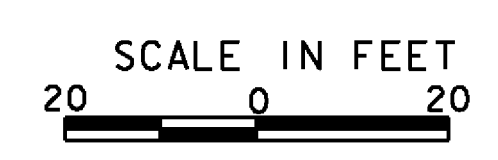

PROJECT LAYOUT SHEET 18	PROJECT NAME: BOLTON - WATERBURY
	PROJECT NUMBER: STP 2709 (1)
	FILE NAME: p07C172.dgn
	PLOT DATE: 4/16/2013
PROJECT LEADER: CDL	DRAWN BY: JBG/BMB
DESIGNED BY: BMB	CHECKED BY: CDL
PLOT FILE: p07C172_42.i	SHEET 42 OF 217