

DURABLE 4 INCH WHITE LINE (SEE OPTION ITEMS)
 STA. 216+75 - STA. 222+75 (SOLID LT & RT)

DURABLE 4 INCH YELLOW LINE (SEE OPTION ITEMS)
 STA. 216+75 - STA. 222+75 (DASHED)

6 INCH UNDERDRAIN PIPE
 STA. 216+75 - STA. 217+99 RT
 STA. 217+99 - ~~STA. 220+75 RT~~ 220+77 RT
 STA. 221+00 - STA. 222+75 RT

SPECIAL PROVISION (CORING CONCRETE)
 STA. 217+99 RT
 STA. 217+99 RT
 STA. 221+00 RT

SPECIAL PROVISION (REHABILITATE EXISTING FENCE)
 STA. 216+75 - STA. 222+75 RT

TEMPORARY 4 INCH WHITE LINE, PAINT
 STA. 216+75 - STA. 222+75 (SOLID LT & RT)



TEMPORARY 4 INCH YELLOW LINE, PAINT
 STA. 216+75 - STA. 222+75 (DASHED)

REMOVING SIGNS
 AS SHOWN - 1

RELOCATE MAILBOX, SINGLE SUPPORT
 STA. 219+51 RT

REMOVE AND RESET GUARDRAIL
 STA. 216+75 - STA. 217+20 LT

STEEL BEAM GUARDRAIL, GALVANIZED W/8 FEET POSTS
 STA. 217+20 - STA. 217+51.25 LT

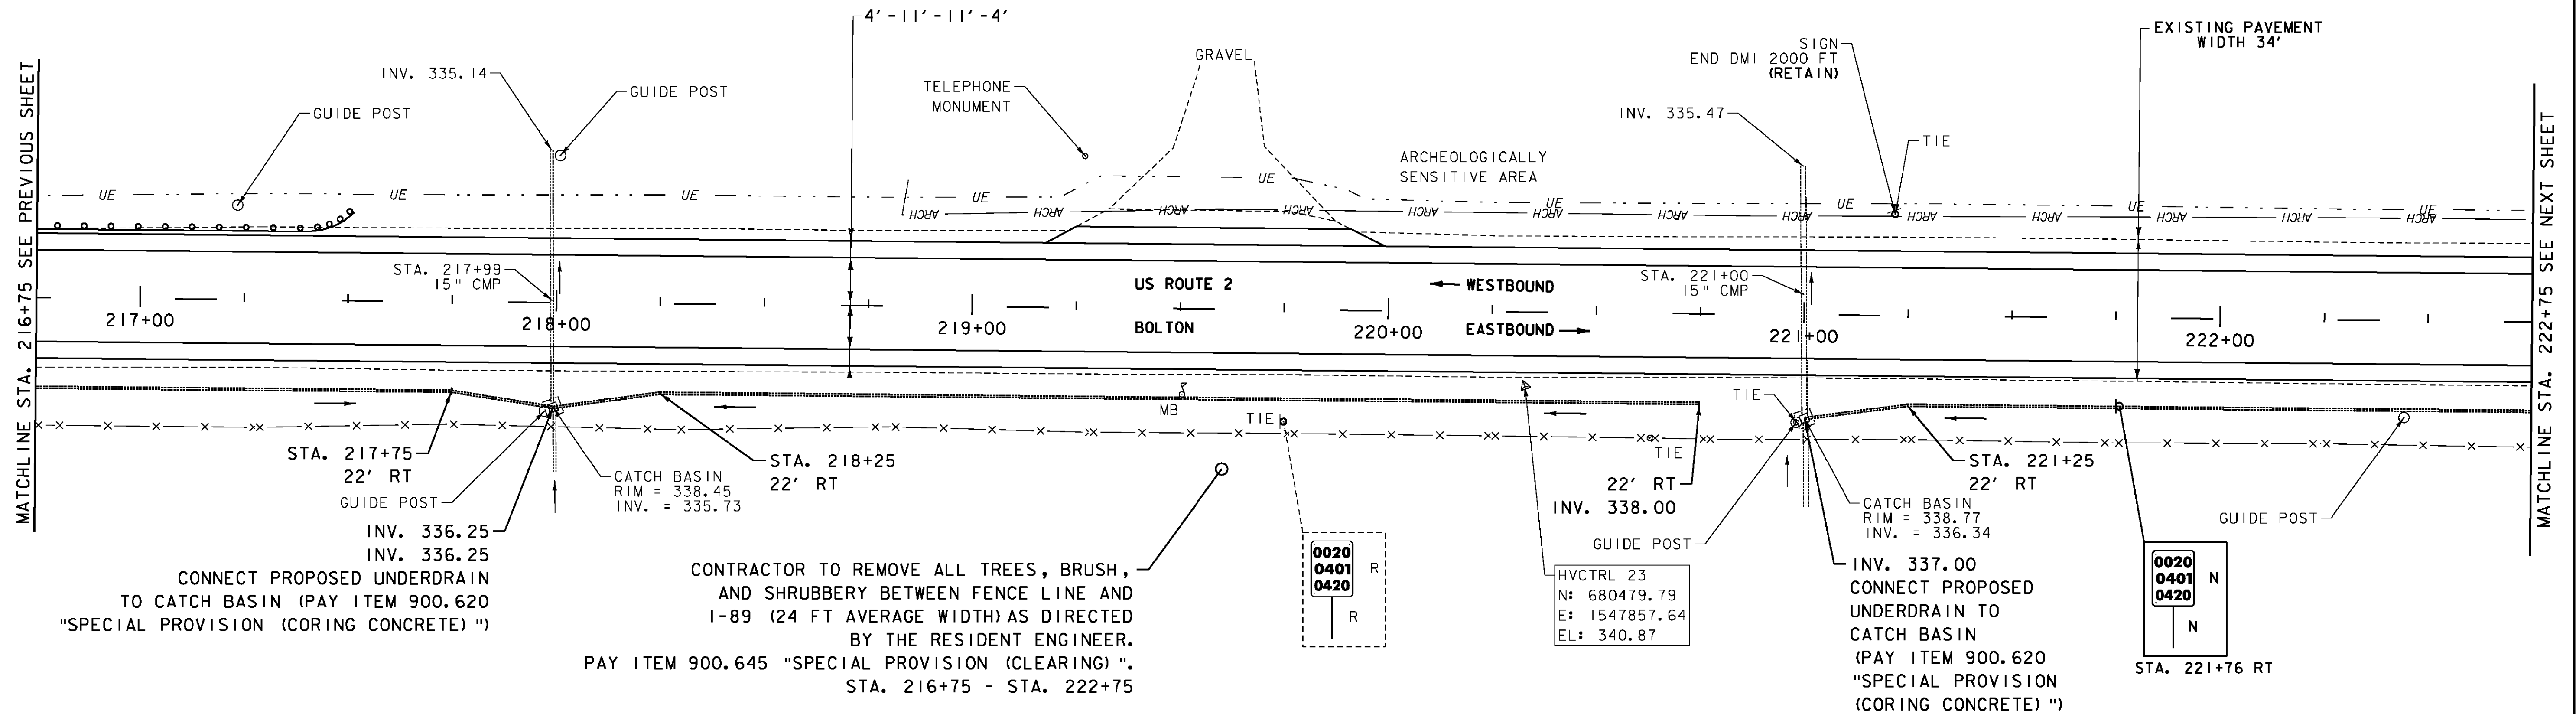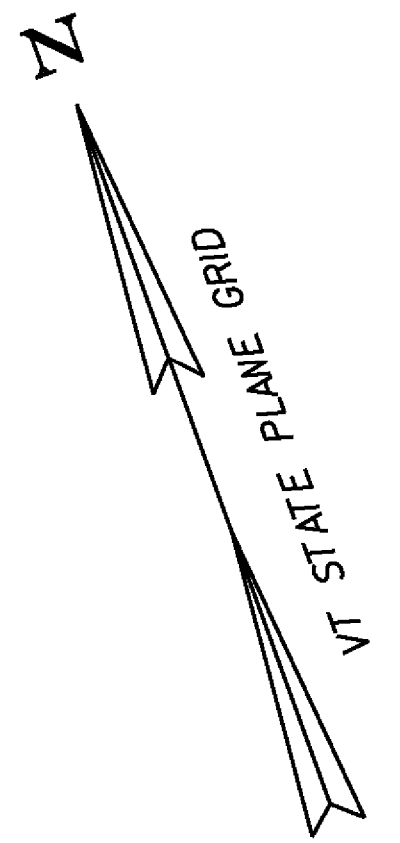

LEGEND

- MAILBOX
- BORING
- SIGN
- HYDRANT
- MANHOLE
- WATER SHUT OFF (WSO)
- GAS PIPELINE MARKER
- CATCH BASIN / DROP INLET
- CURB INLET
- ⊗ TRAFFIC CONTROL BOX
- ⊕ PARKING METER
- ⊖ UTILITY POLE

SIGN LEGEND

- R = REMOVE
- R&S = REMOVE AND SALVAGE
- RET = RETAIN
- S = SALVAGE
- N = NEW
- B-B = BACK TO BACK
- = EXISTING
- = NEW

DATUM
 VERTICAL NAVD 88
 HORIZONTAL NAD 83

SCALE IN FEET
 20 0 20

PROJECT LAYOUT SHEET 22

PROJECT NAME: BOLTON - WATERBURY
 PROJECT NUMBER: STP 2709 (1)

FILE NAME: p07C172.dgn PLOT DATE: 4/16/2013
 PROJECT LEADER: CDL DRAWN BY: JBG/BMB
 DESIGNED BY: BMB CHECKED BY: CDL
 PLOT FILE: p07C172_46.i SHEET 46 OF 217