

DURABLE 4 INCH WHITE LINE (SEE OPTION ITEMS)
 STA. 234+50 - STA. 240+50 (SOLID LT & RT)

DURABLE 4 INCH YELLOW LINE (SEE OPTION ITEMS)
 STA. 234+50 - STA. 240+50 (DASHED)

TEMPORARY 4 INCH WHITE LINE, PAINT
 STA. 234+50 - STA. 240+50 (SOLID LT & RT)

TEMPORARY 4 INCH YELLOW LINE, PAINT
 STA. 234+50 - STA. 240+50 (DASHED)

REMOVAL OF EXISTING FENCE
 STA. 239+20 - STA. 239+80 RT

CHAIN-LINK FENCE, 6 FEET
 STA. 239+20 - STA. 239+80 RT



REMOVING SIGNS
 AS SHOWN - 3

SPECIAL PROVISION (REHABILITATE EXISTING FENCE)
 STA. 234+50 - STA. 239+20 RT
 STA. 239+80 - STA. 240+50 RT

6 INCH UNDERDRAIN PIPE
 STA. 234+50 - STA. ~~235+50~~ RT 235+53 RT
 STA. 236+00 - STA. 240+50 RT

SPECIAL PROVISION (CORING CONCRETE)
 STA. 236+00 RT

CURVE #35
 DELTA = 0°07'36"
 D = 0°13'45"
 R = 25000.00'
 T = 27.66'
 L = 55.32'
 E = 0.02'
 BANKING NORMAL CROWN
 DESIGN SPEED 50 MPH
 SEE SUPERELEVATION DIAGRAMS
 FOR MORE INFORMATION

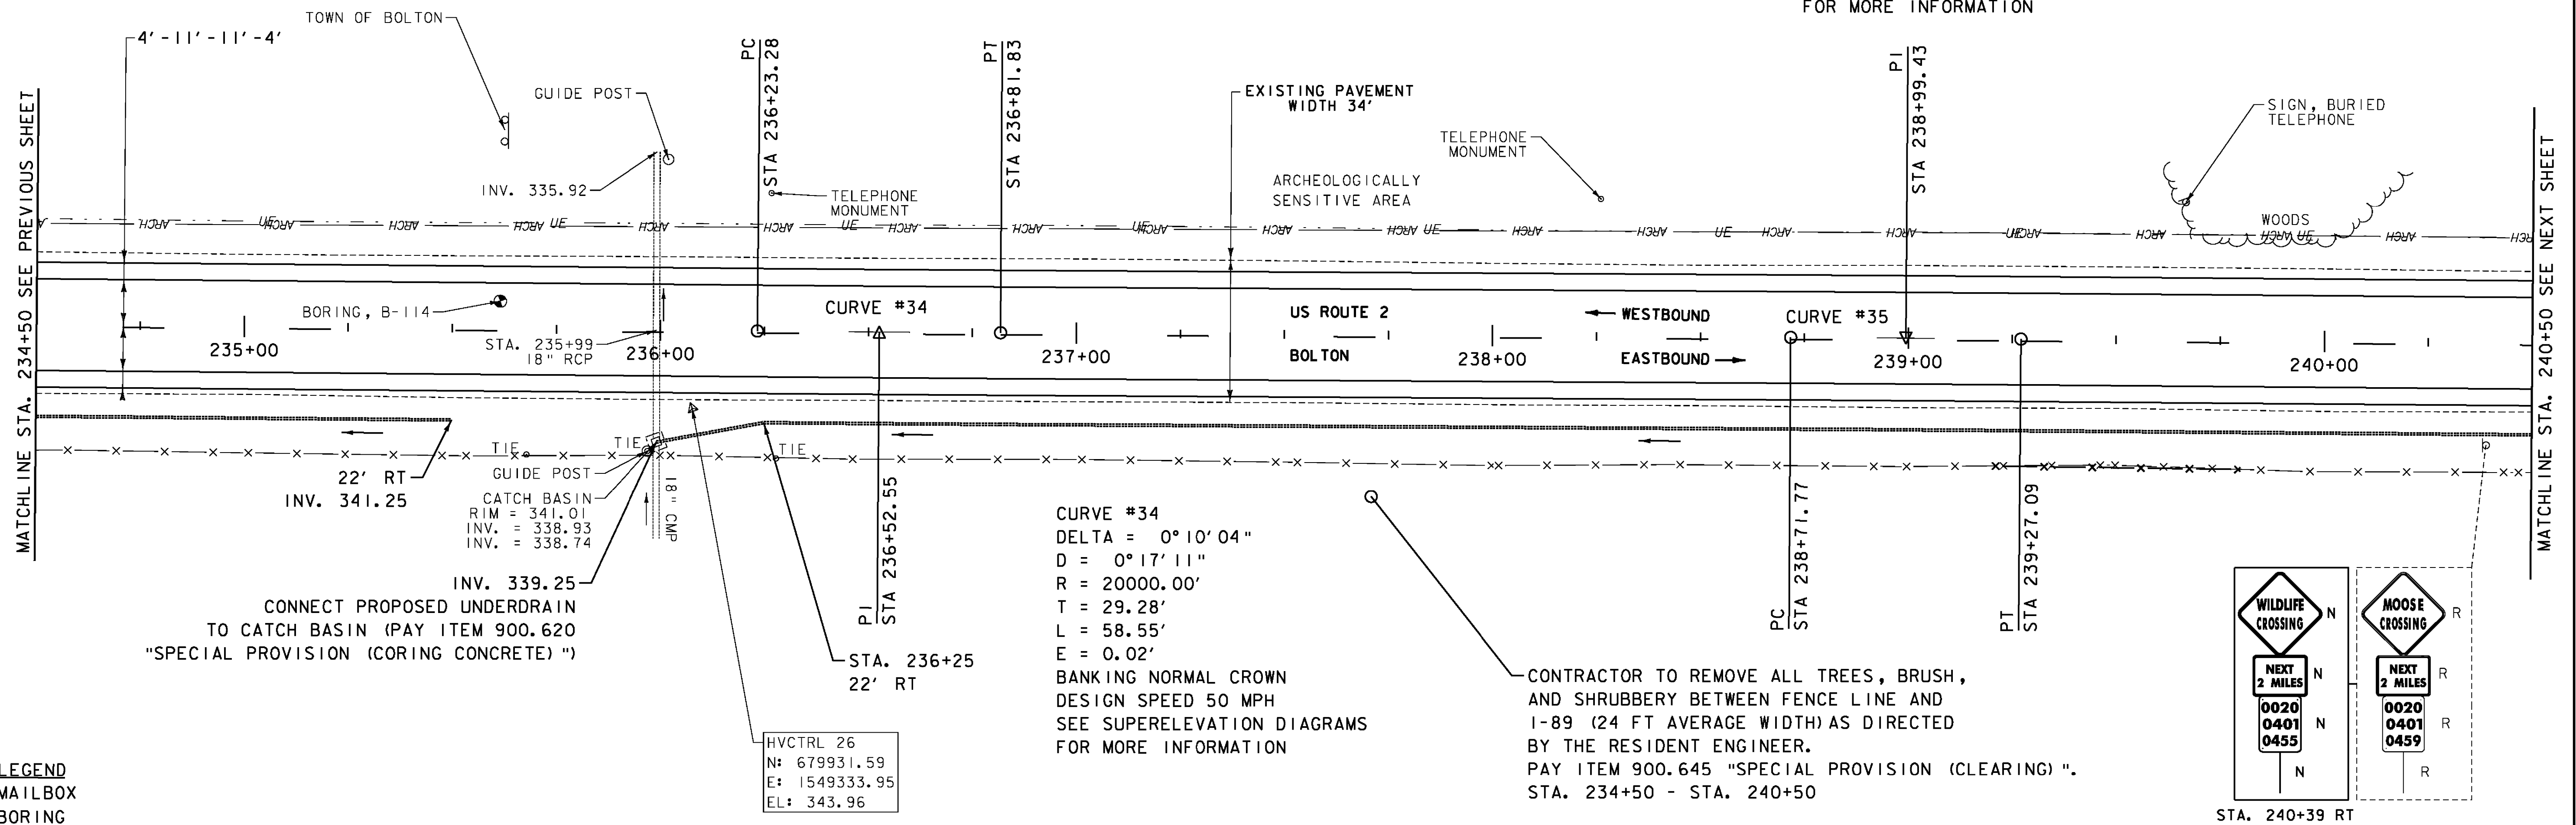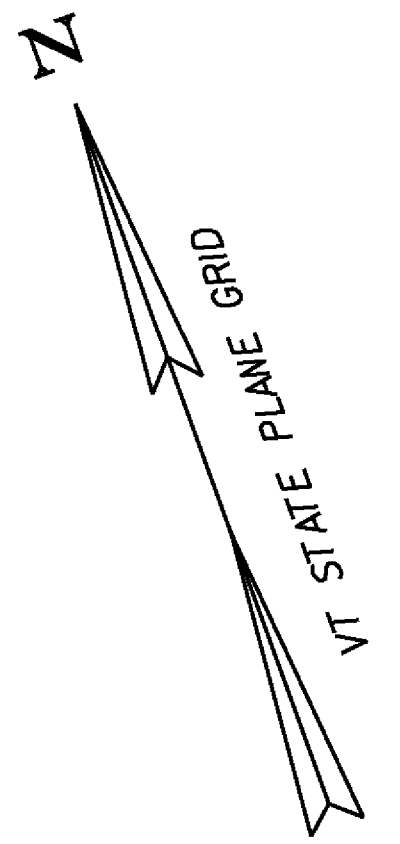

LEGEND

- MAILBOX
- BORING
- SIGN
- HYDRANT
- MANHOLE
- WATER SHUT OFF (WSO)
- GAS PIPELINE MARKER
- CATCH BASIN / DROP INLET
- CURB INLET
- TRAFFIC CONTROL BOX
- PARKING METER
- UTILITY POLE

SIGN LEGEND

- R = REMOVE
- R&S = REMOVE AND SALVAGE
- RET = RETAIN
- S = SALVAGE
- N = NEW
- B-B = BACK TO BACK
- = EXISTING
- = NEW

DATUM
 VERTICAL NAVD 88
 HORIZONTAL NAD 83

SCALE IN FEET
 20 0 20

PROJECT LAYOUT SHEET 25

PROJECT NAME: BOLTON - WATERBURY
 PROJECT NUMBER: STP 2709 (1)

FILE NAME: p07C172.dgn PLOT DATE: 4/16/2013
 PROJECT LEADER: CDL DRAWN BY: JBG/BMB
 DESIGNED BY: BMB CHECKED BY: CDL
 PLOT FILE: p07C172_49.i SHEET 49 OF 217