

DURABLE 4 INCH WHITE LINE (SEE OPTION ITEMS)  
 STA. 240+50 - STA. 246+25 (SOLID LT & RT)

TEMPORARY 4 INCH WHITE LINE, PAINT  
 STA. 240+50 - STA. 246+25 (SOLID LT & RT)

6 INCH UNDERDRAIN PIPE  
 STA. 240+50 - STA. 240+75 RT  
 STA. 241+00 - ~~STA. 243+75 RT~~ STA. 243+72 RT  
 STA. 244+00 - STA. 246+25 RT

DURABLE 4 INCH YELLOW LINE (SEE OPTION ITEMS)  
 STA. 240+50 - STA. 245+50 (DASHED)  
 STA. 245+50 - STA. 246+25 (DASHED LT, SOLID RT)



TEMPORARY 4 INCH YELLOW LINE, PAINT  
 STA. 240+50 - STA. 245+50 (DASHED)  
 STA. 245+50 - STA. 246+25 (DASHED LT, SOLID RT)

SPECIAL PROVISION (CORING CONCRETE)  
 STA. 241+00 RT  
 STA. 244+00 RT

RELOCATE MAILBOX, SINGLE SUPPORT  
 STA. 243+03 RT  
 STA. 246+13 RT

SPECIAL PROVISION (REHABILITATE EXISTING FENCE)  
 STA. 240+50 - STA. 246+25 RT

CURVE #36  
 DELTA = 0°39'36"  
 D = 0°34'23"  
 R = 10000.00'  
 T = 57.59'  
 L = 115.18'  
 E = 0.17'  
 BANKING NORMAL CROWN  
 DESIGN SPEED 50 MPH  
 SEE SUPERELEVATION DIAGRAMS  
 FOR MORE INFORMATION

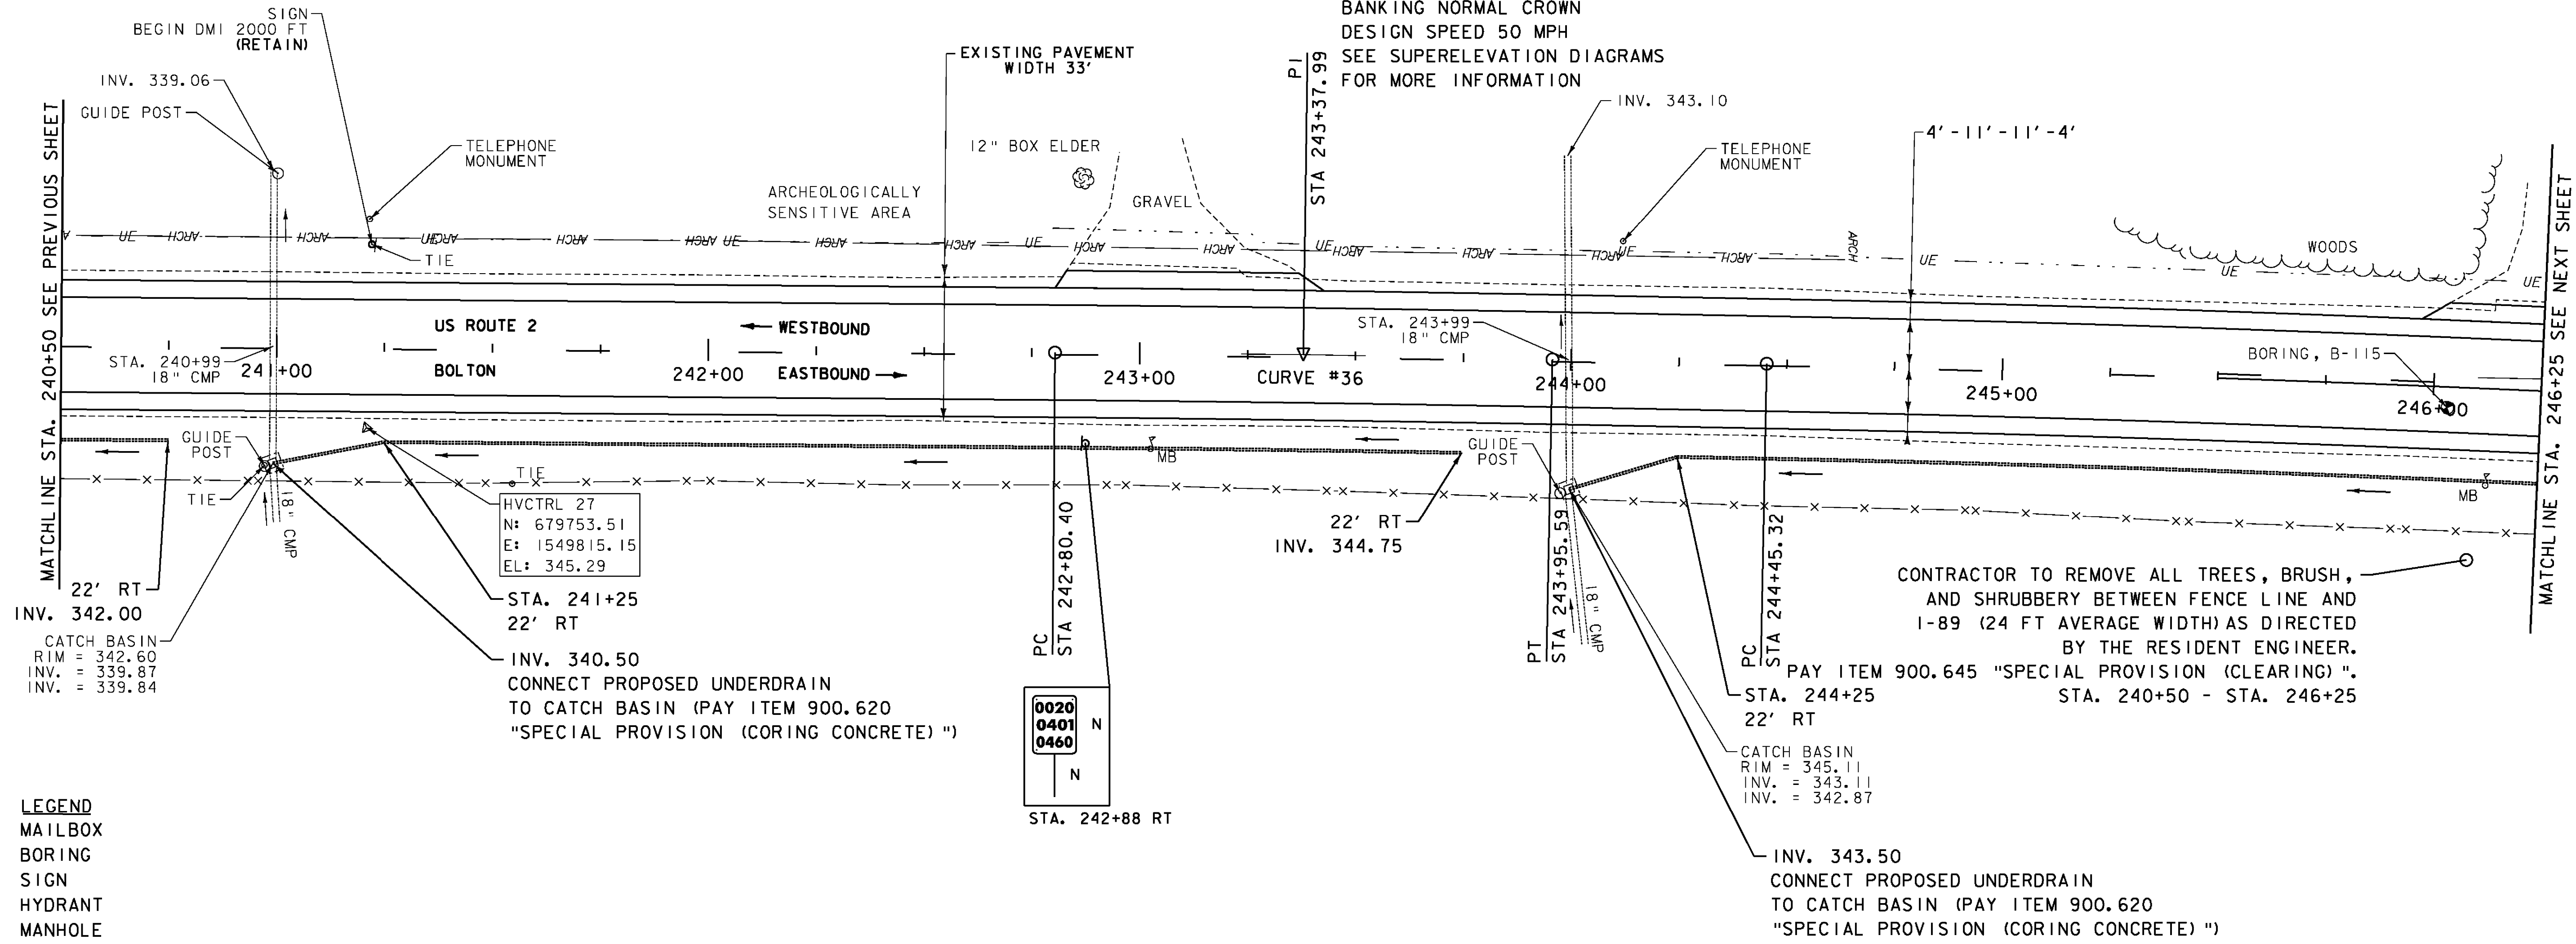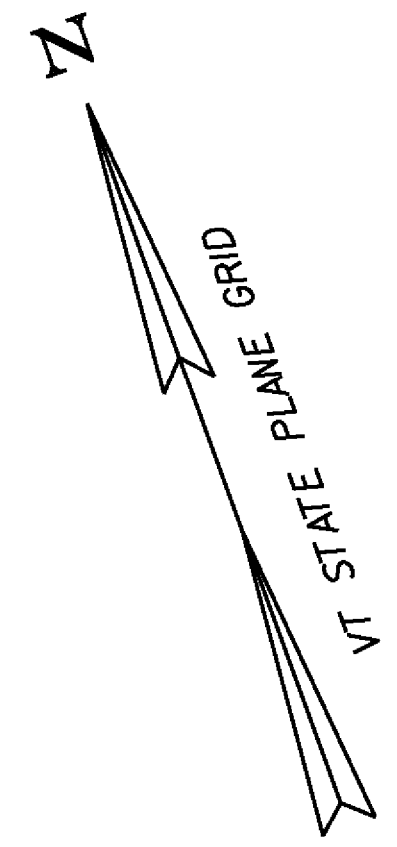

- LEGEND**
- MAILBOX
  - BORING
  - SIGN
  - HYDRANT
  - MANHOLE
  - WATER SHUT OFF (WSO)
  - GAS PIPELINE MARKER
  - CATCH BASIN / DROP INLET
  - CURB INLET
  - ⊗ TRAFFIC CONTROL BOX
  - ⊕ PARKING METER
  - ⊖ UTILITY POLE

- SIGN LEGEND**
- R = REMOVE
  - R&S = REMOVE AND SALVAGE
  - RET = RETAIN
  - S = SALVAGE
  - N = NEW
  - B-B = BACK TO BACK
  - = EXISTING
  - = NEW

**DATUM**  
 VERTICAL NAVD 88  
 HORIZONTAL NAD 83



<b>PROJECT LAYOUT SHEET 26</b>	PROJECT NAME: BOLTON - WATERBURY
	PROJECT NUMBER: STP 2709 (1)
	FILE NAME: p07C172.dgn
	PLOT DATE: 4/16/2013
PROJECT LEADER: CDL	DRAWN BY: JBG/BMB
DESIGNED BY: BMB	CHECKED BY: CDL
PLOT FILE: p07C172_50.i	SHEET 50 OF 217