

DURABLE 4 INCH WHITE LINE (SEE OPTION ITEMS)  
 STA. 252+25 - STA. 258+25 (SOLID LT & RT)

TEMPORARY 4 INCH WHITE LINE, PAINT  
 STA. 252+25 - STA. 258+25 (SOLID LT & RT)



6 INCH UNDERDRAIN PIPE  
 STA. 252+25 - STA. 255+75 LT  
 STA. 255+90 - STA. 258+25 LT

DURABLE 4 INCH YELLOW LINE (SEE OPTION ITEMS)  
 STA. 252+25 - STA. 253+50 (DASHED LT, SOLID RT)  
 STA. 253+50 - STA. 256+50 (SOLID LT & RT)  
 STA. 256+50 - STA. 258+25 (SOLID LT, DASHED RT)

TEMPORARY 4 INCH YELLOW LINE, PAINT  
 STA. 252+25 - STA. 253+50 (DASHED LT, SOLID RT)  
 STA. 253+50 - STA. 256+50 (SOLID LT & RT)  
 STA. 256+50 - STA. 258+25 (SOLID LT, DASHED RT)

SPECIAL PROVISION (CORING CONCRETE)  
 STA. 255+90 LT

REMOVE AND RESET GUARDRAIL (DOUBLE-SIDED)  
 STA. 252+25 - STA. 258+25 RT

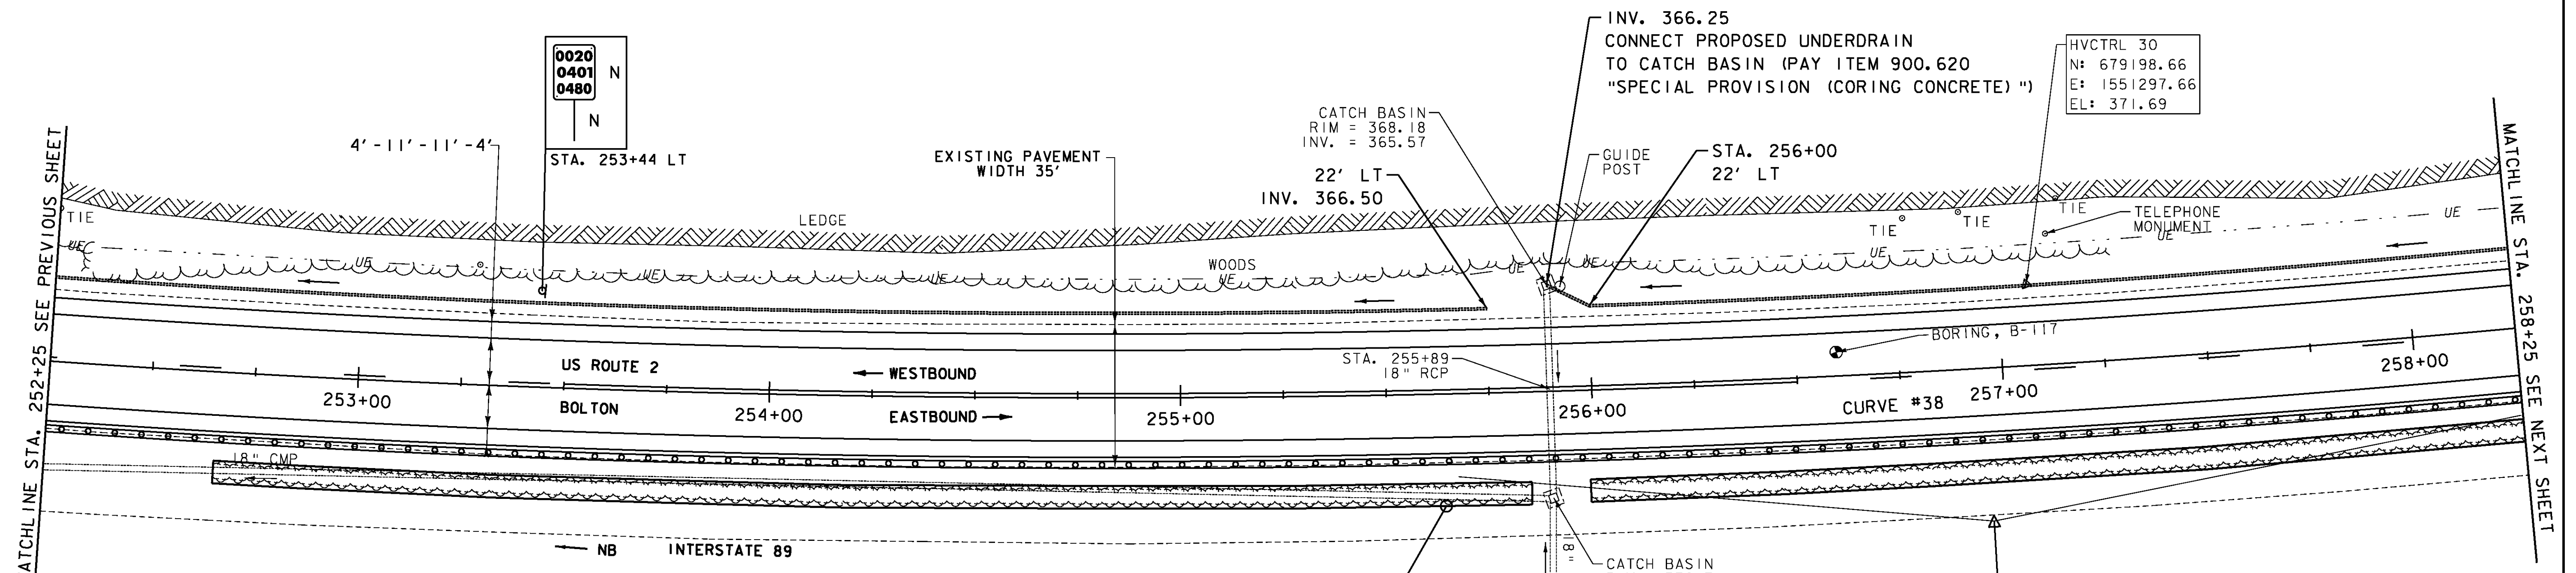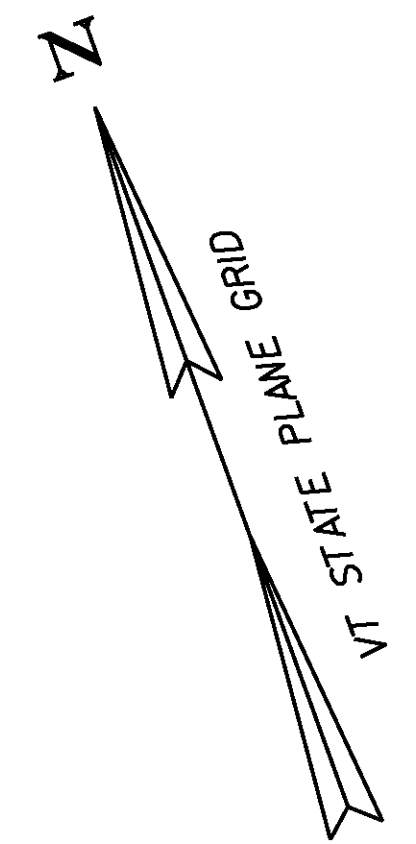


- LEGEND**
- MAILBOX
  - BORING
  - SIGN
  - HYDRANT
  - MANHOLE
  - WATER SHUT OFF (WSO)
  - GAS PIPELINE MARKER
  - CATCH BASIN / DROP INLET
  - CURB INLET
  - TRAFFIC CONTROL BOX
  - PARKING METER
  - UTILITY POLE

- SIGN LEGEND**
- R = REMOVE
  - R&S = REMOVE AND SALVAGE
  - RET = RETAIN
  - S = SALVAGE
  - N = NEW
  - B-B = BACK TO BACK
  - = EXISTING
  - = NEW

CONTRACTOR TO INSTALL TREE PROTECTION FENCE AROUND EXISTING TREE SCREENING PLANTING BEDS OR AS DIRECTED BY THE RESIDENT ENGINEER (TYP.).  
 PAY ITEM 656.85 "TREE PROTECTION"

**CURVE #38**  
 DELTA = 16°05'00"  
 D = 1°32'55"  
 R = 3700.00'  
 T = 522.75'  
 L = 1038.62'  
 E = 36.75'  
 BANKING 0.031 FT/FT  
 DESIGN SPEED 50 MPH  
 SEE SUPERELEVATION DIAGRAMS FOR MORE INFORMATION

**DATUM**  
 VERTICAL NAVD 88  
 HORIZONTAL NAD 83

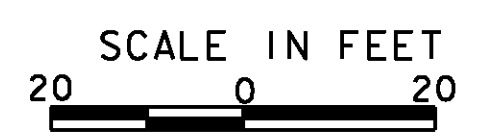

<b>PROJECT LAYOUT SHEET 28</b>	PROJECT NAME: BOLTON - WATERBURY	PLOT DATE: 4/16/2013
	PROJECT NUMBER: STP 2709 (1)	DRAWN BY: JBG/BMB
	FILE NAME: p07C172.dgn	CHECKED BY: CDL
	DESIGNED BY: BMB	SHEET 52 OF 217
	PLOT FILE: p07C172_52.i	