

DURABLE 4 INCH WHITE LINE (SEE OPTION ITEMS)  
 STA. 281+75 - STA. 287+50 (SOLID LT & RT)

TEMPORARY 4 INCH WHITE LINE, PAINT  
 STA. 281+75 - STA. 287+50 (SOLID LT & RT)

6 INCH UNDERDRAIN PIPE  
 STA. 281+75 - STA. 282+25 - LT 282+16 LT  
 STA. 282+42 - STA. 285+00 LT

DURABLE 4 INCH YELLOW LINE (SEE OPTION ITEMS)  
 STA. 281+75 - STA. 287+50 (DASHED LT, SOLID RT)



TEMPORARY 4 INCH YELLOW LINE, PAINT  
 STA. 281+75 - STA. 287+50 (DASHED LT, SOLID RT)

REMOVING SIGNS  
 AS SHOWN - 1

SPECIAL PROVISION (CORING CONCRETE)  
 STA. 282+42 LT

REMOVE AND RESET GUARDRAIL (DOUBLE-SIDED)  
 STA. 281+75 - STA. 287+50 RT

CURVE #42  
 DELTA = 0°19'14"  
 D = 0°34'23"  
 R = 10000.00'  
 T = 27.98'  
 L = 55.96'  
 E = 0.04'  
 BANKING NORMAL CROWN  
 DESIGN SPEED 50 MPH  
 SEE SUPERELEVATION DIAGRAMS  
 FOR MORE INFORMATION

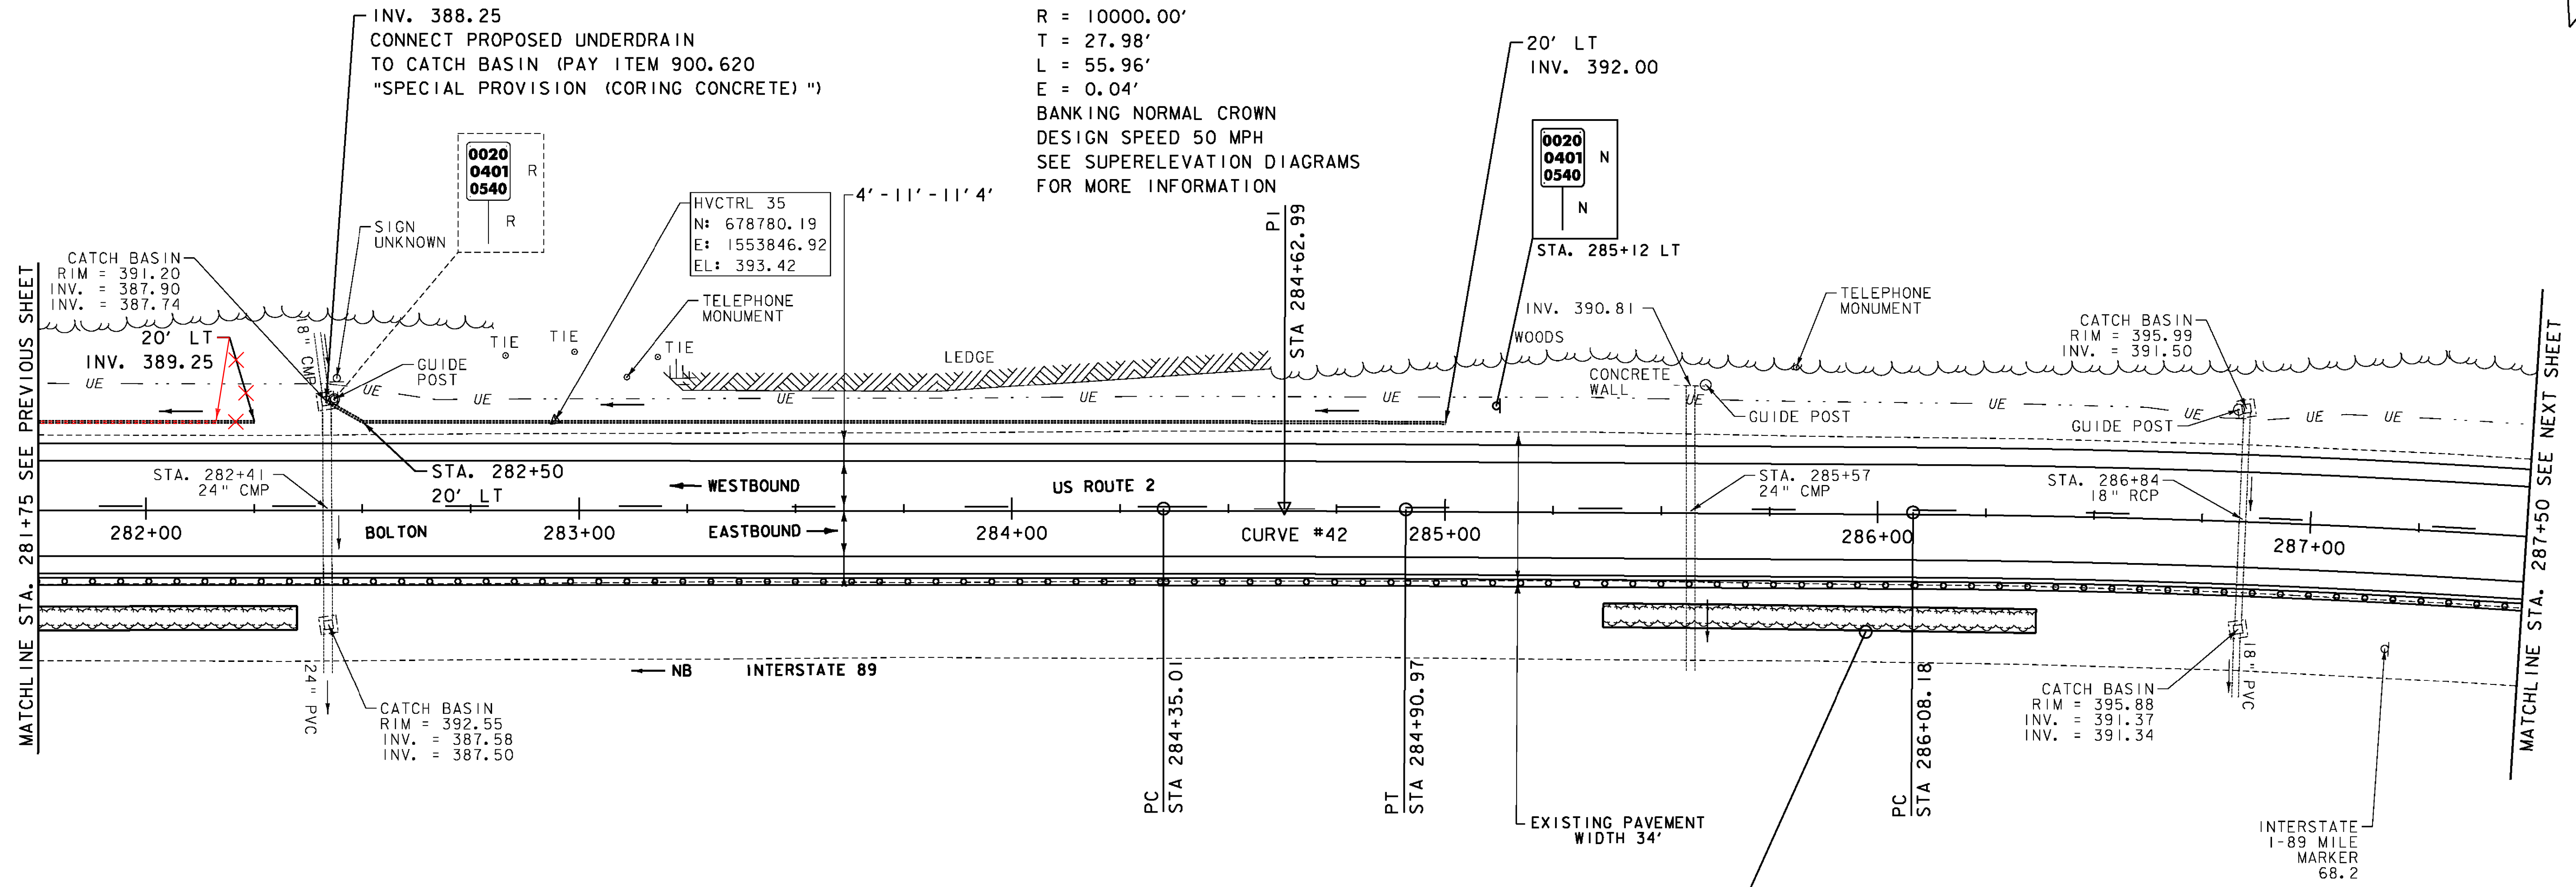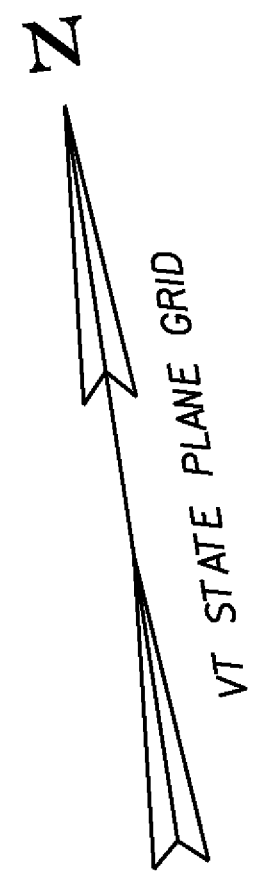

**LEGEND**

- MAILBOX
- BORING
- SIGN
- HYDRANT
- MANHOLE
- WATER SHUT OFF (WSO)
- GAS PIPELINE MARKER
- CATCH BASIN / DROP INLET
- CURB INLET
- TRAFFIC CONTROL BOX
- PARKING METER
- UTILITY POLE

**SIGN LEGEND**

- R = REMOVE
- R&S = REMOVE AND SALVAGE
- RET = RETAIN
- S = SALVAGE
- N = NEW
- B-B = BACK TO BACK
- = EXISTING
- = NEW

DATUM  
 VERTICAL NAVD 88  
 HORIZONTAL NAD 83

CONTRACTOR TO INSTALL TREE PROTECTION FENCE AROUND EXISTING TREE SCREENING PLANTING BEDS OR AS DIRECTED BY THE RESIDENT ENGINEER (TYP.).  
 PAY ITEM 656.85 "TREE PROTECTION"

SCALE IN FEET  
 20 0 20

**PROJECT LAYOUT SHEET 33**

PROJECT NAME: BOLTON - WATERBURY  
 PROJECT NUMBER: STP 2709 (1)

FILE NAME: p07C172.dgn PLOT DATE: 4/16/2013  
 PROJECT LEADER: CDL DRAWN BY: JBG/BMB  
 DESIGNED BY: BMB CHECKED BY: CDL  
 PLOT FILE: p07C172.57.i SHEET 57 OF 217